


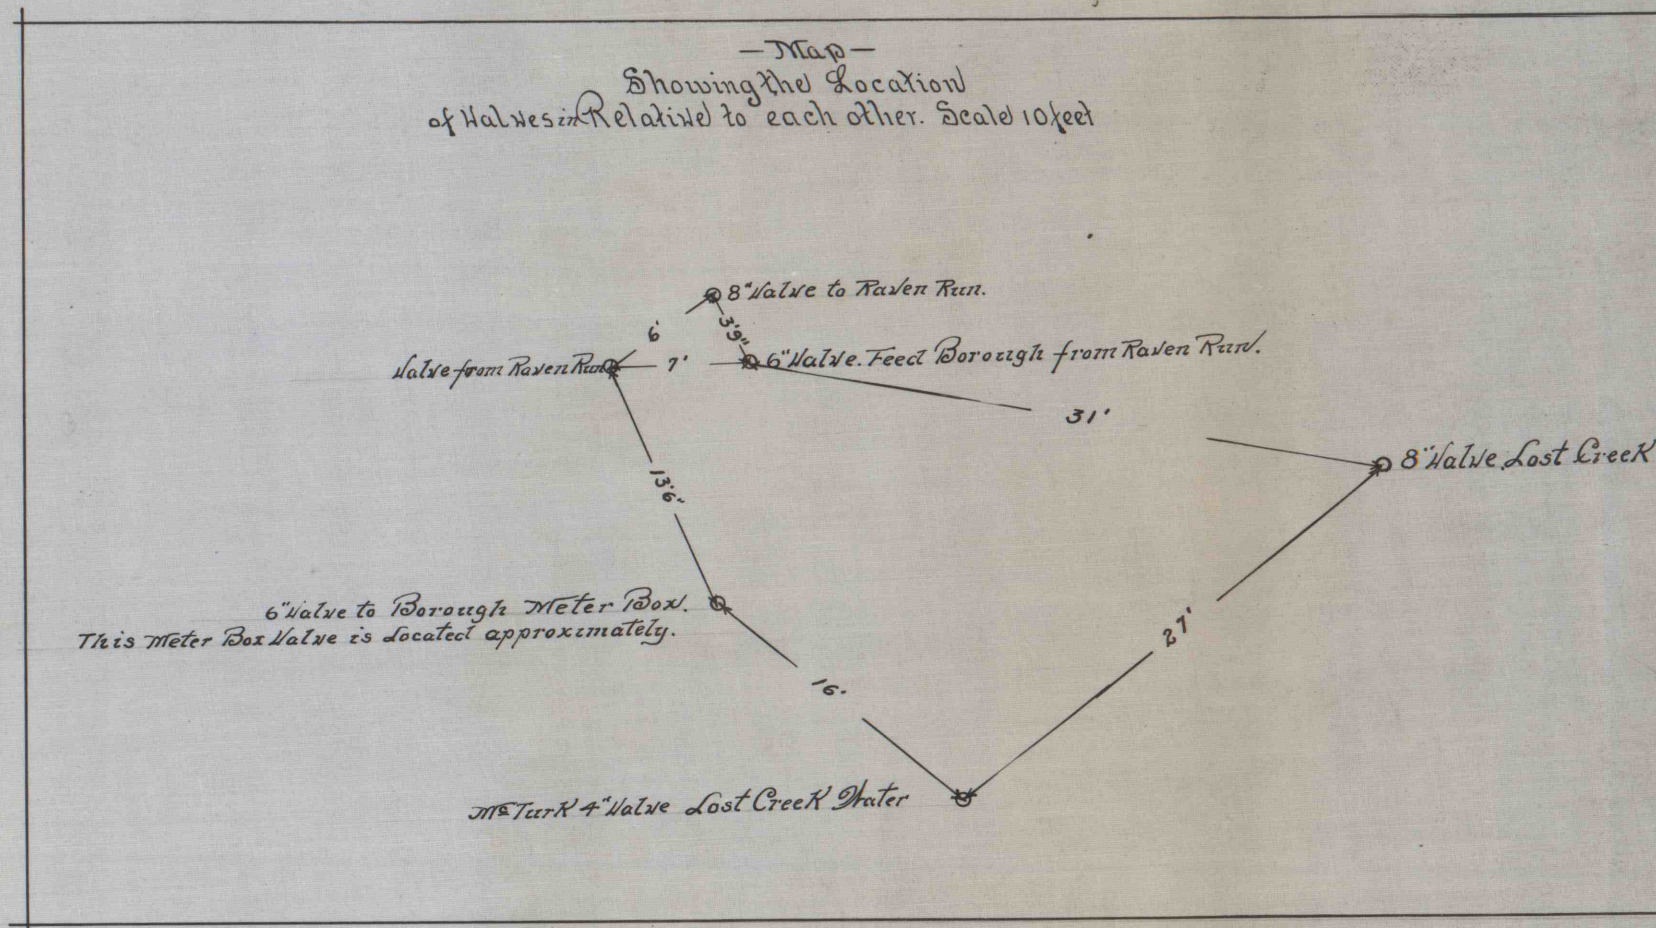

Map showing location of six inch water main in relation to south curb
on Mahanoy Avenue Girardville Borough.

November 6-1913.

Scale 50 feet

James McMichael Sr. Engineer
Pottsville, Pa.