


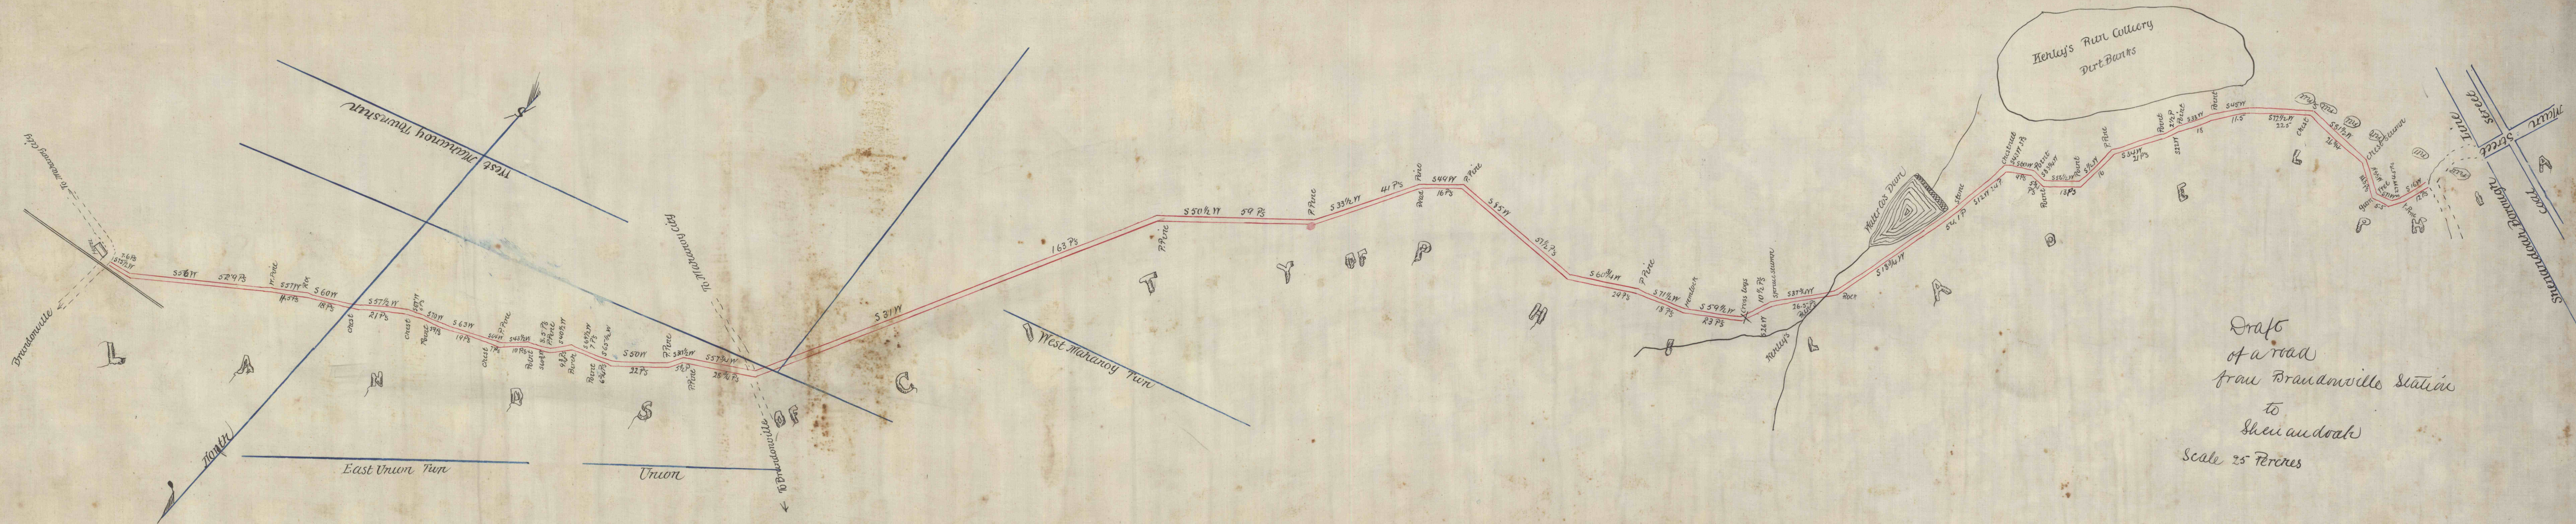

Draft
of a road
from Brandonville Station
to
Shenandoah
