
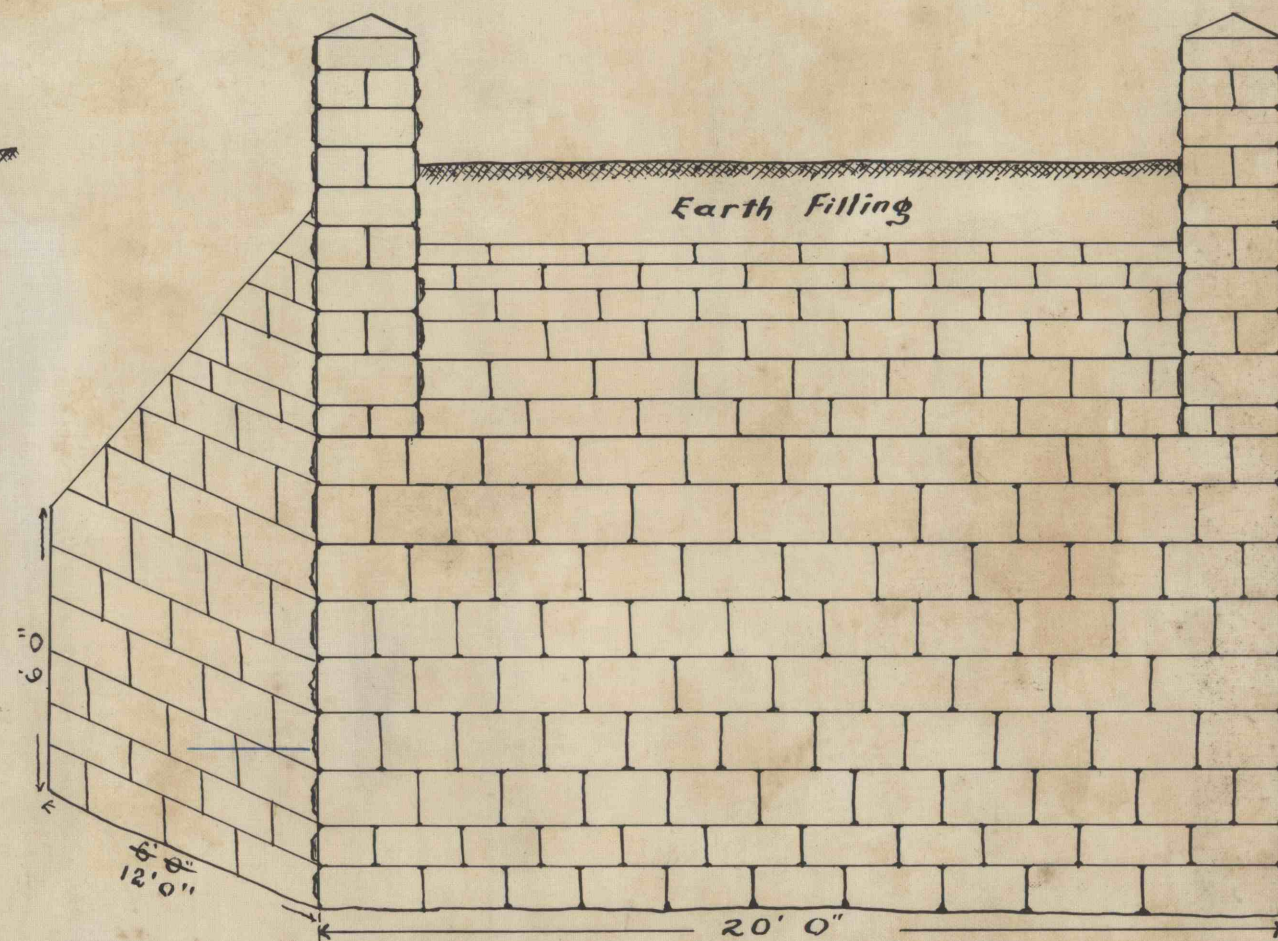


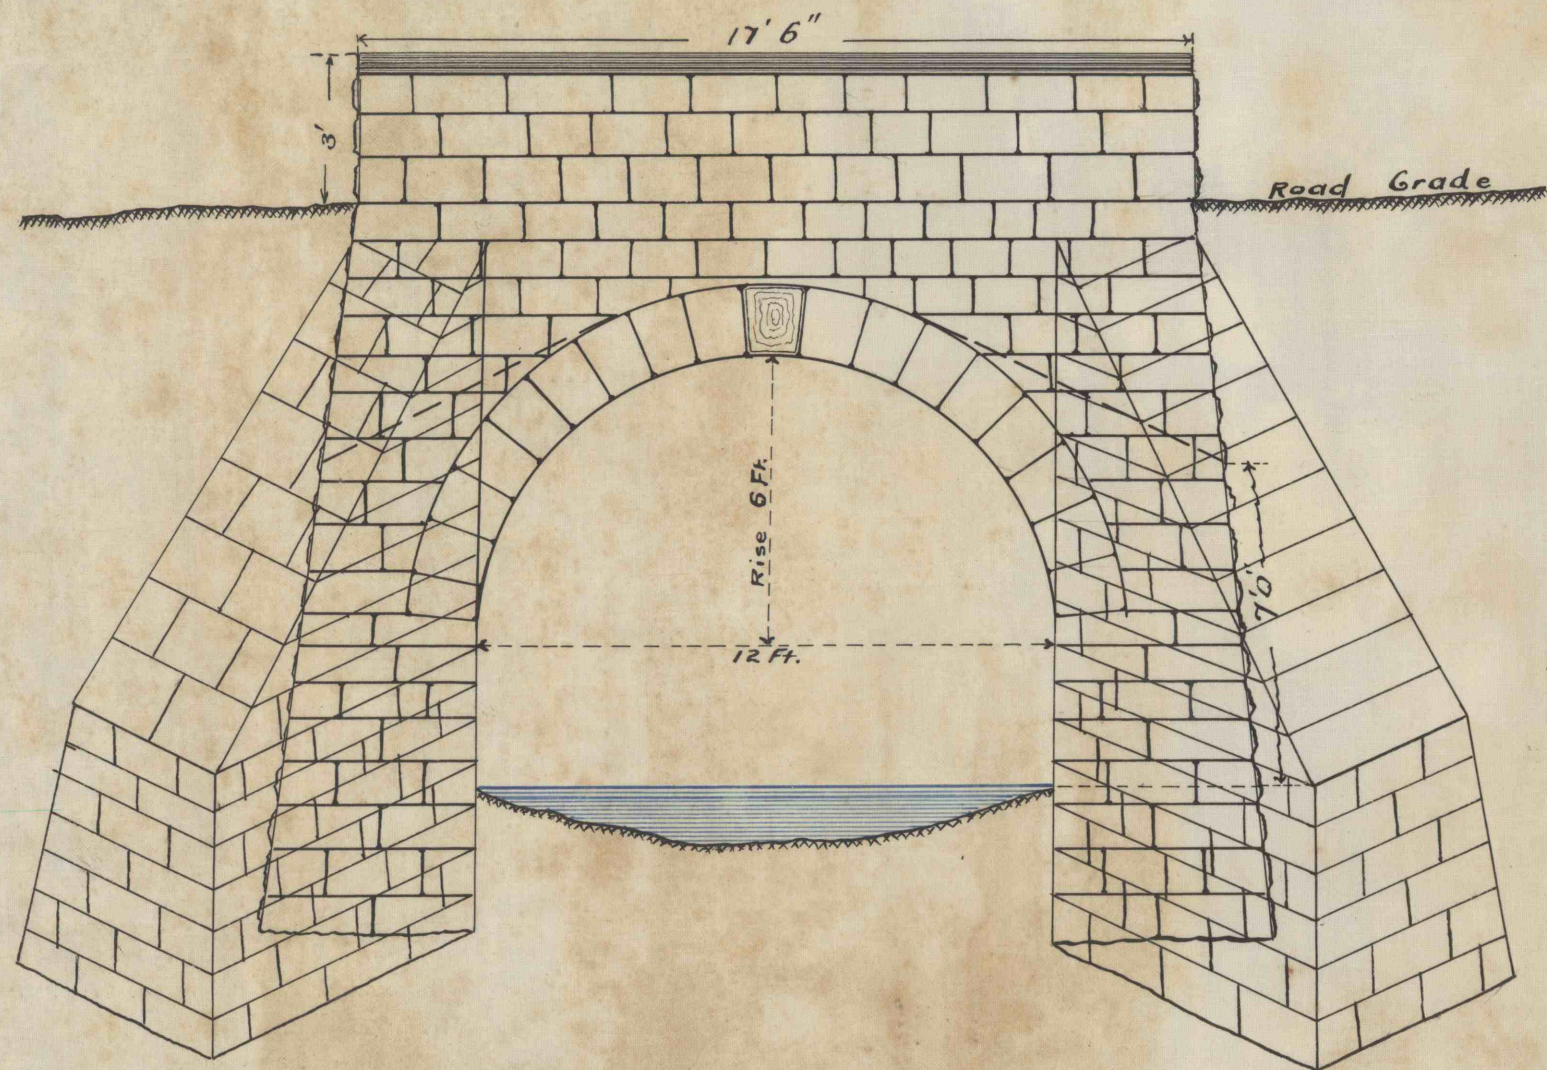

Front and Side Elevations of Proposed Stone Arched Bridge over Lost Creek,
on the Public Road between Lost Creek and Shenandoah, east of Packer No. 2 Breaker,
Scale 1"=4' Pottsville Sept, 11, 1902. Heber S. Thompson.
Engineer.

~ Wing walls added to original drawing ~