
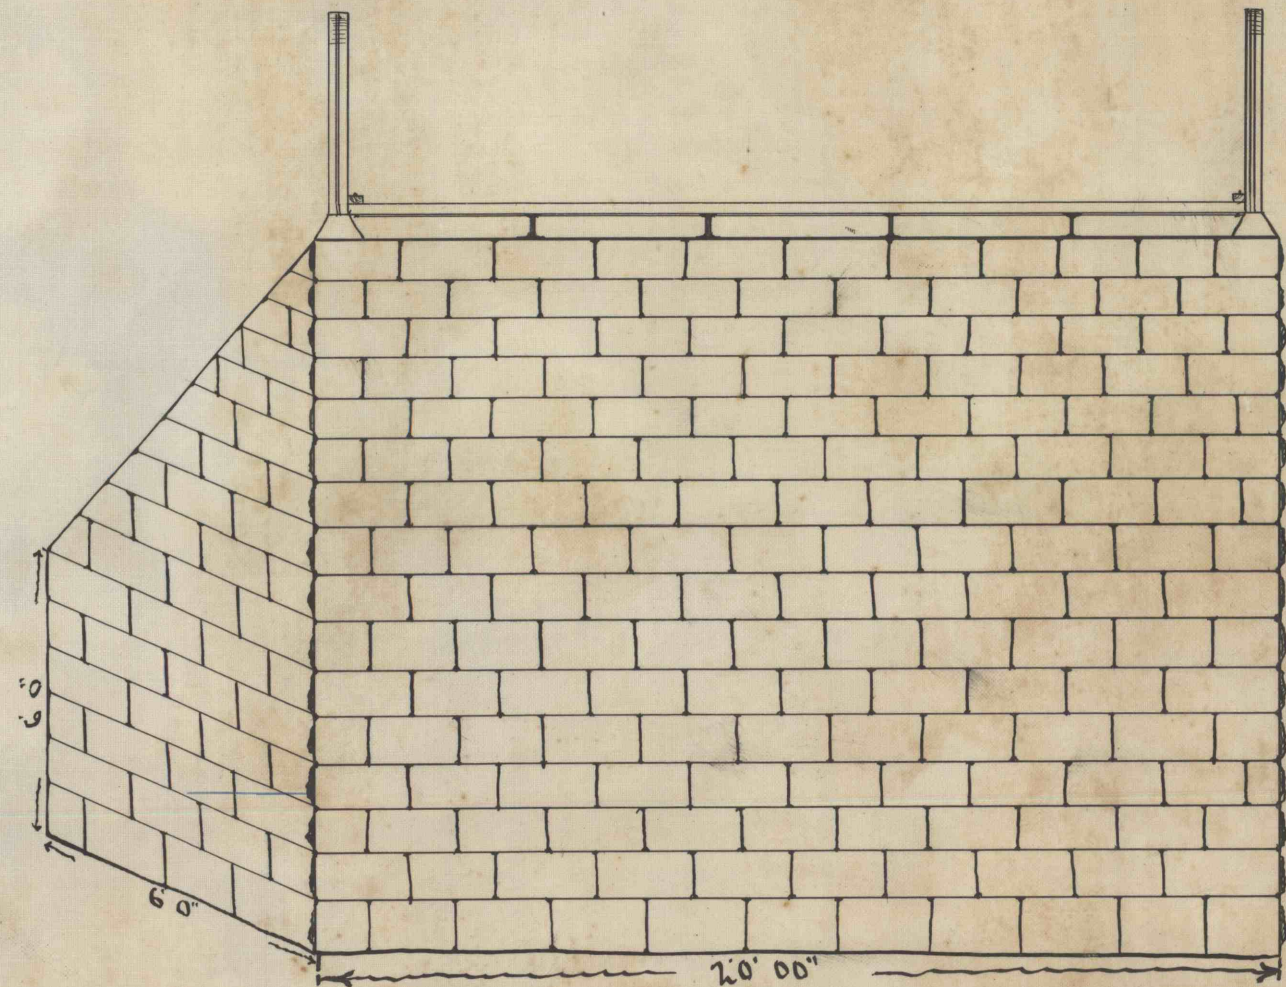


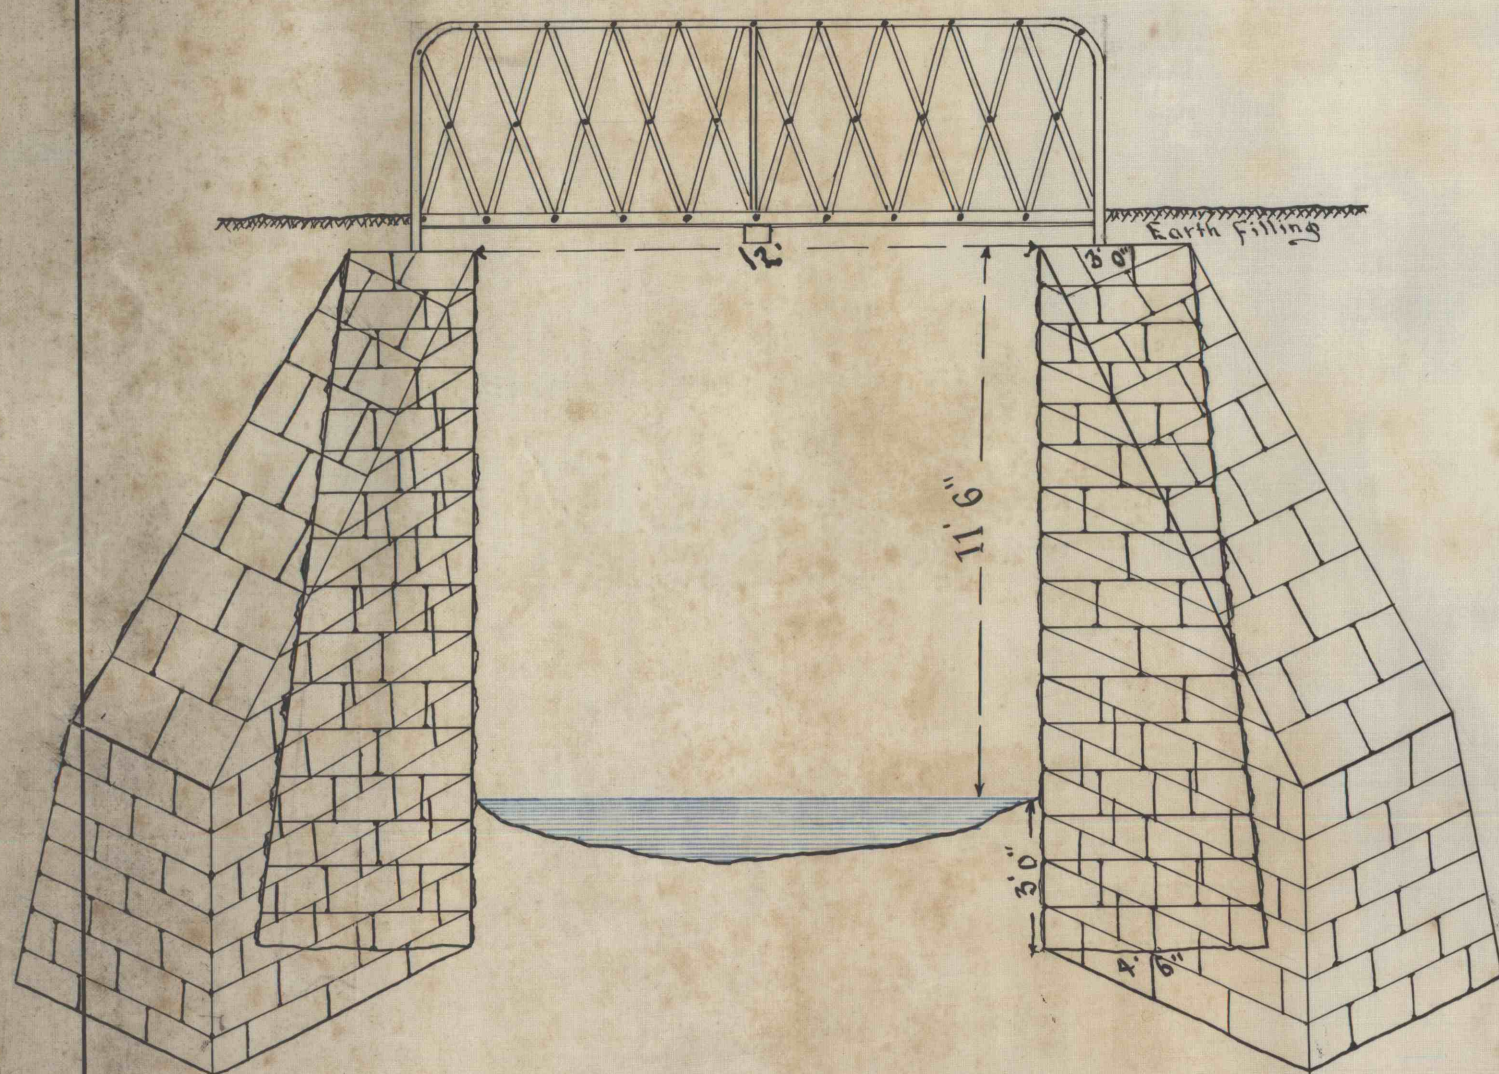

Front and Side Elevations of proposed Stone Abutments to carry Iron Bridge over Last Creek
on the Public Road between Last Creek and Shenandoah just east of Packer No. 2 Breaker,
Scale 1"=4' — Fottsville, Sept. 11, 1902 — Heber S. Thompson,
Engineer.

~ Wing walls added to original drawing ~