

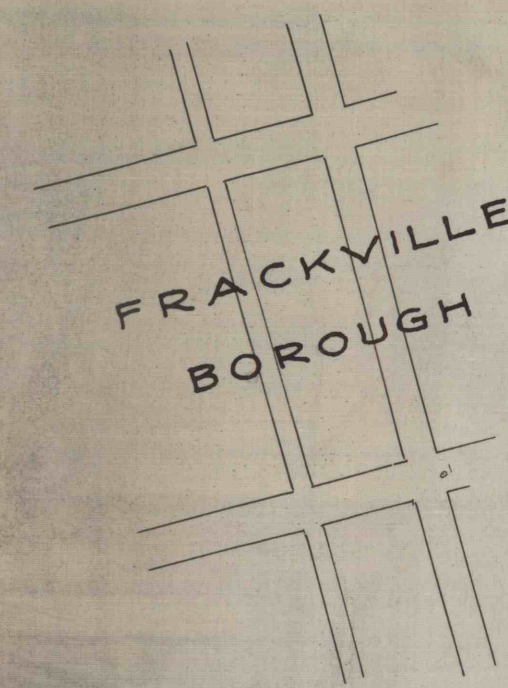


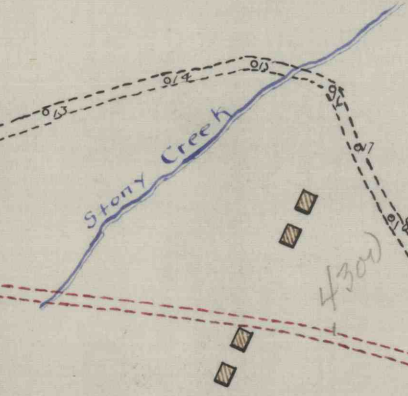

TO FRACKVILLE

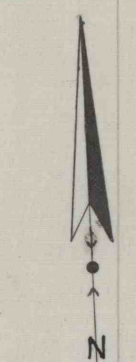

Stony Creek

PUBLIC ROAD
FRACKVILLE TO MOREA
Proposed changes

Scale 1"=300'

Pottsville, Pa.
Sept. 1920.

James Archbald,
Mining Engineer & Agent
Girard Estate.

TO MOREA
WEST MAHANOY TOWNSHIP
MAHANOY TOWNSHIP