


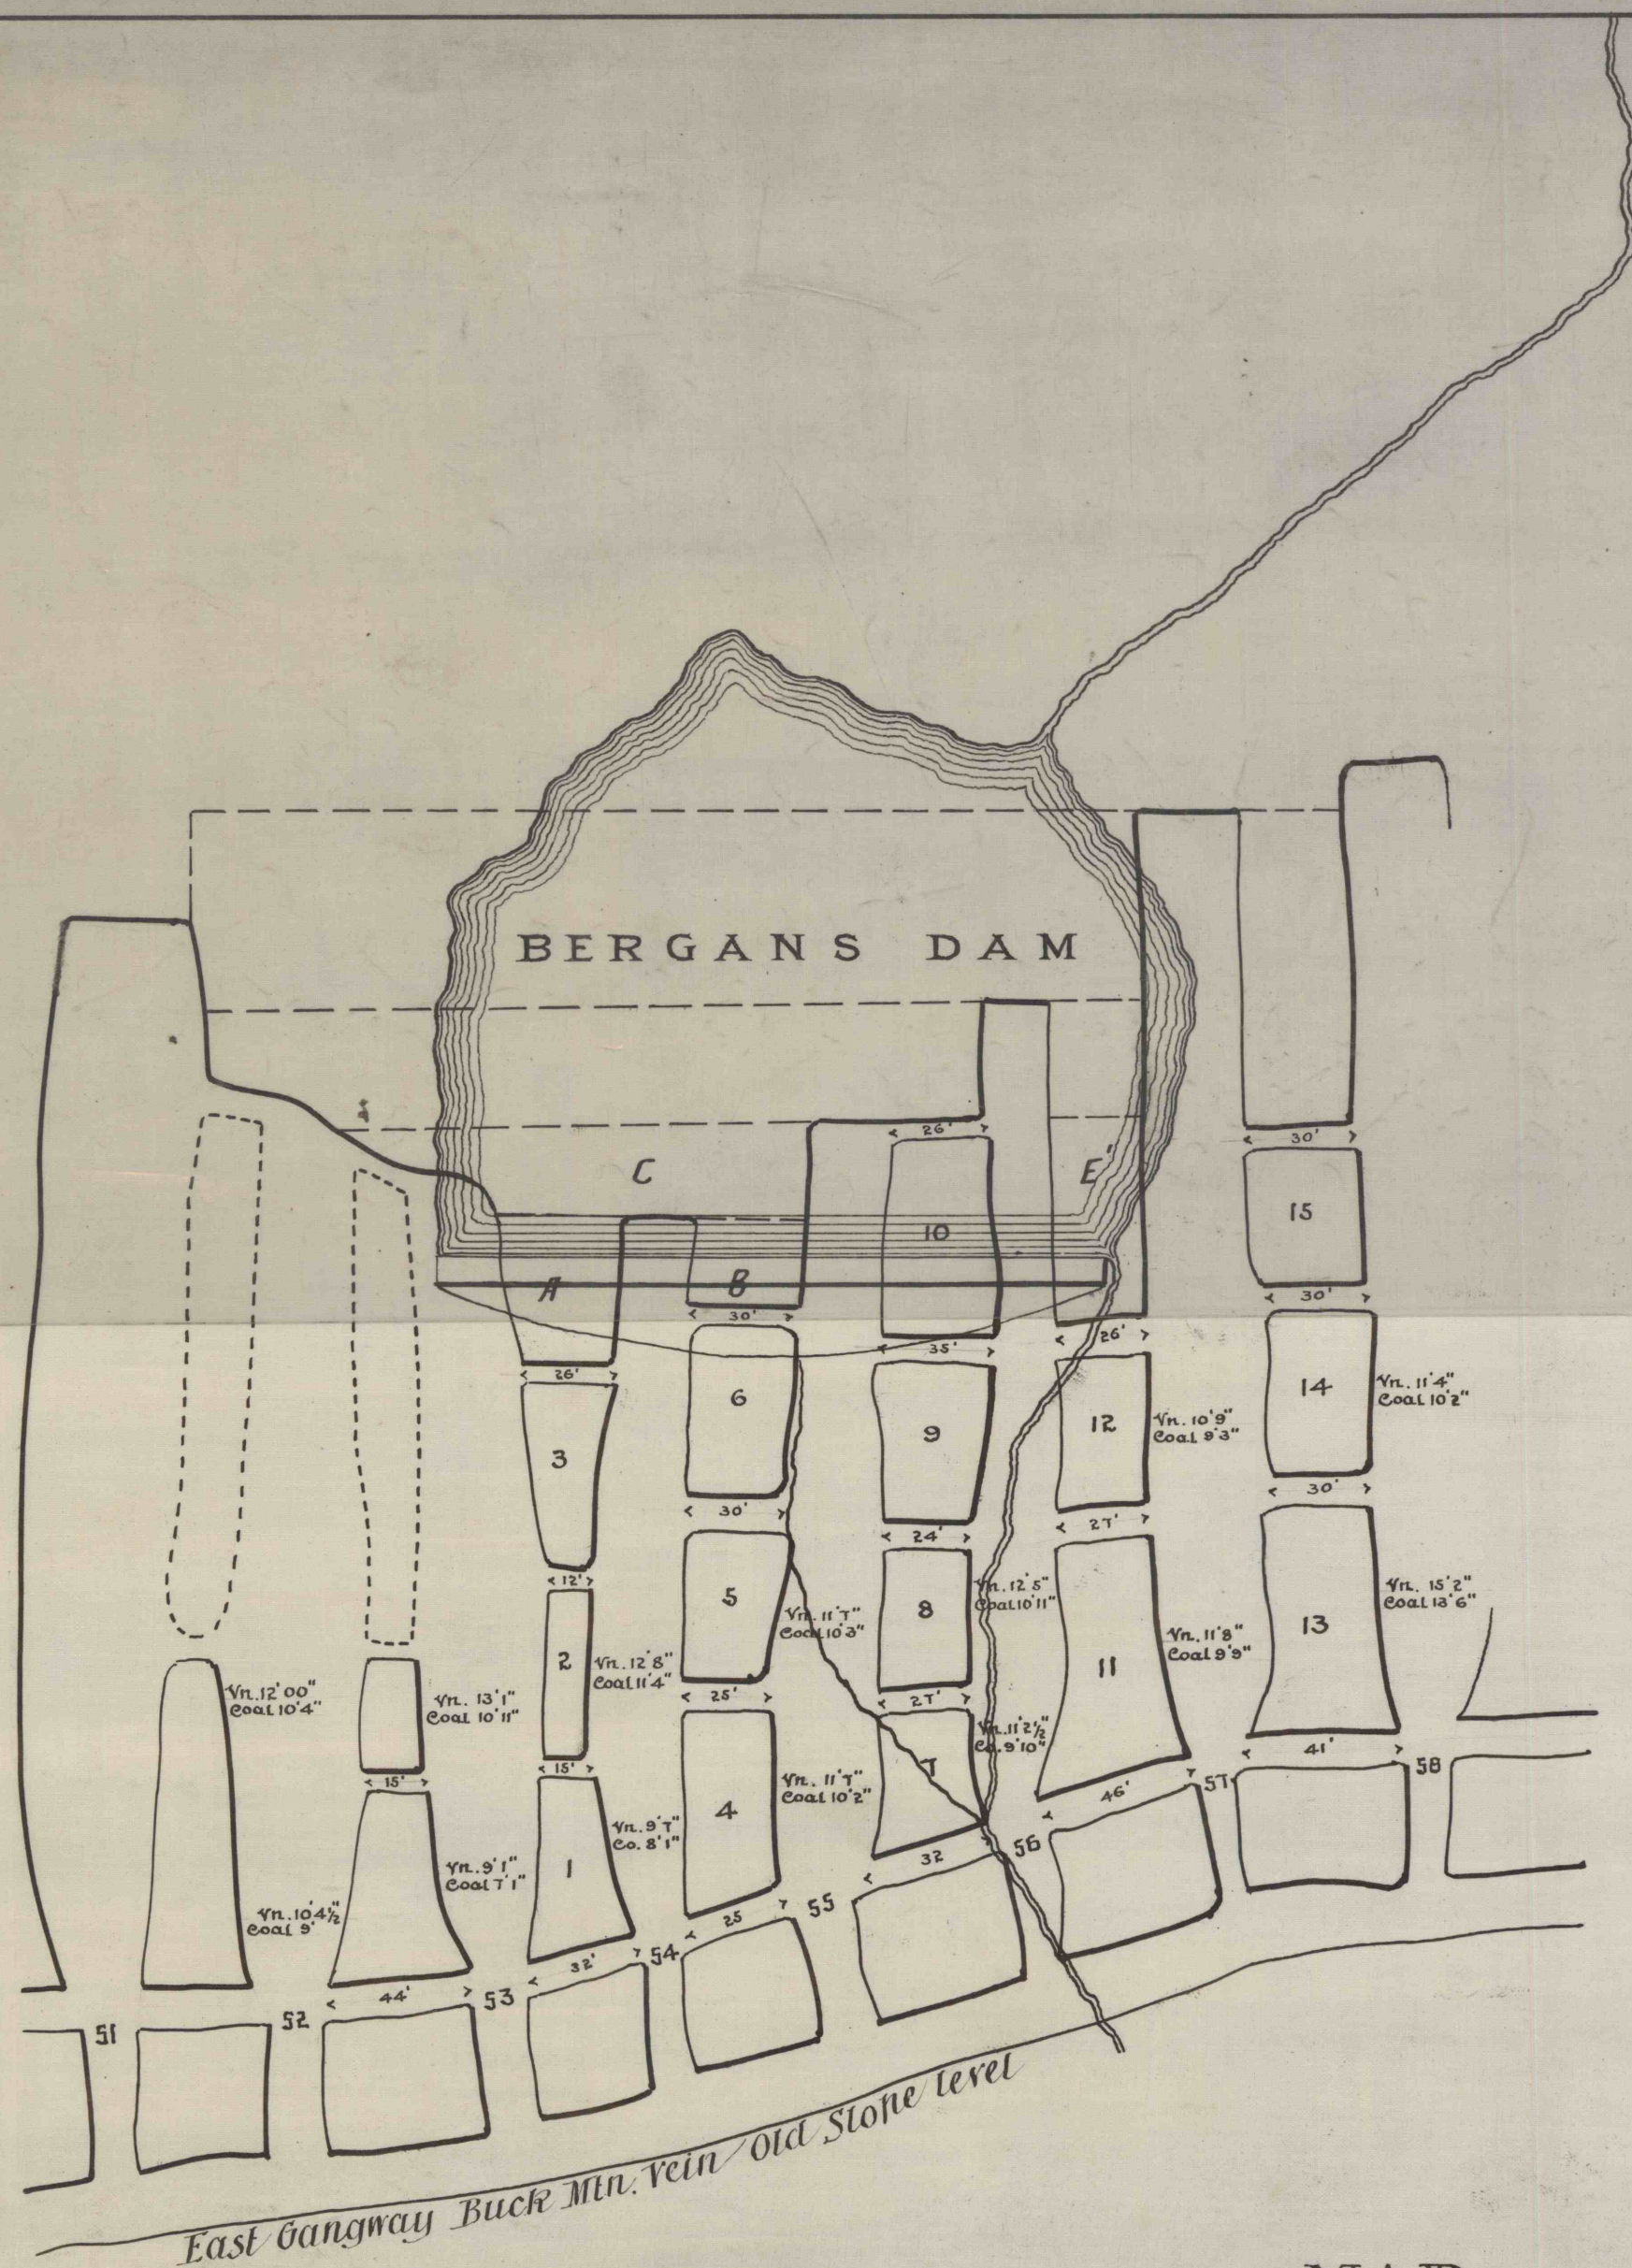

MAP
 SHOWING
PILLARS & KEHLEY'S RUN COLLIERY
 In Buck Mountain Vein Old Stone level East Gangway under Bergans Dam
 in a plane parallel to the dip of the Bed

Scale 1"=50' — Pottsville Pa. Nov. 7th. 1899 — Heber S. Thompson
 James Archbald Jr.
 ENGINEERS