


# KEHLEY'S RUN COLLIERY

PROFILE of present hoisting Slope in Mammoth Bed.

Scale 1 inch = 50 feet . Pottsville, Pa., July 3d. 1906.

James Archbald Jr., ENGINEER.

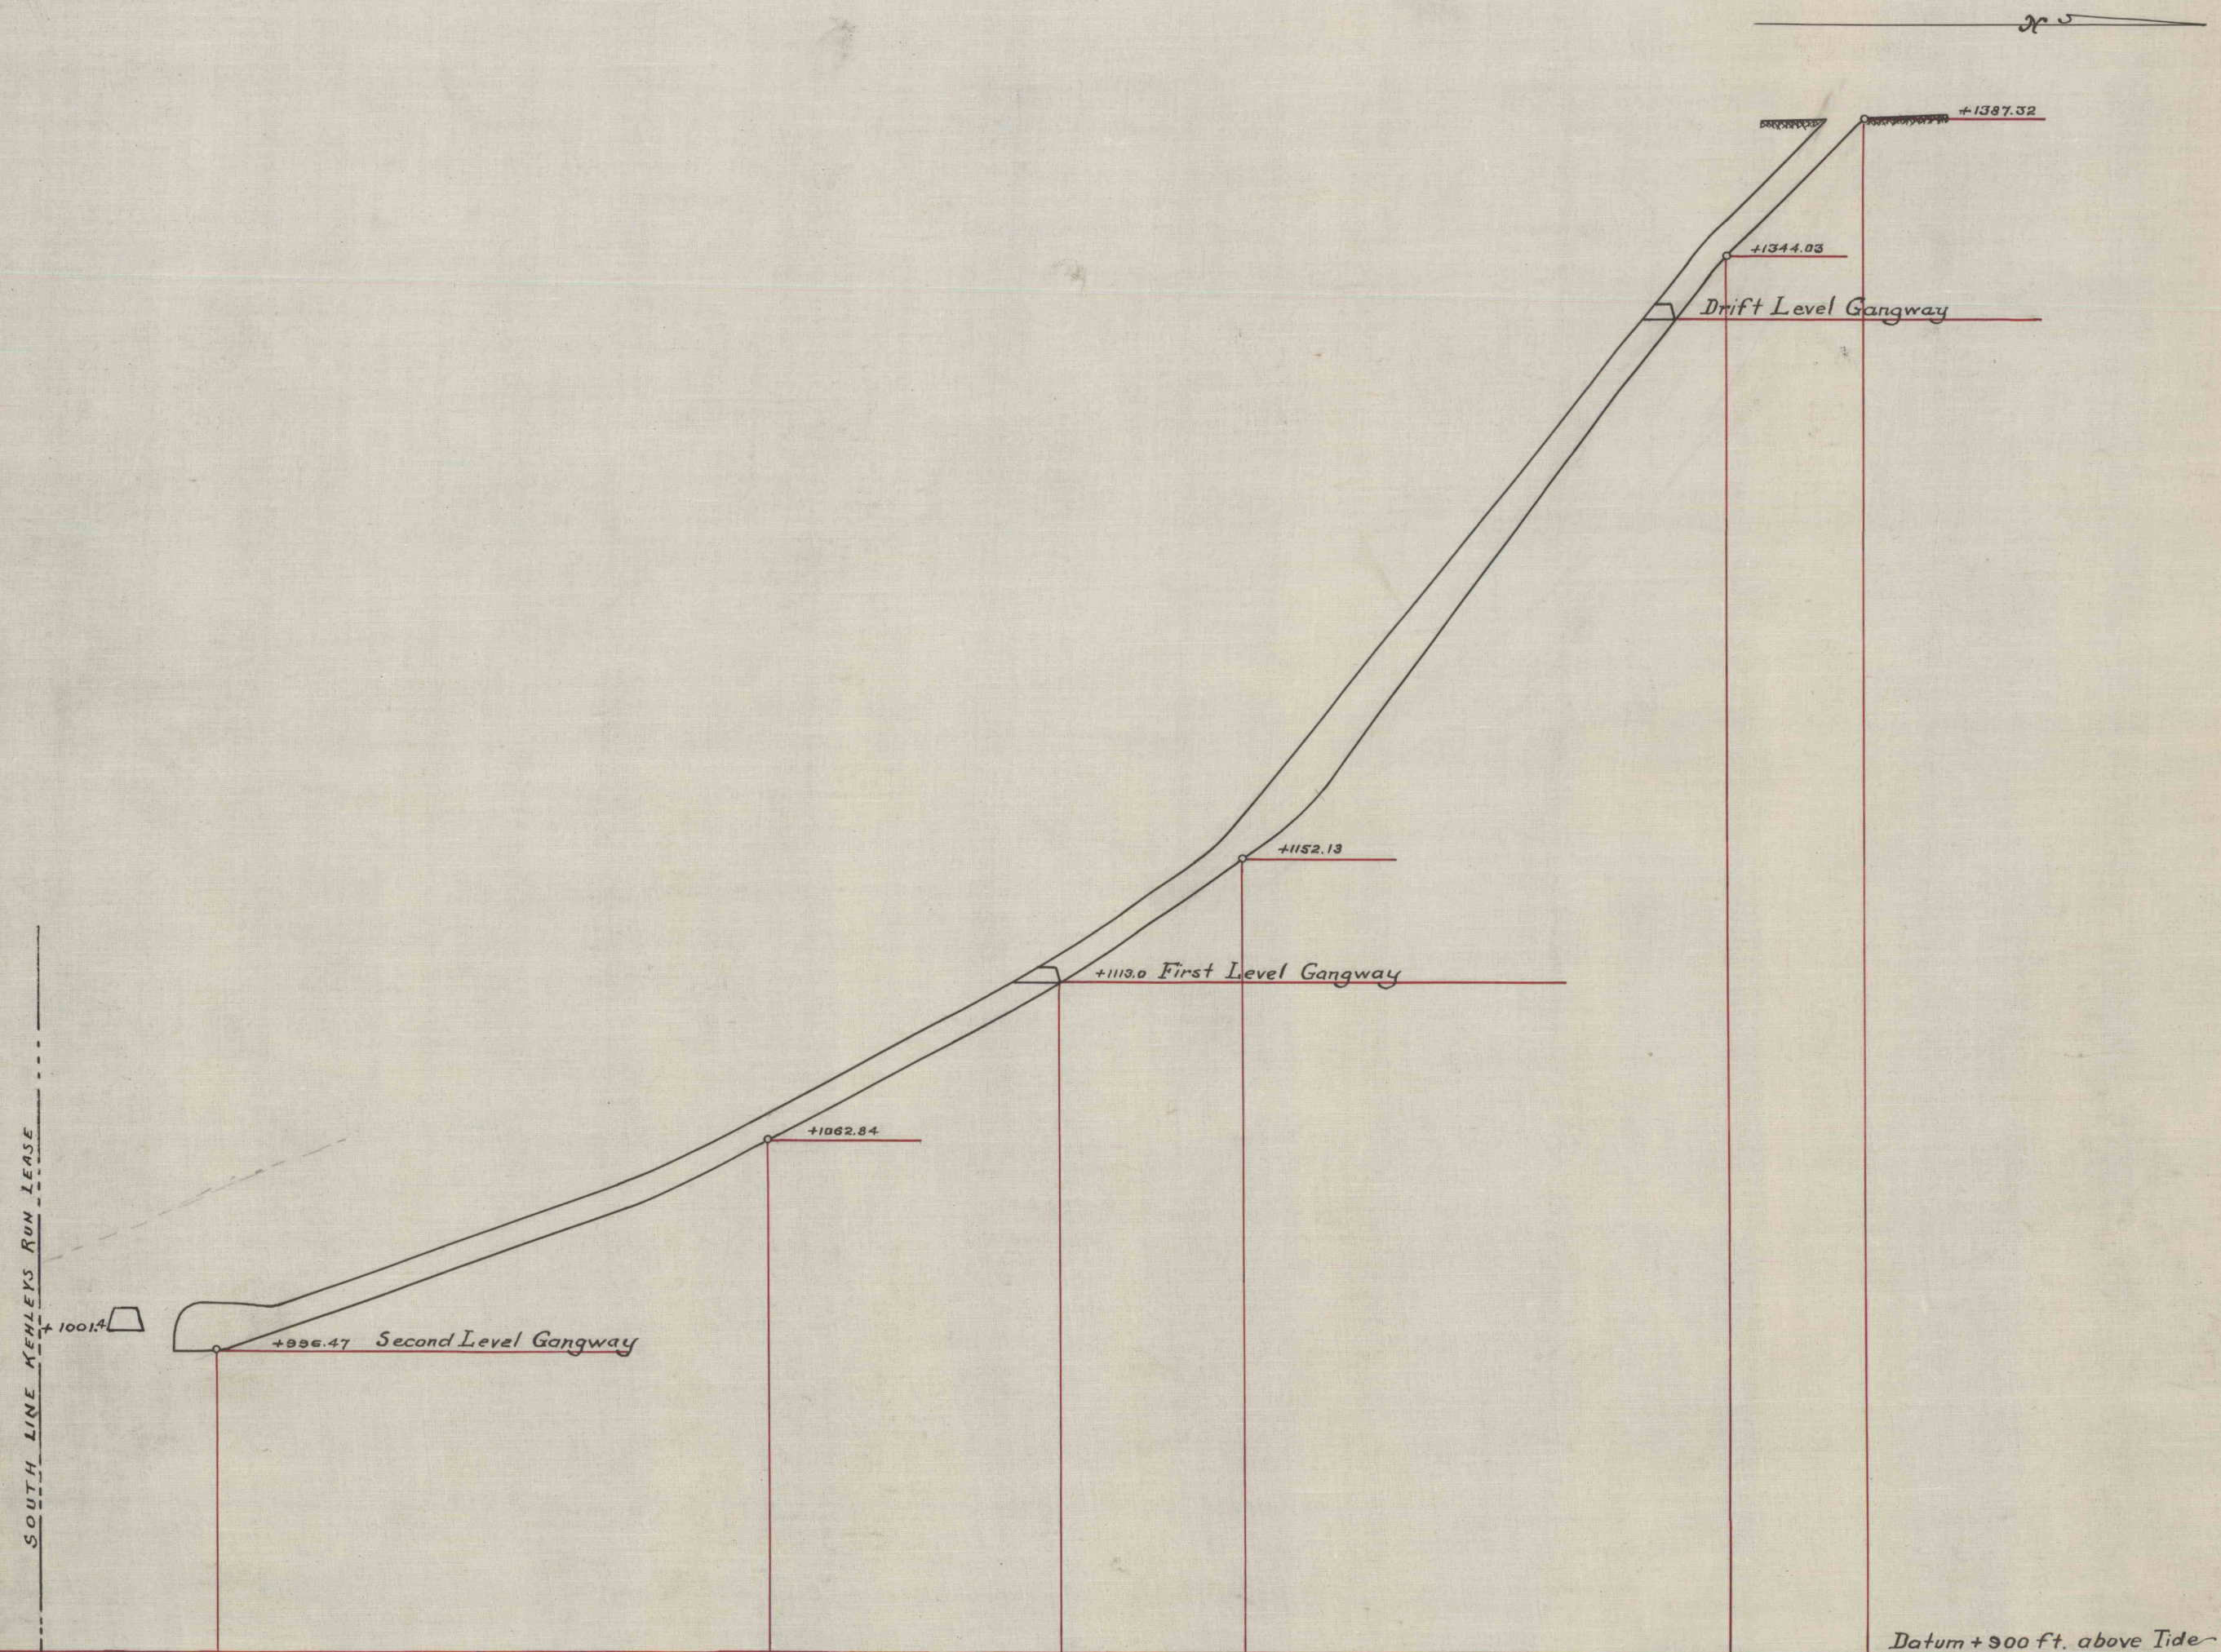

and since  
thickness of vein  
anything additional