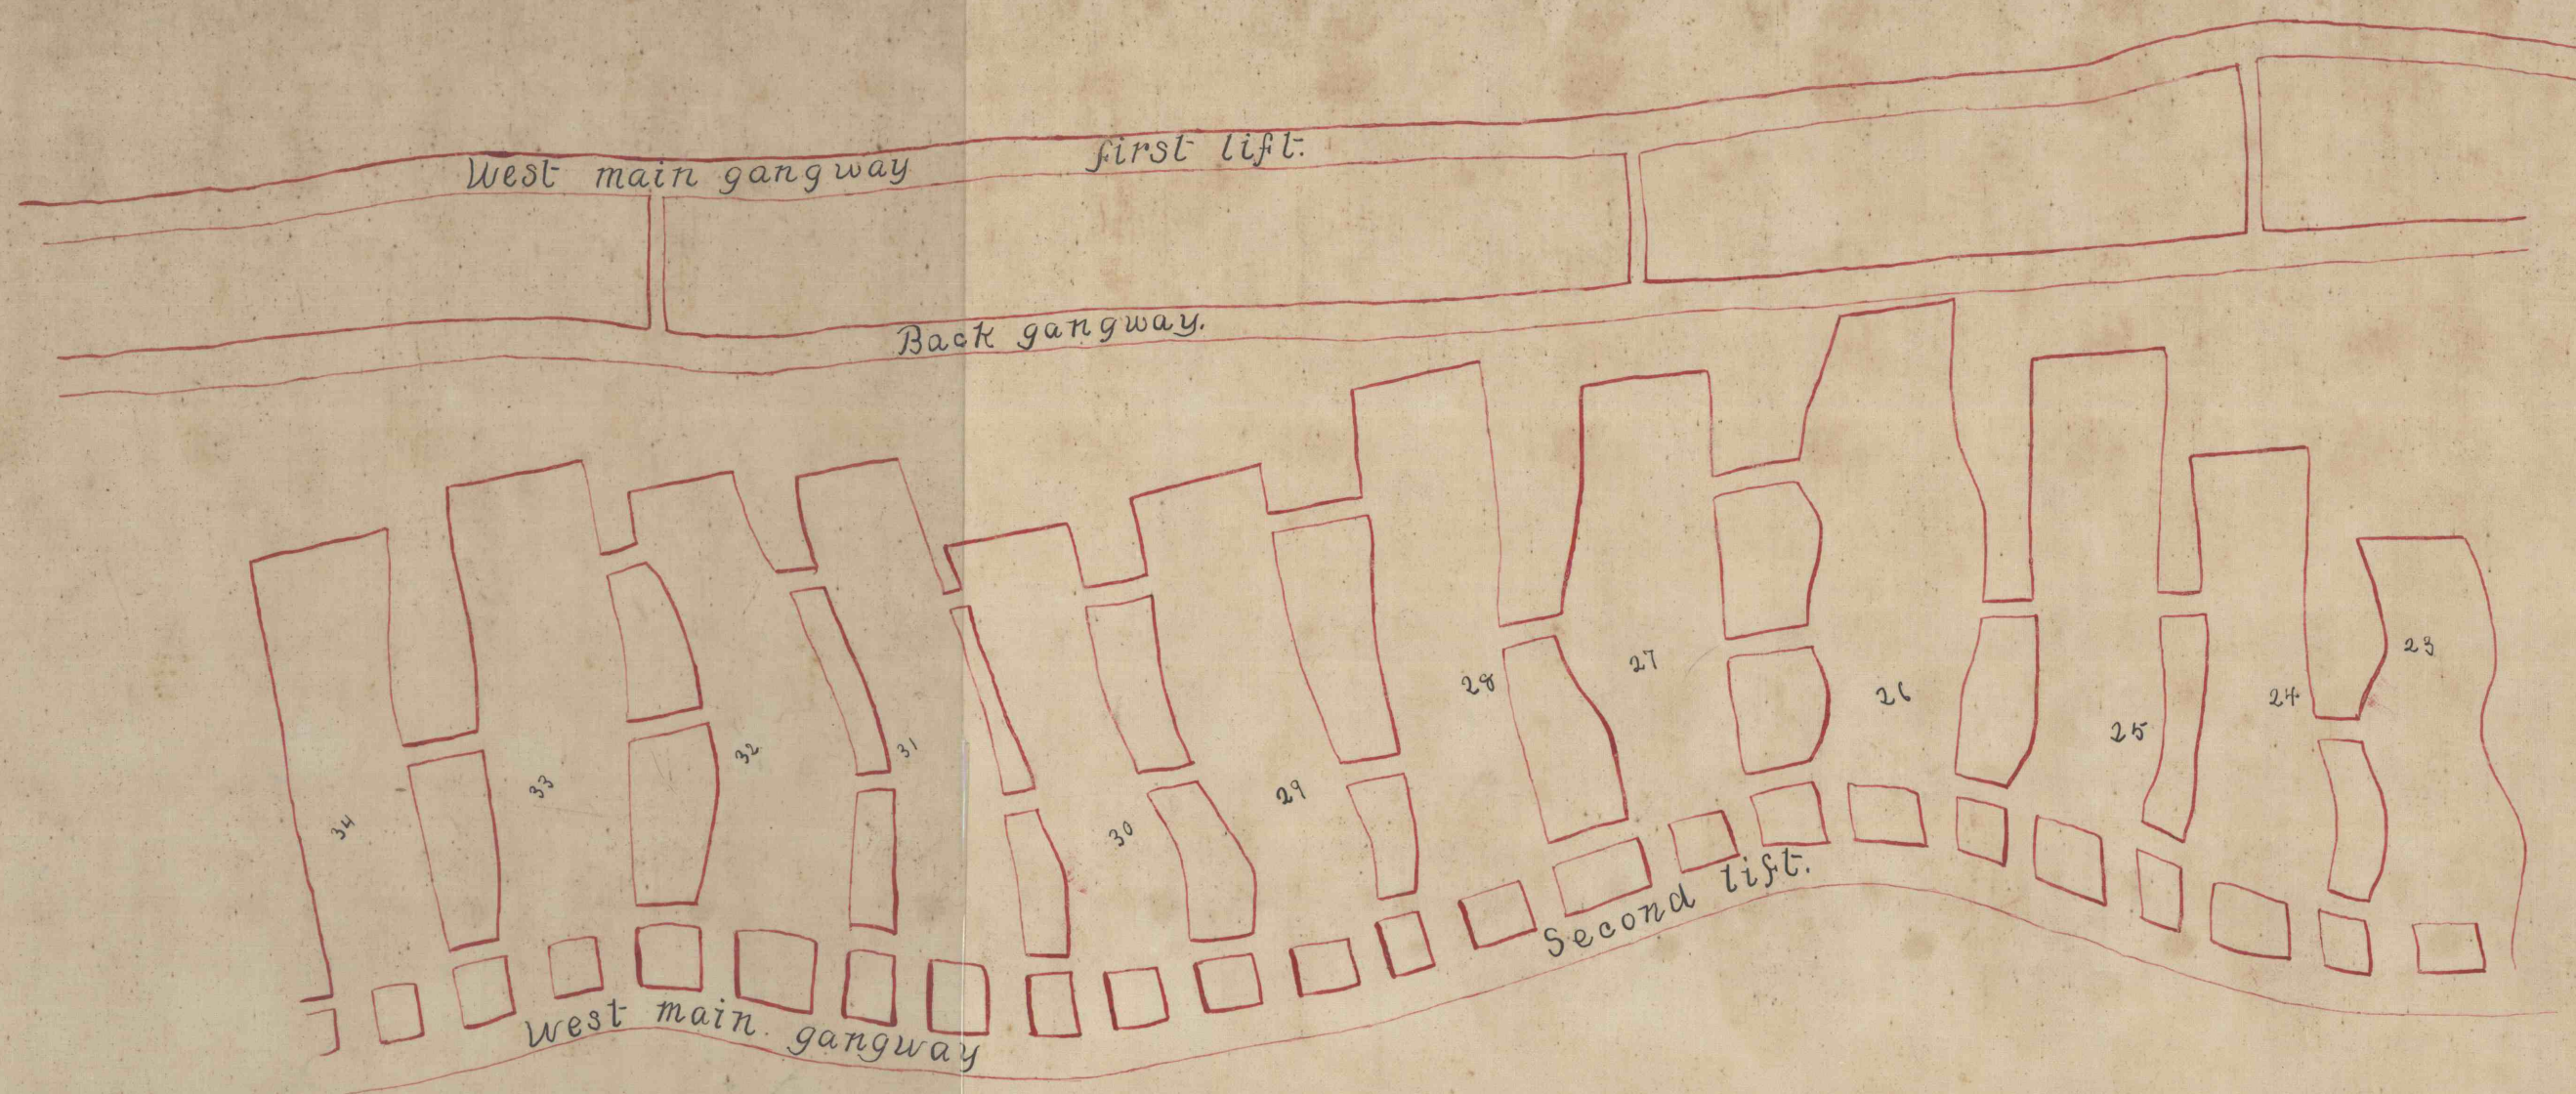


SECTIONS
showing
THICKNESS OF CHAIN PILLAR
WEST OF THE RINGTOWN SLOPE
KEHLEY'S RUN COLLIERY.
Scale 50 feet
Apr. 27th 1881.
Heber D. Thompson
Engineer.