


KEHLEY'S RUN COLLIERY.


Plan, and Section thru No. 7 Rock Hole East Skidmore 2nd Level.

Pottsville, Pa.
June. 5th. 1916

James Archbald,
Mining Engineer & Agent Girard Estate.

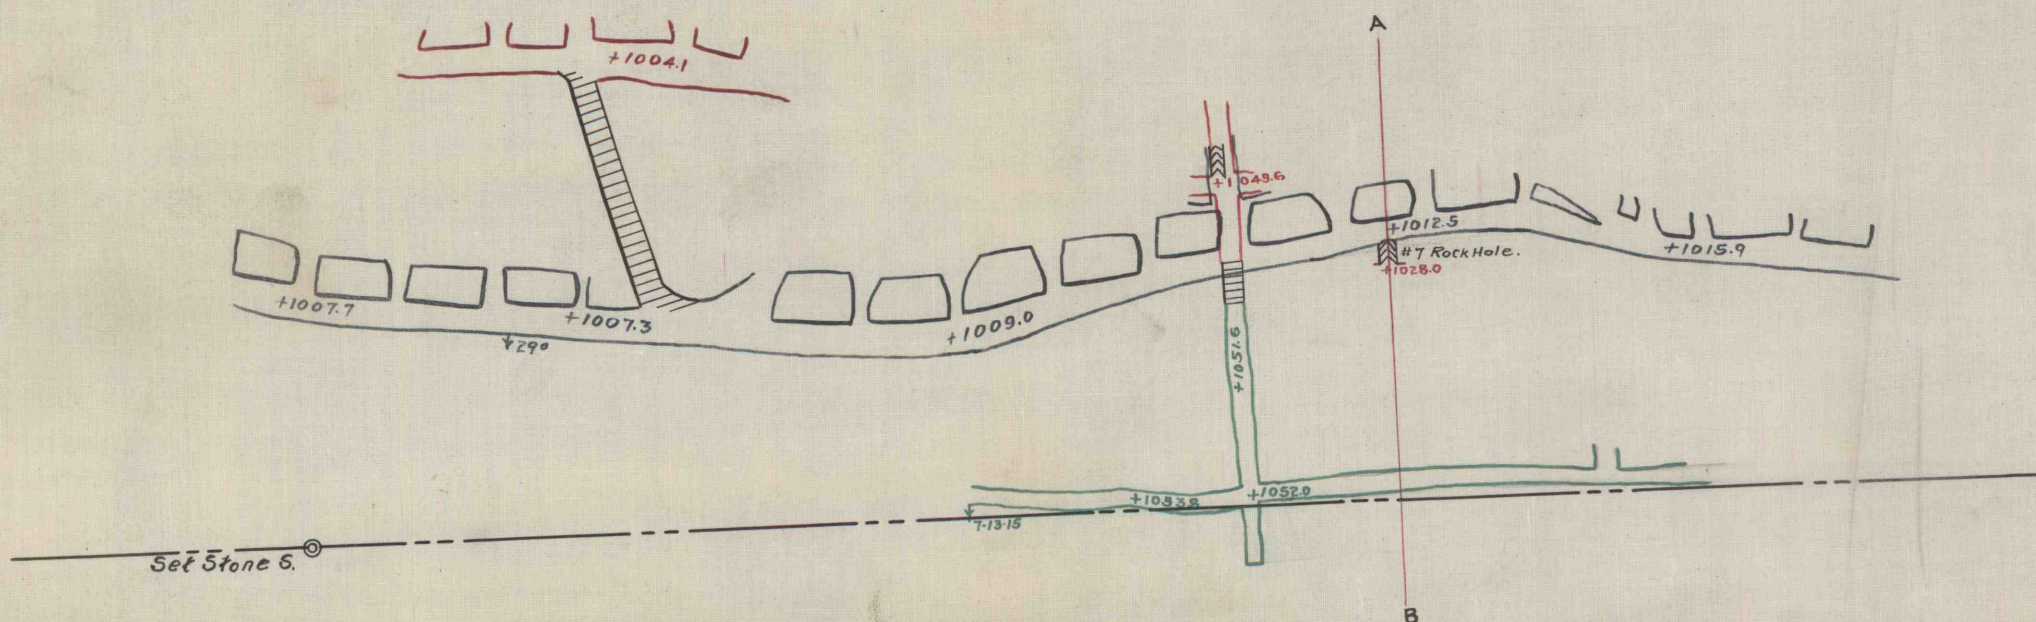

Plan of No. 7 Rock Hole, East Skidmore, 2nd Level. — Scale 1 inch = 100 Feet.

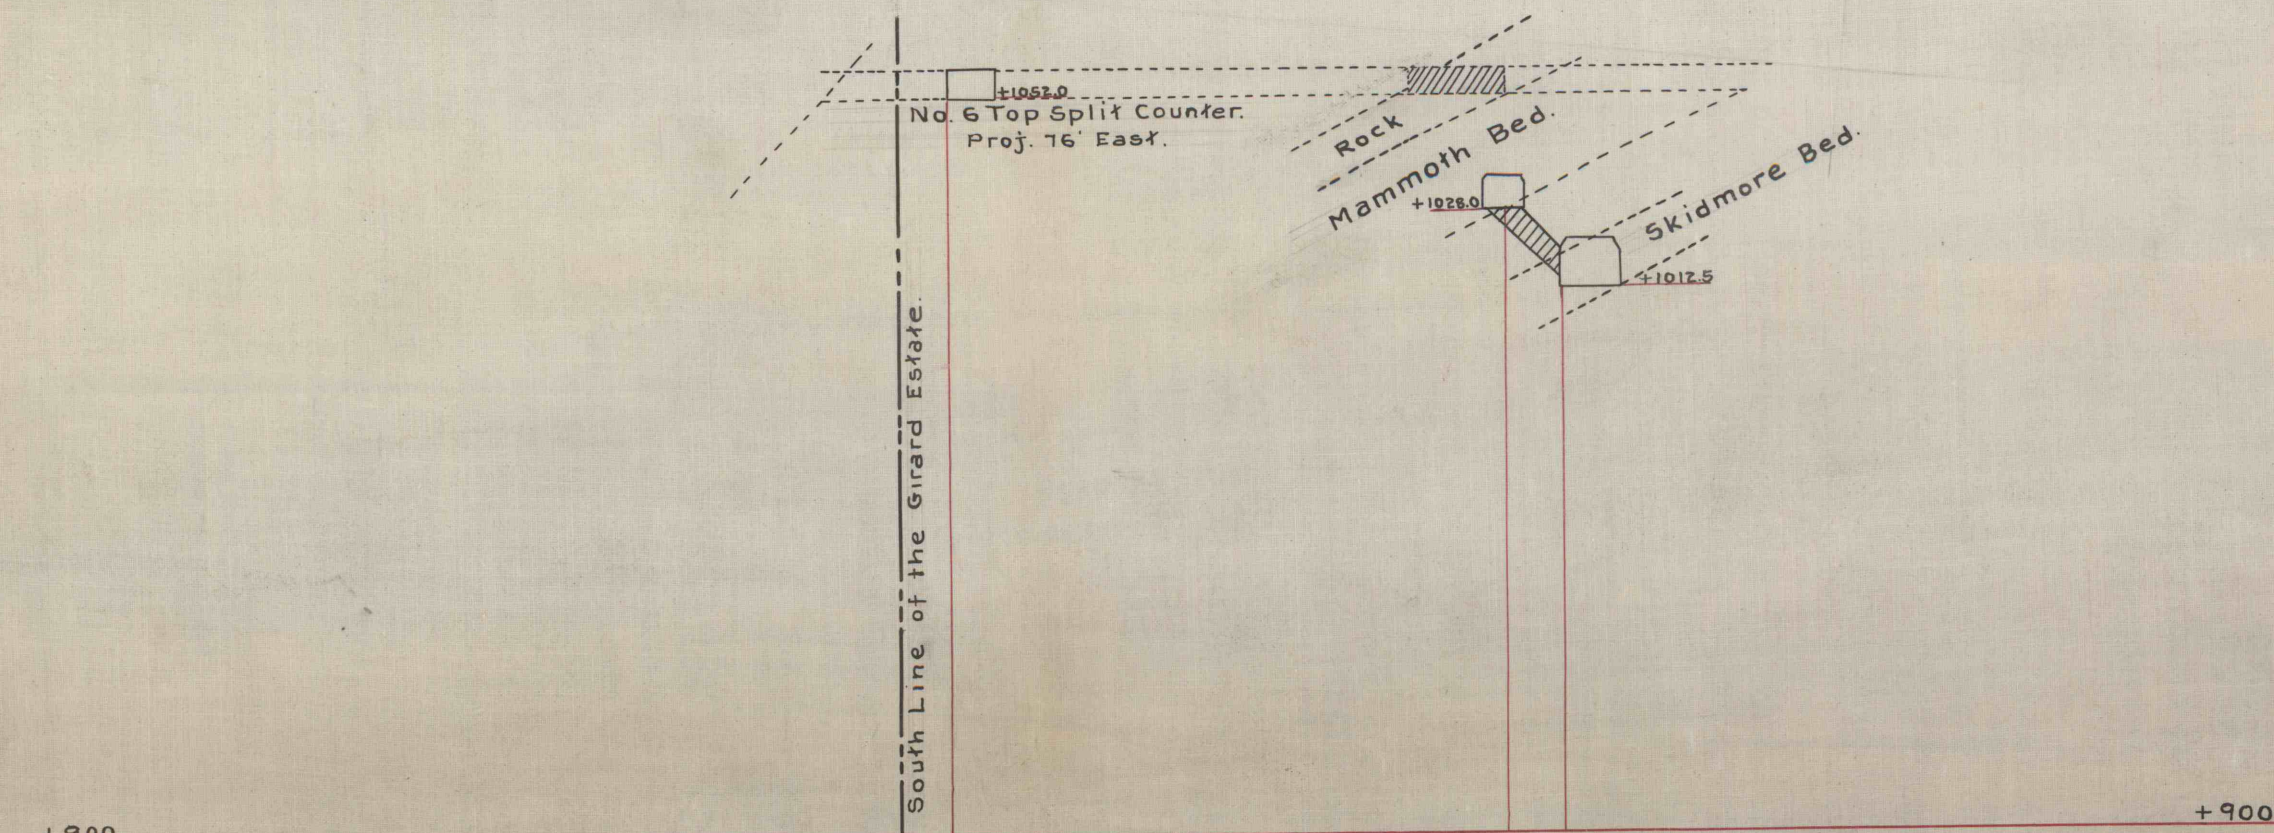

Section thru Line A-B — Scale 1 inch = 40 Feet.