


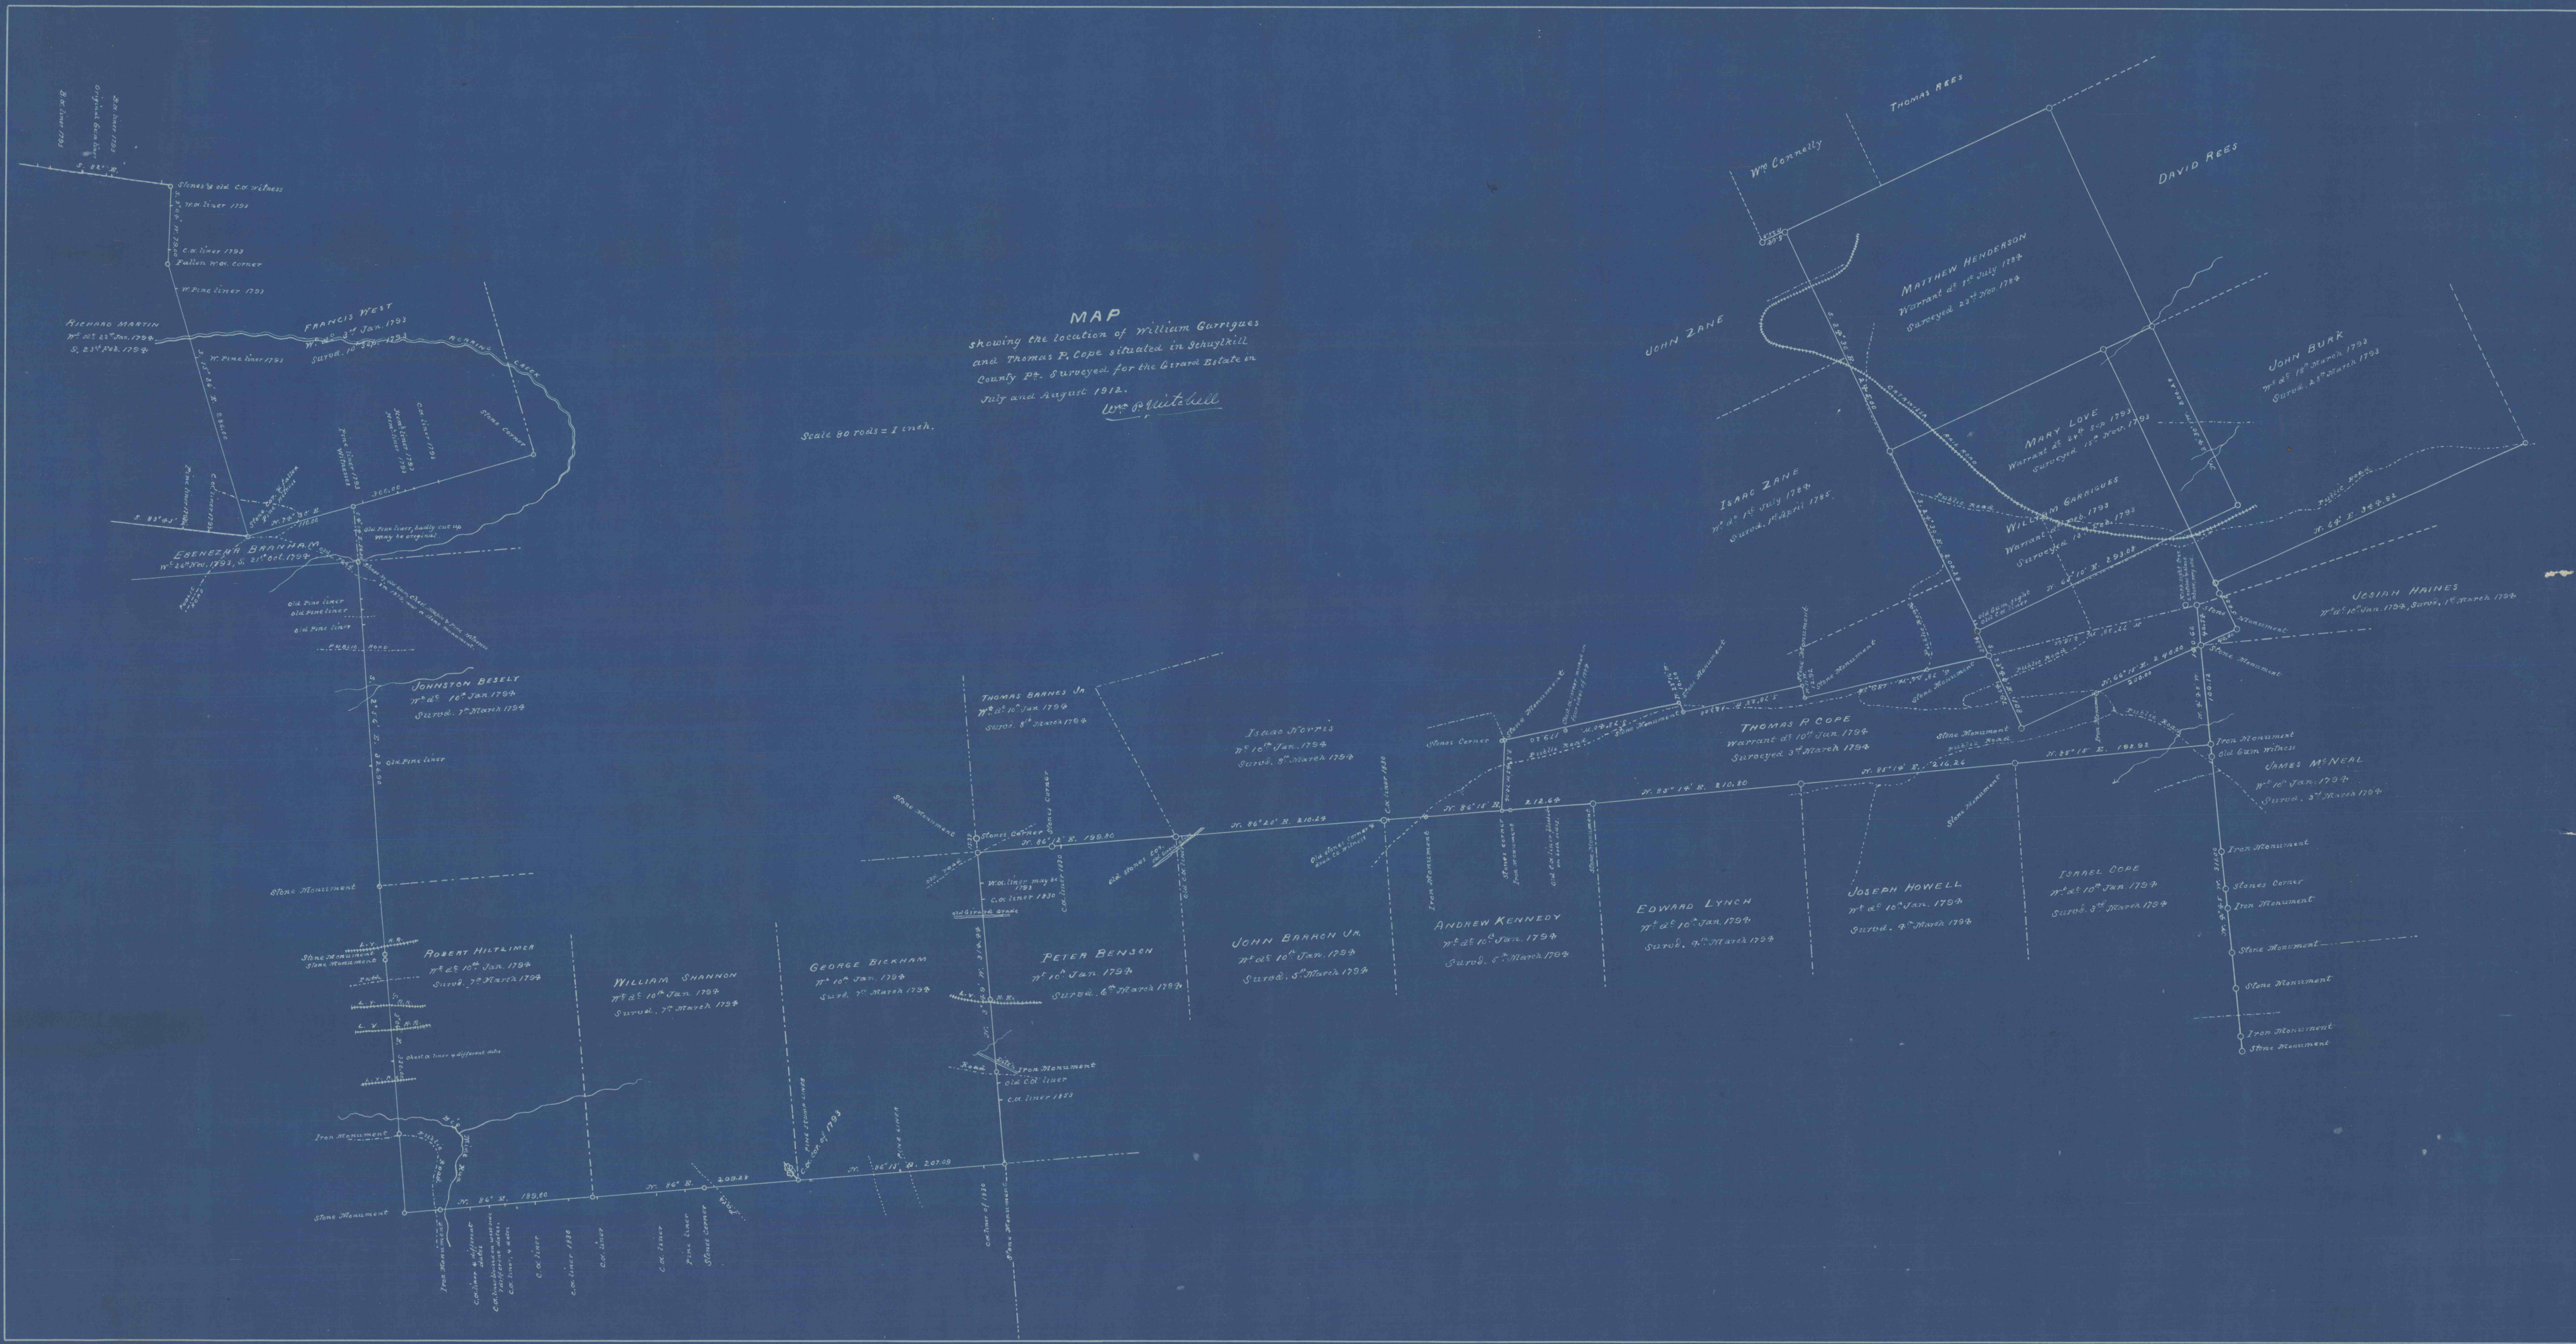

MAP  
showing the location of William Garrigue  
and Thomas P. Cope situated in Schuylkill  
County Pa. Surveyed for the Gerard Estate in  
July and August 1912.  
*Wm. P. Mitchell*

Scale 80 rods = 1 inch.