


MAP SHOWING LOCATION OF
THE WILLIAM GARRIGUES TRACT

UNION TOWNSHIP SCHUYLKILL CO. PA.
 Scale 100 Perches = One inch

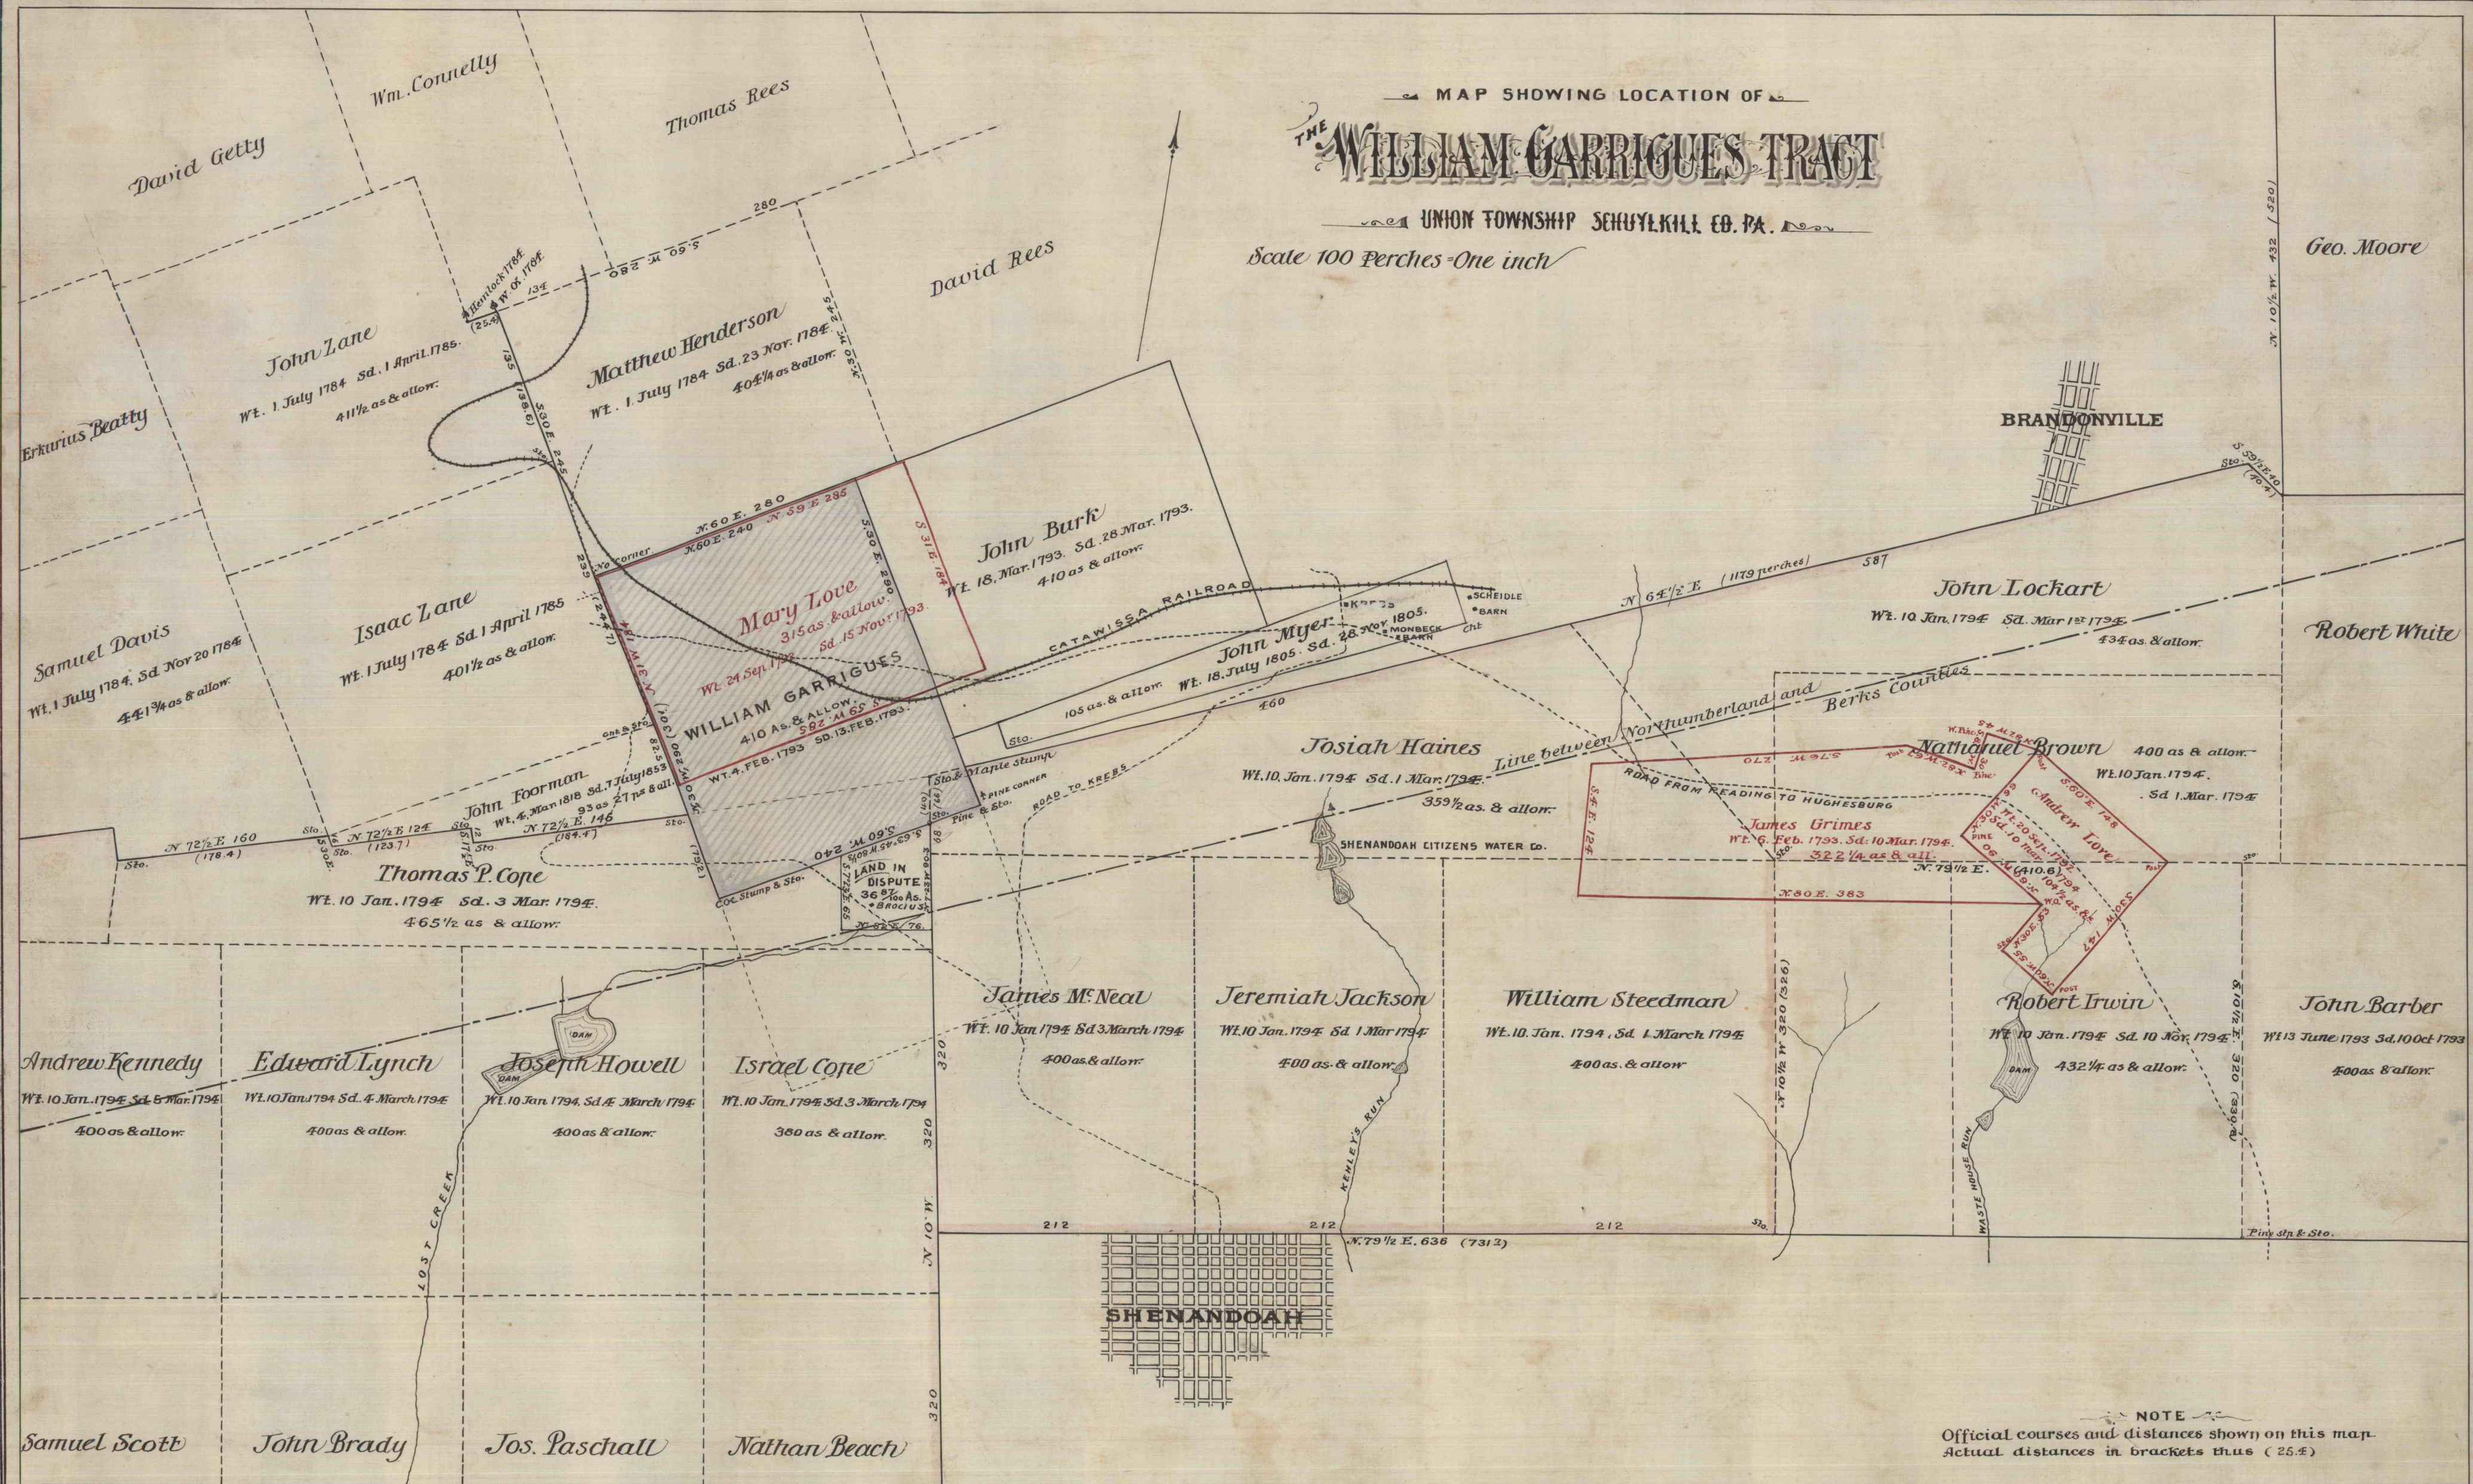

NOTE
 Official courses and distances shown on this map.
 Actual distances in brackets thus (25.4)

Ex. No. 10 June 22 1897
 typ