


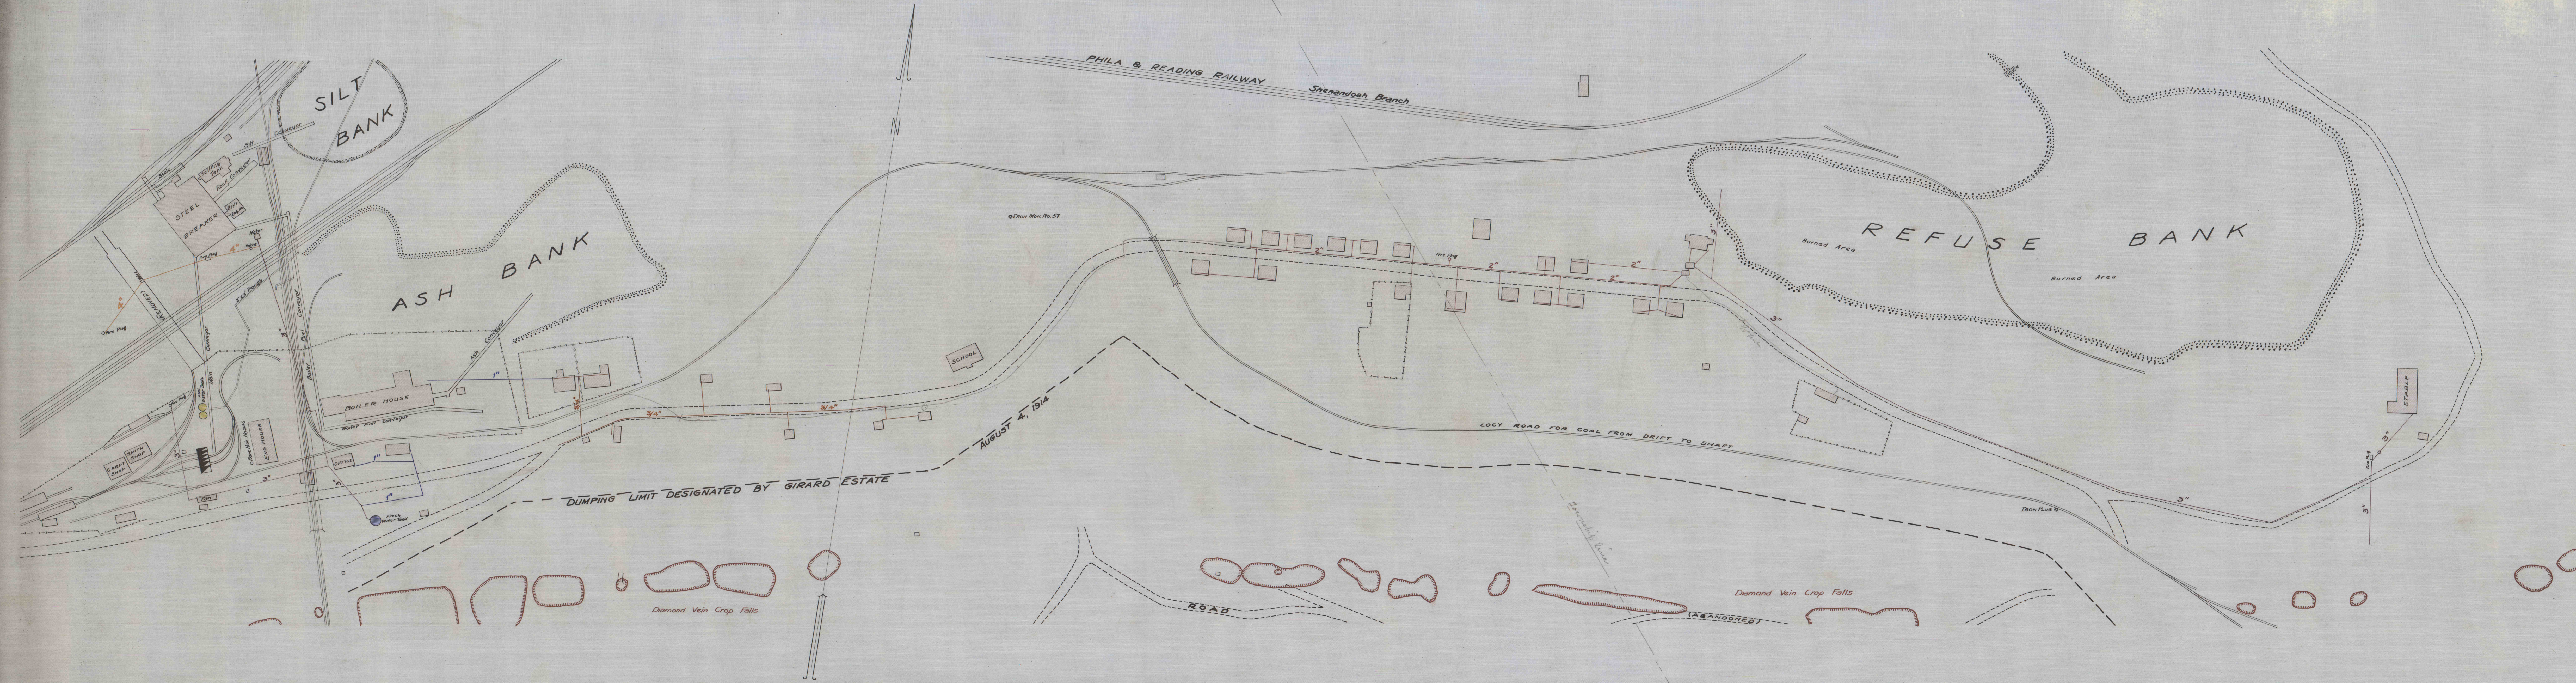

WATER PIPE LINES
 IN
 COLORADO VILLAGE AND FARMERTOWN
 SCHUYLKILL COUNTY, PENNA.,
 Scale 1" = 100' Pottsville Pa. James Archbald
 July 7, 1923. Engineer, Rago & Girard Estate
 Copied from Lehigh Valley Coal Company blue print dated Aug 8, 1923