
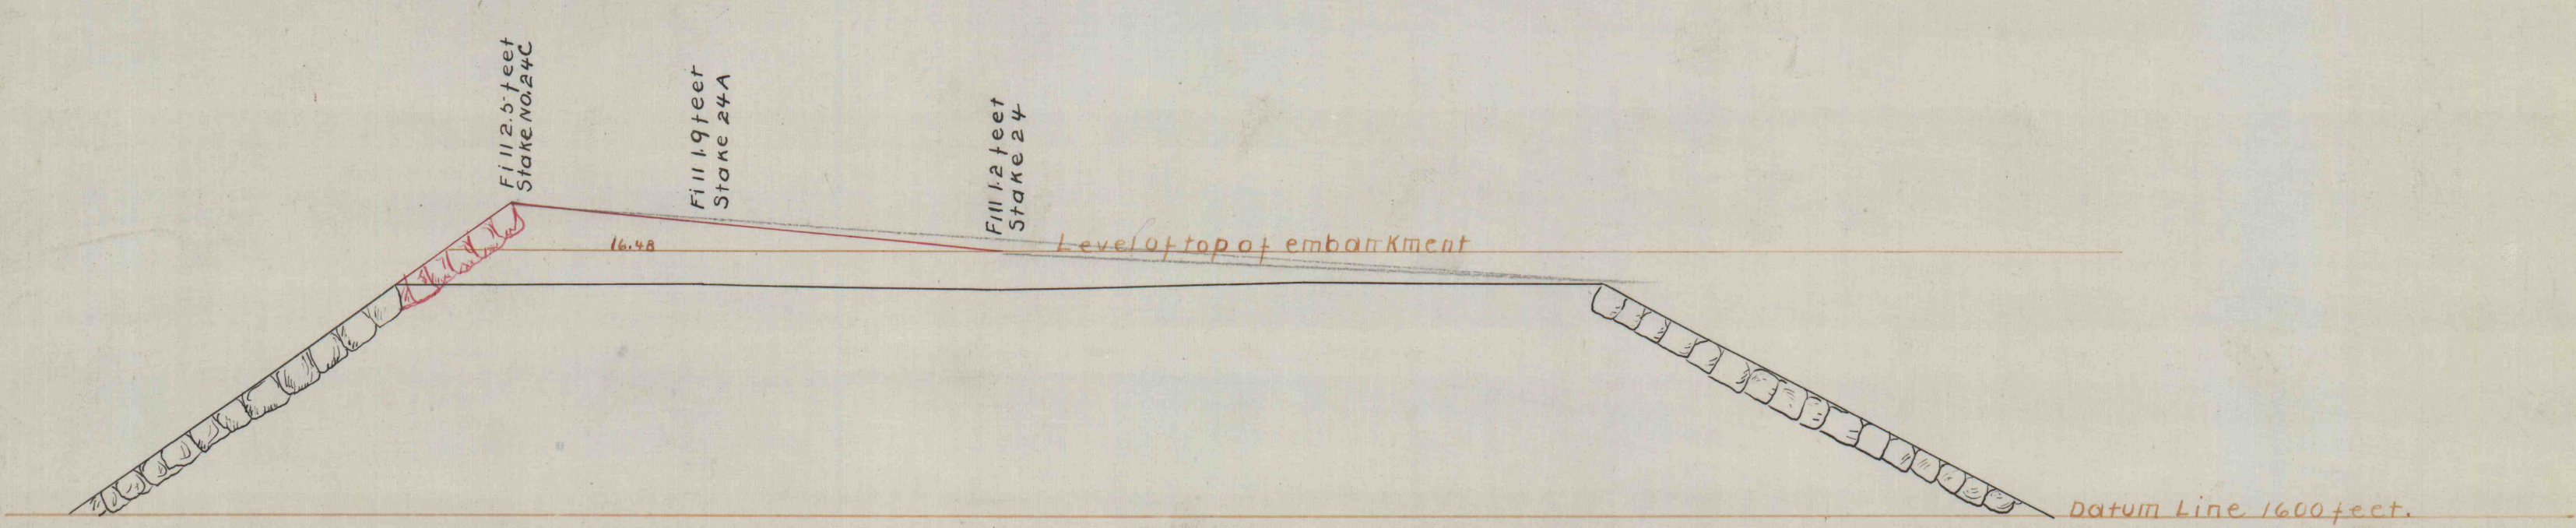
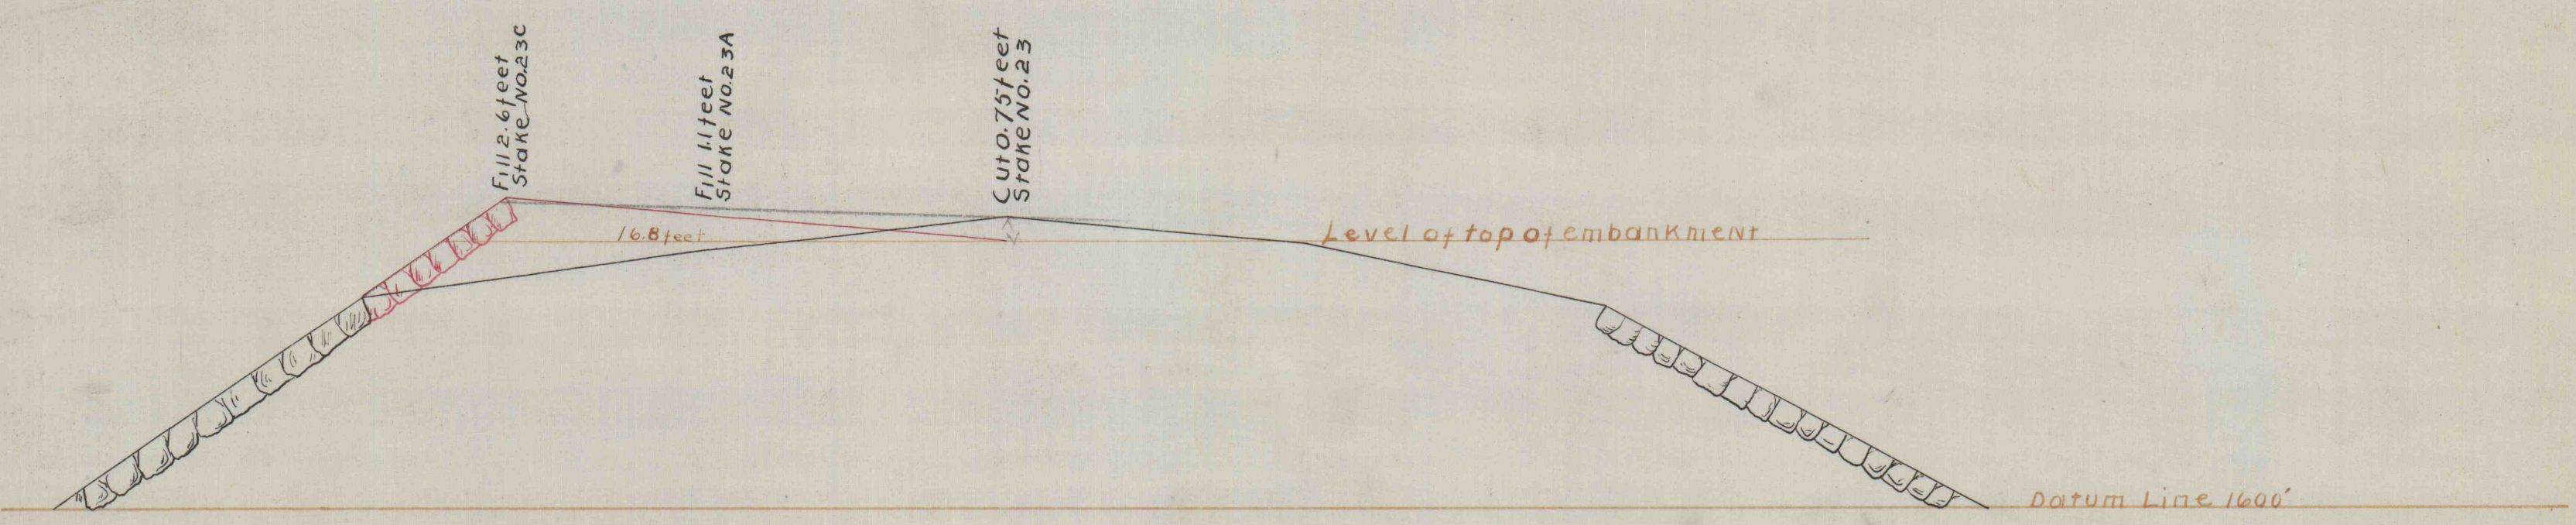
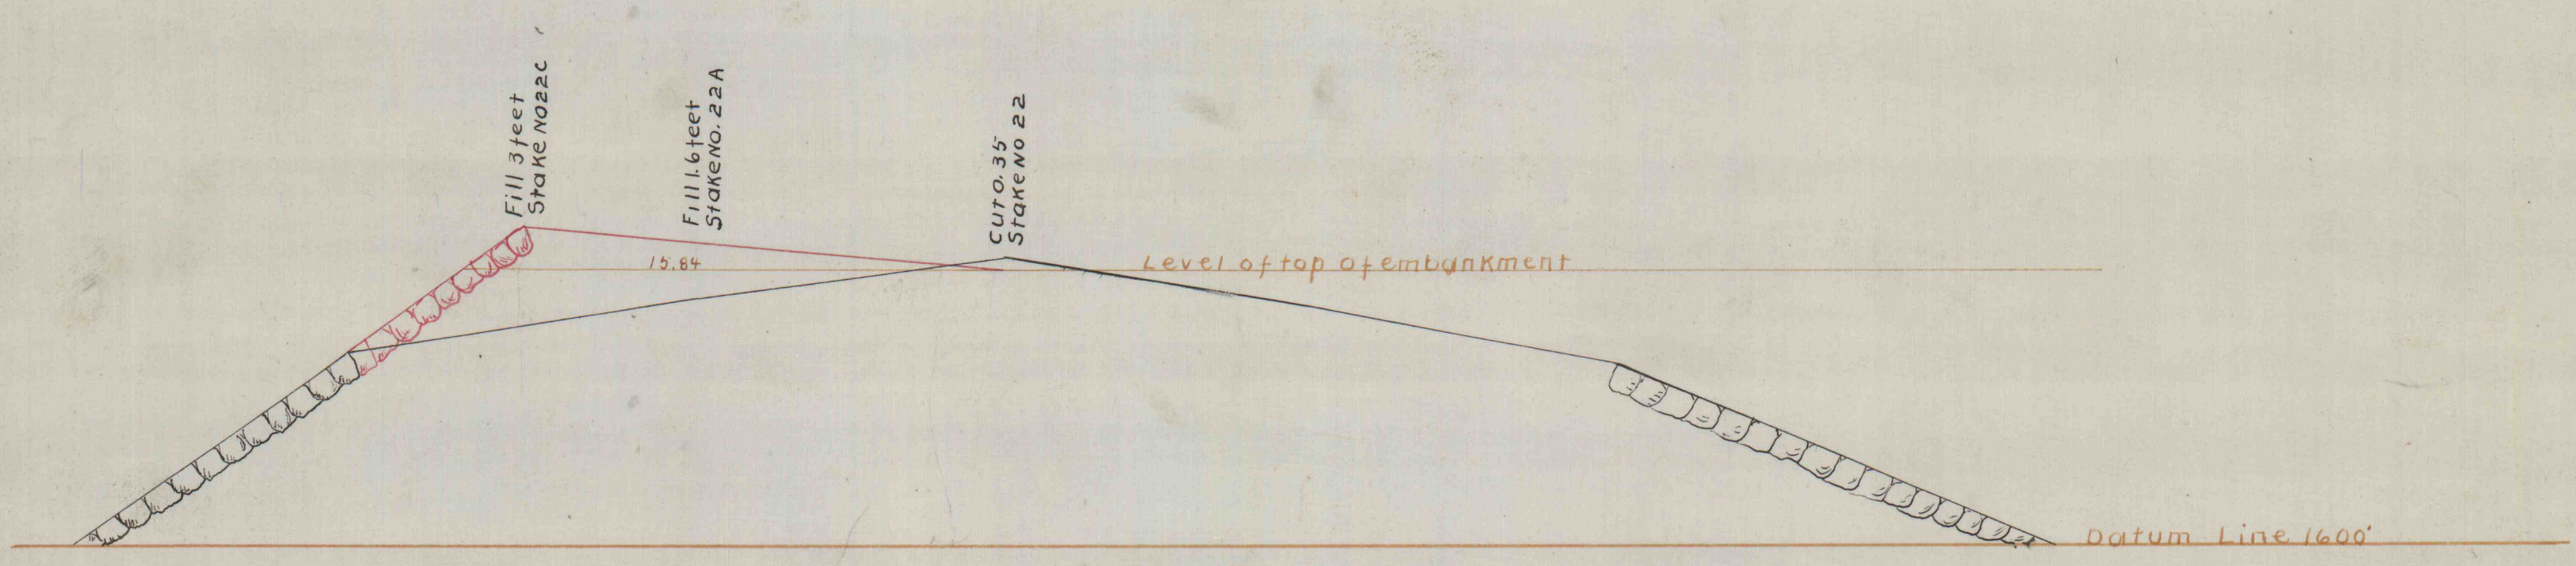
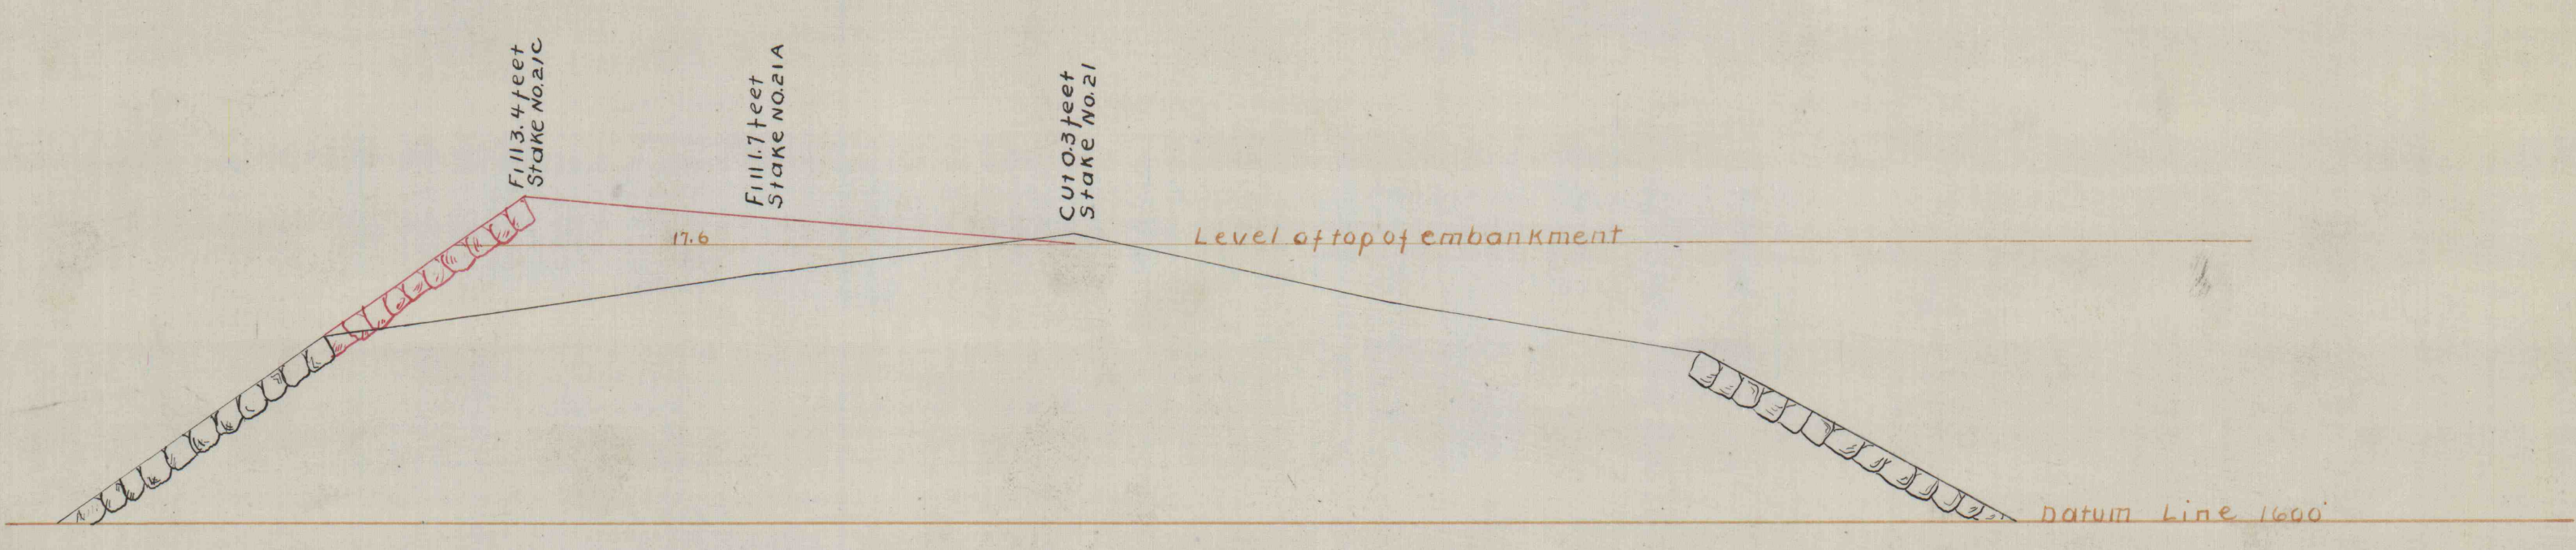
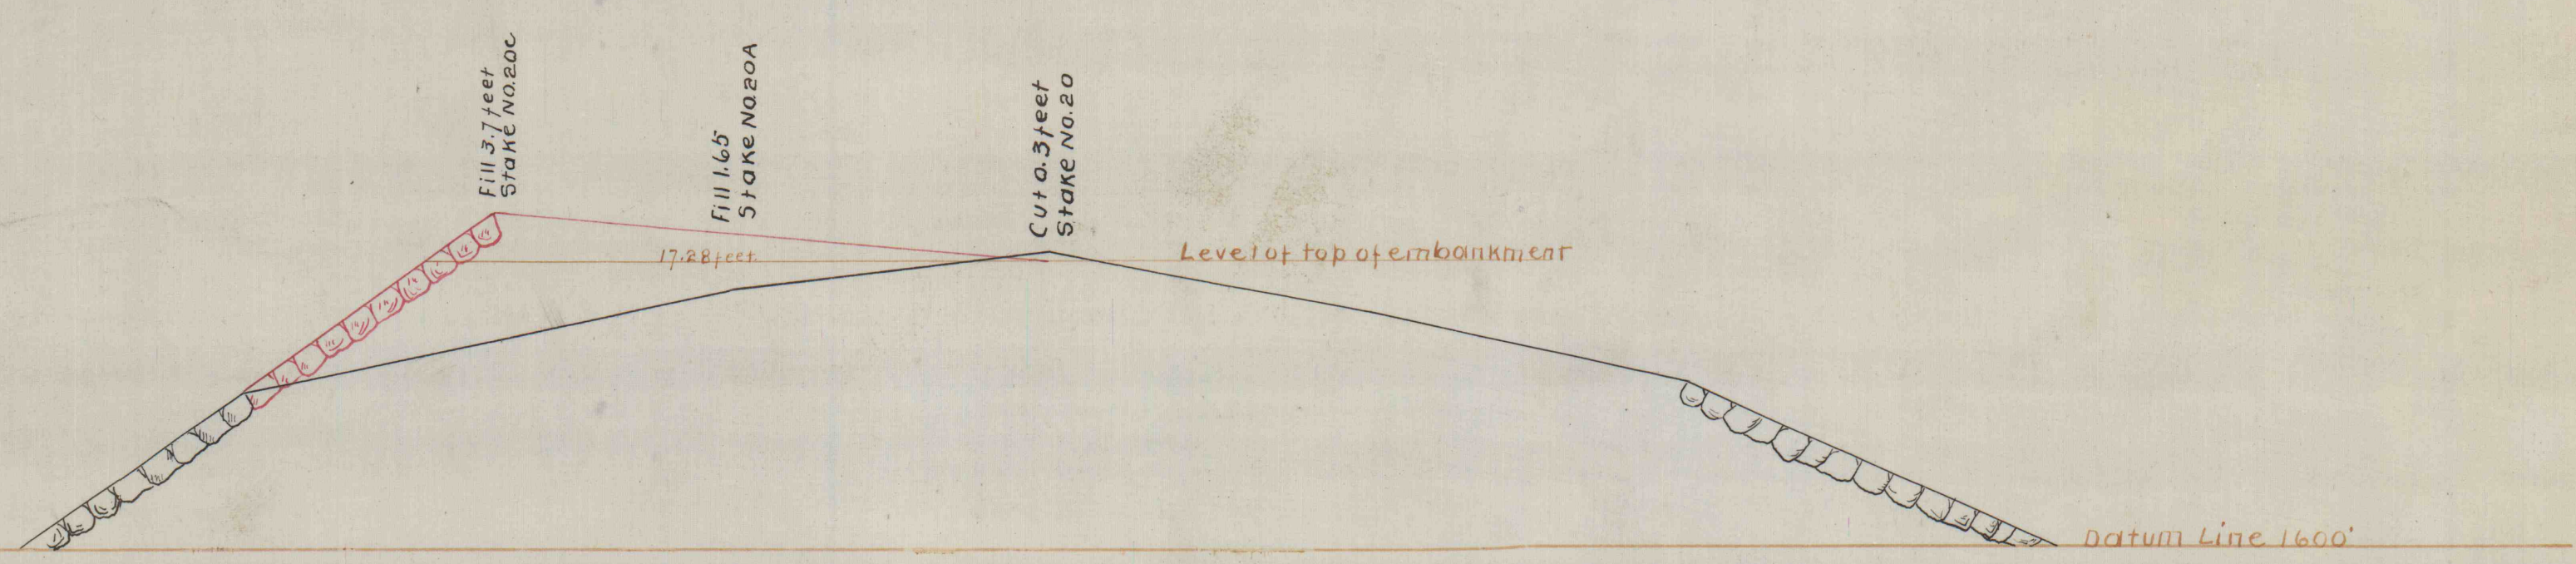
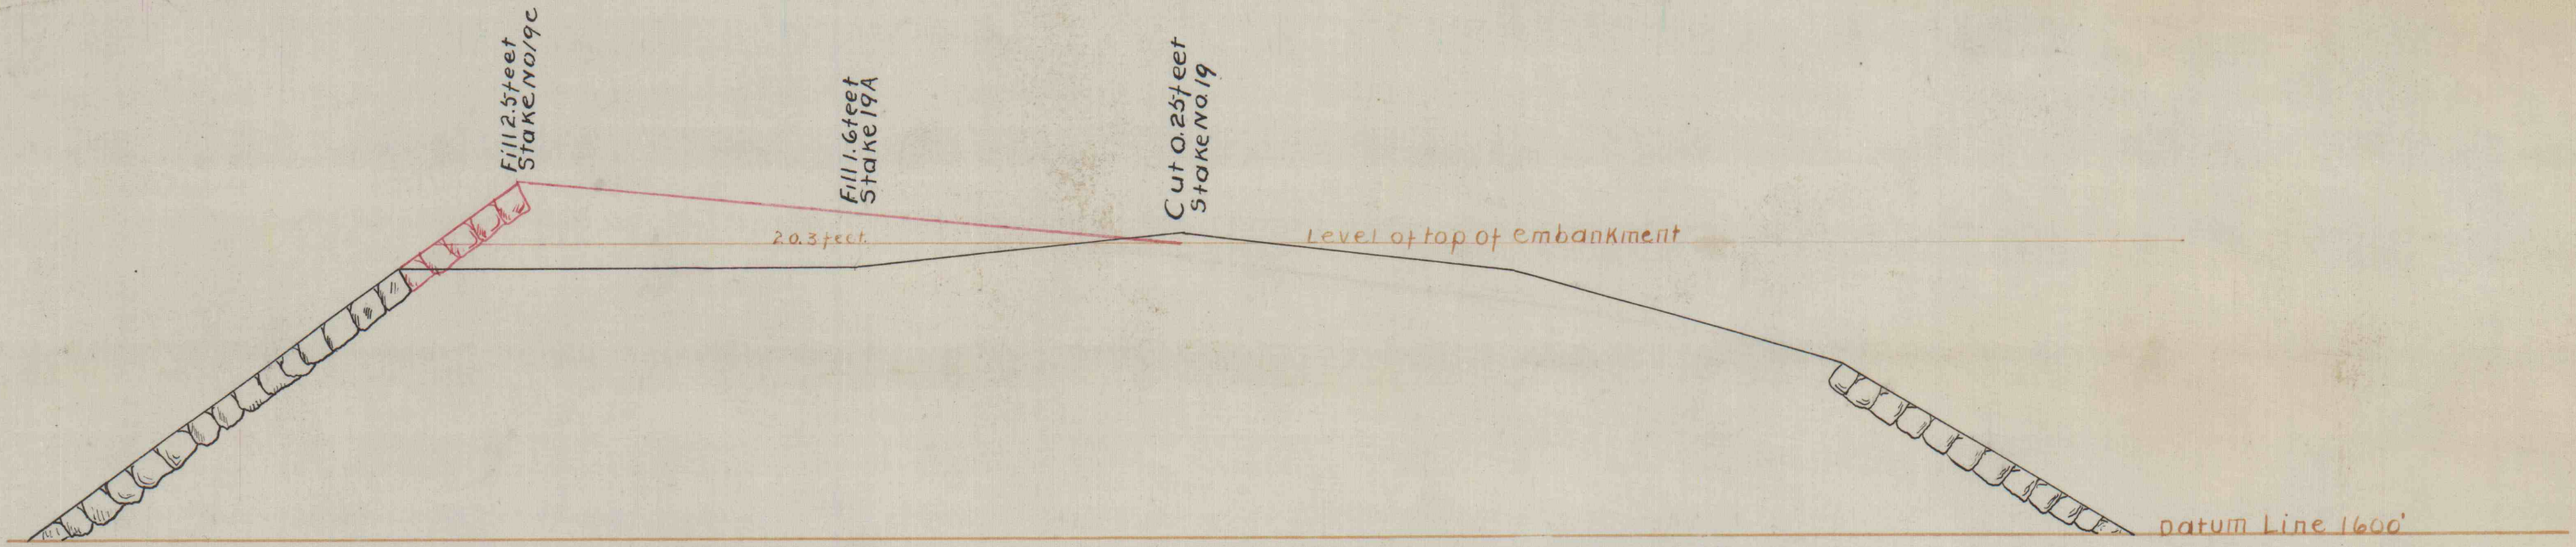
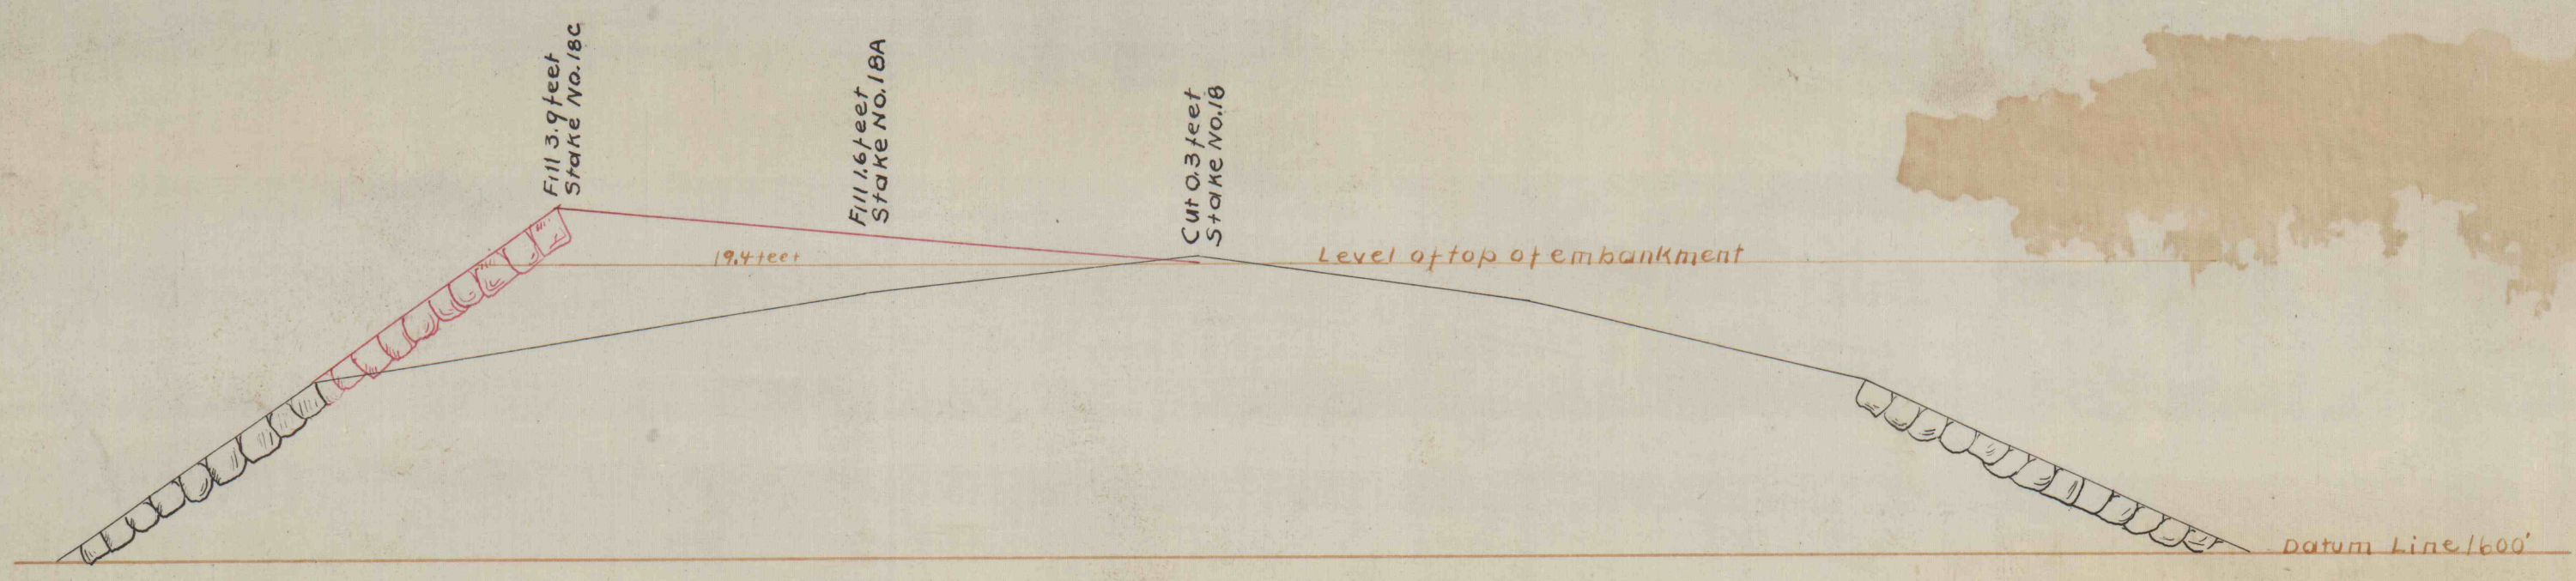


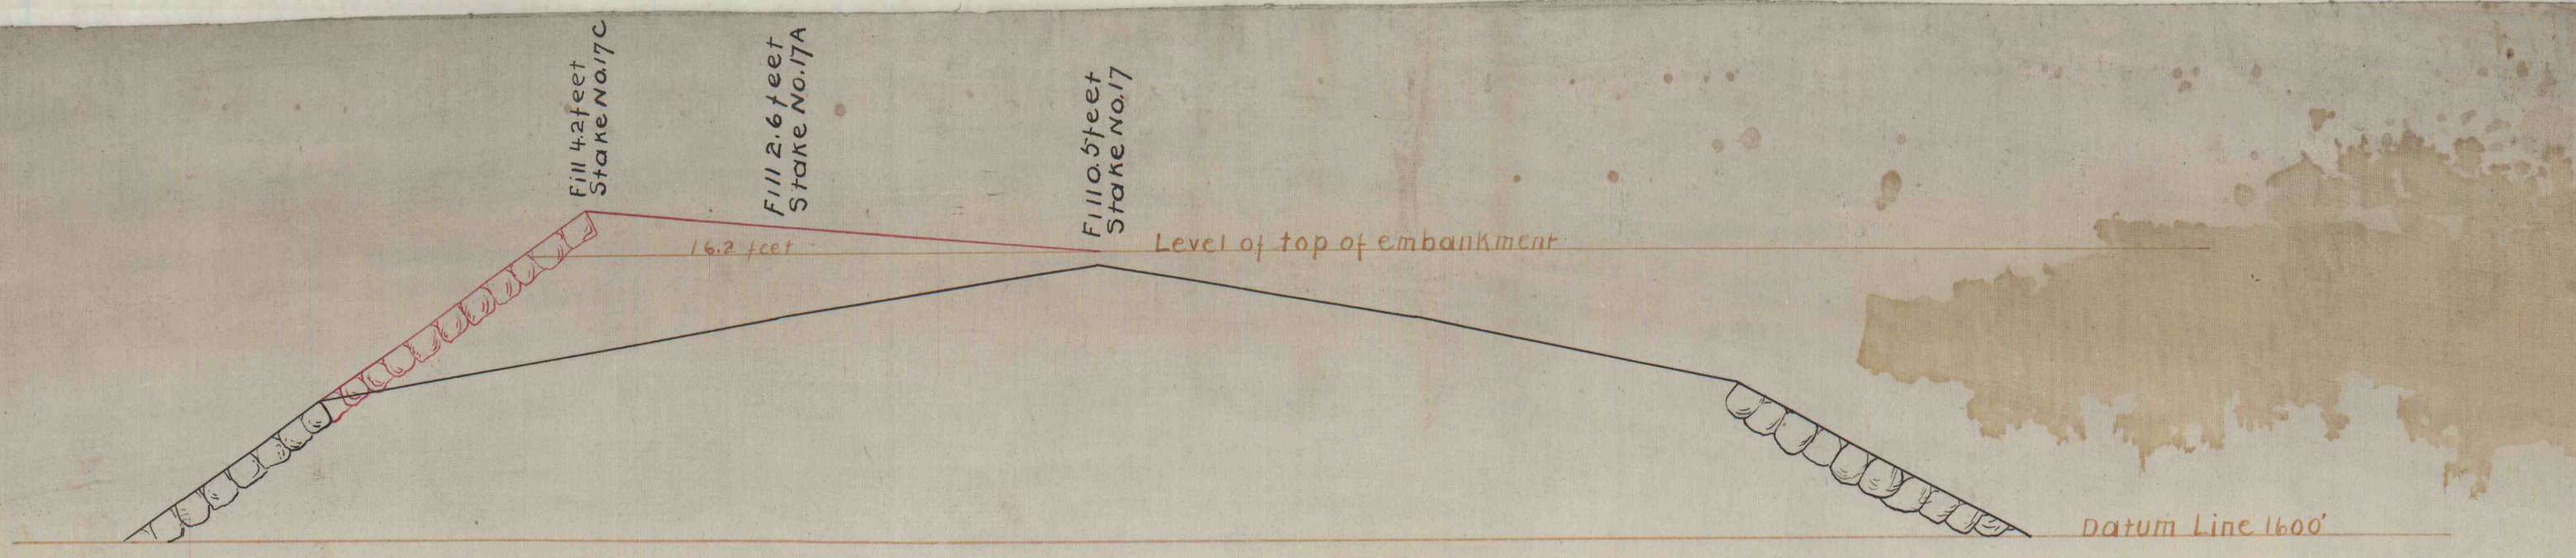

Not used -
 These are sections of No. 3. Reservoir Embankment -
 for series of tests of bank -
 Reservoir bank wry. South of trailway
 Aug. 21/1922 -
 Scale 1" = 5'-0"