

Thomas P. Cope

TOWNSHIP

UNION


TOWNSHIP

James Howell

Israel Cope

Edward Lynch

WEST MAHANOHY TOWNSHIP

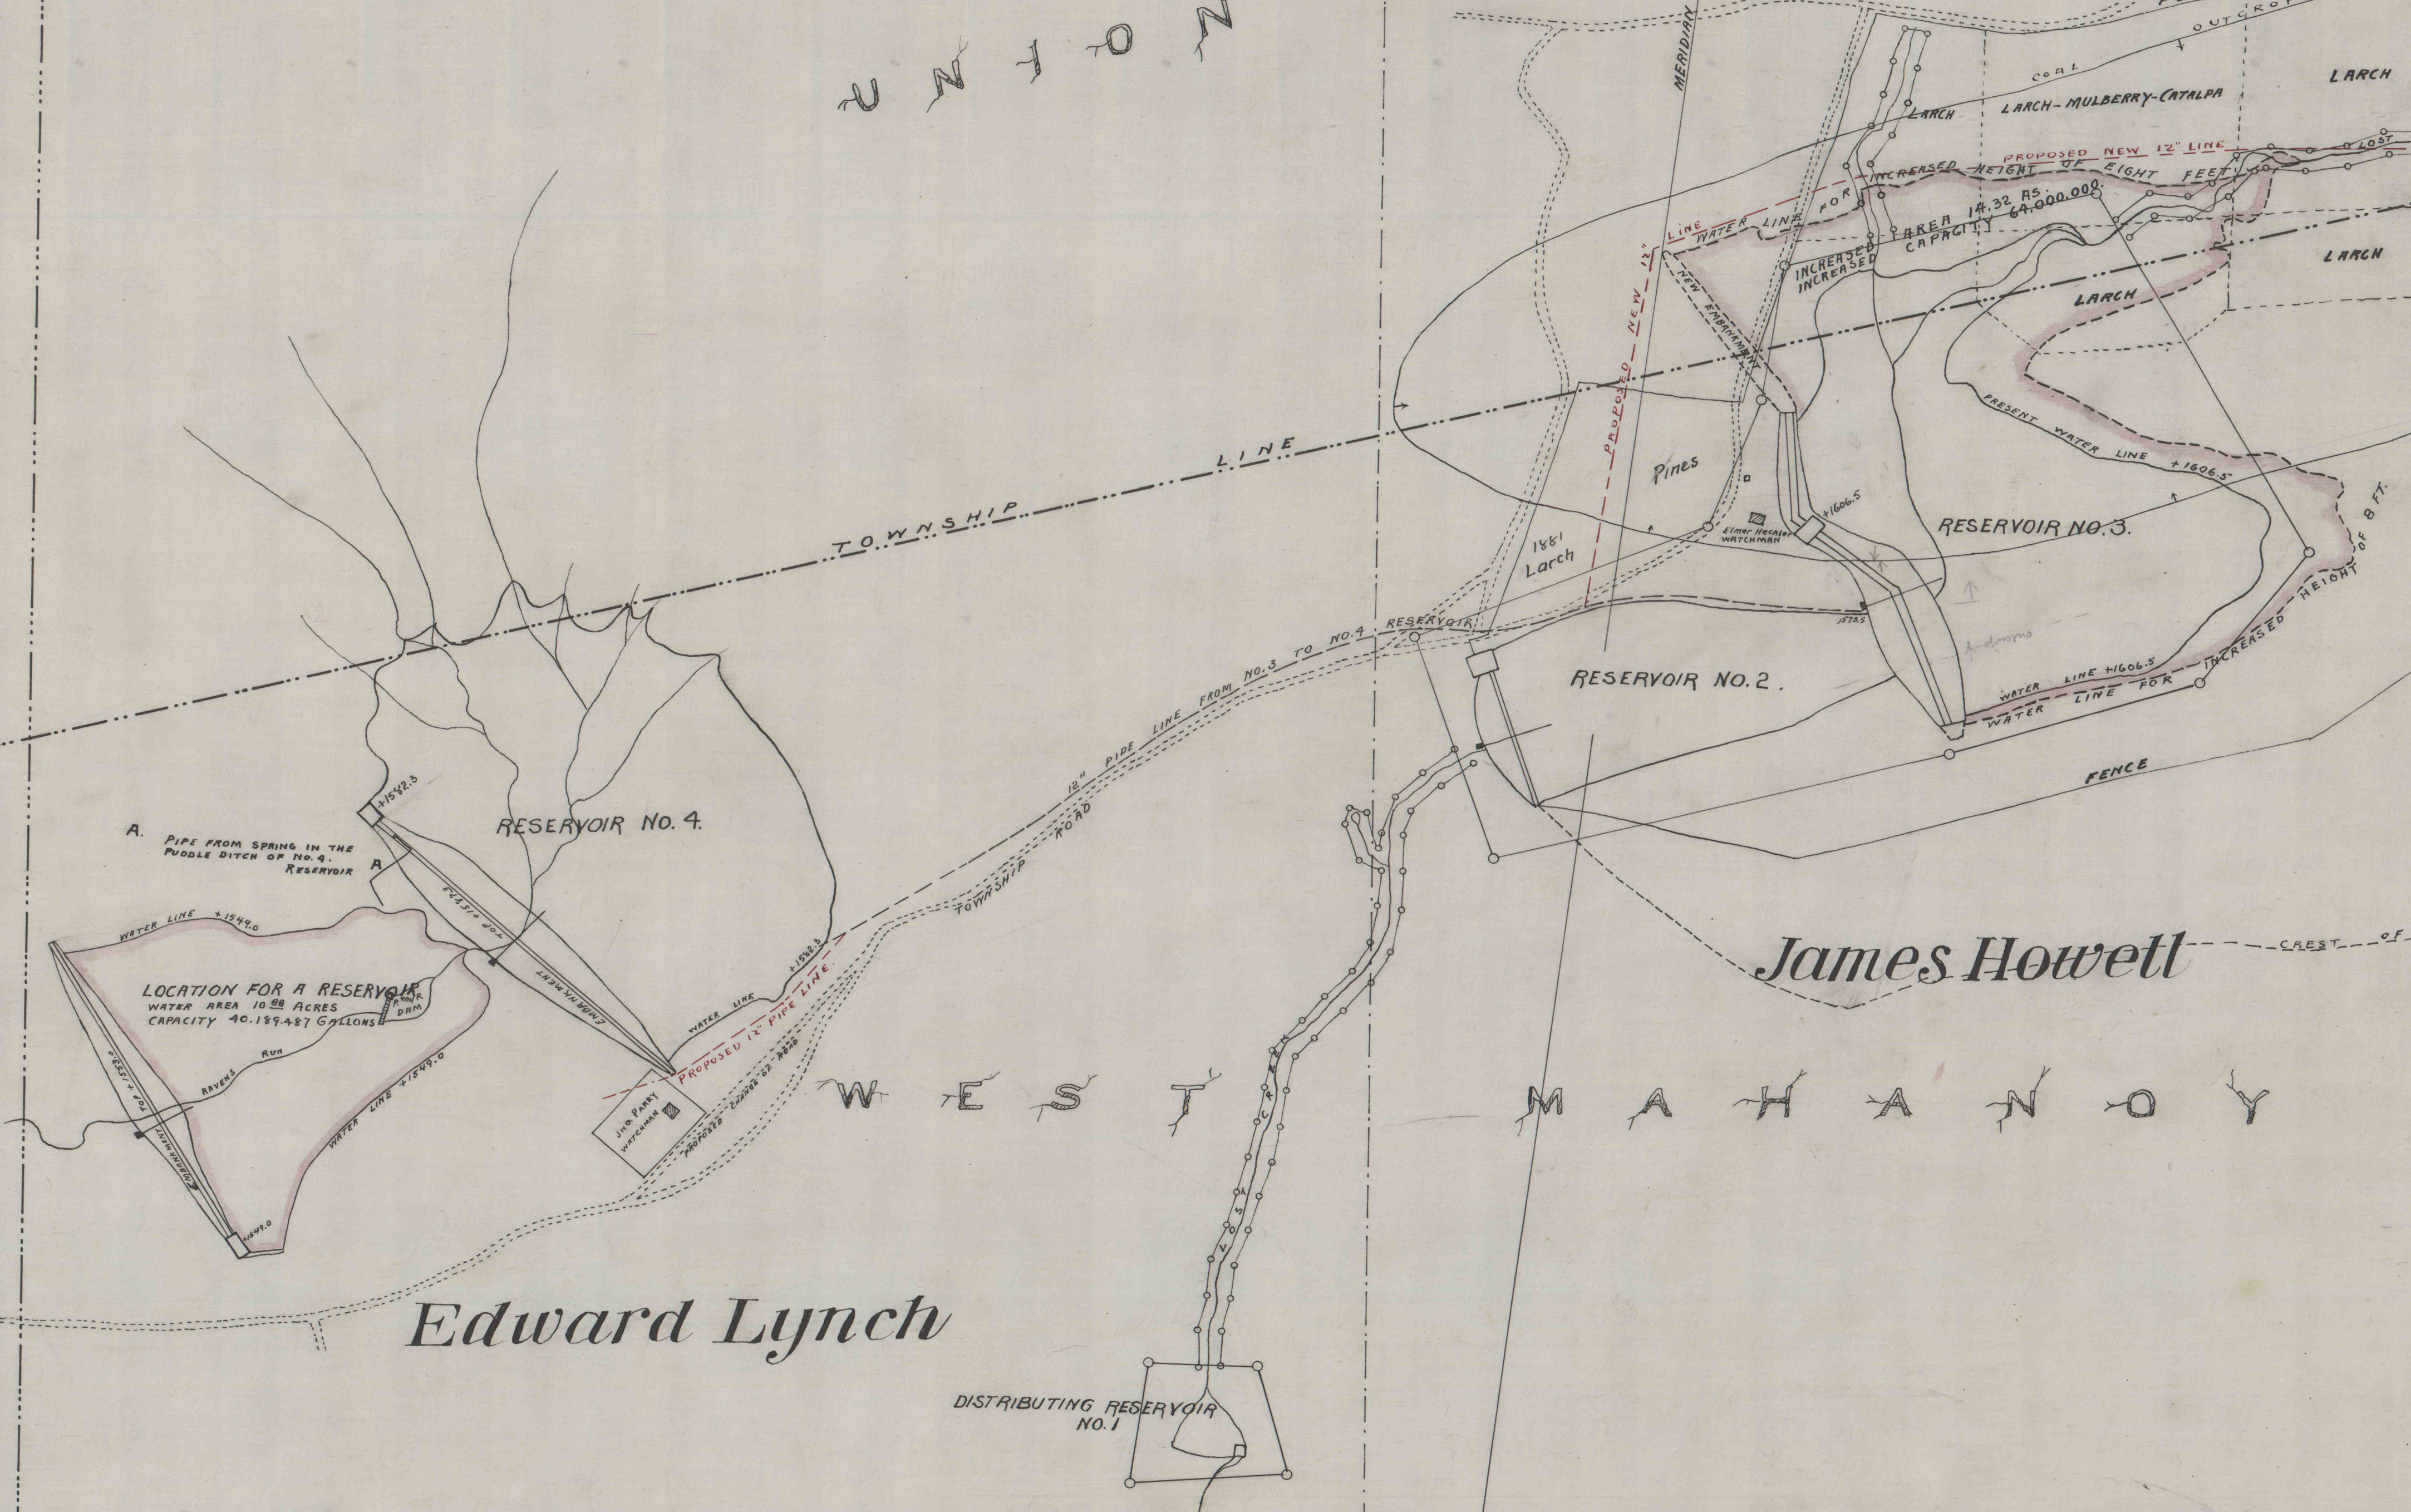

Girard Water Company's
Reservoirs Nos. 1-2-3 on Lost Creek - No. 4 on Ravens Run.
with
Locations for new Reservoir east of No. 3 on Lost Creek and West of No. 4 on Ravens Run
and
Increase of Capacity of No. 3 on Lost Creek
Report to General Louis Wagner - President - Dec. 3. 1894.
Scale 1 inch = 300 feet
Heber S. Thompson, Engineer
and General Manager.