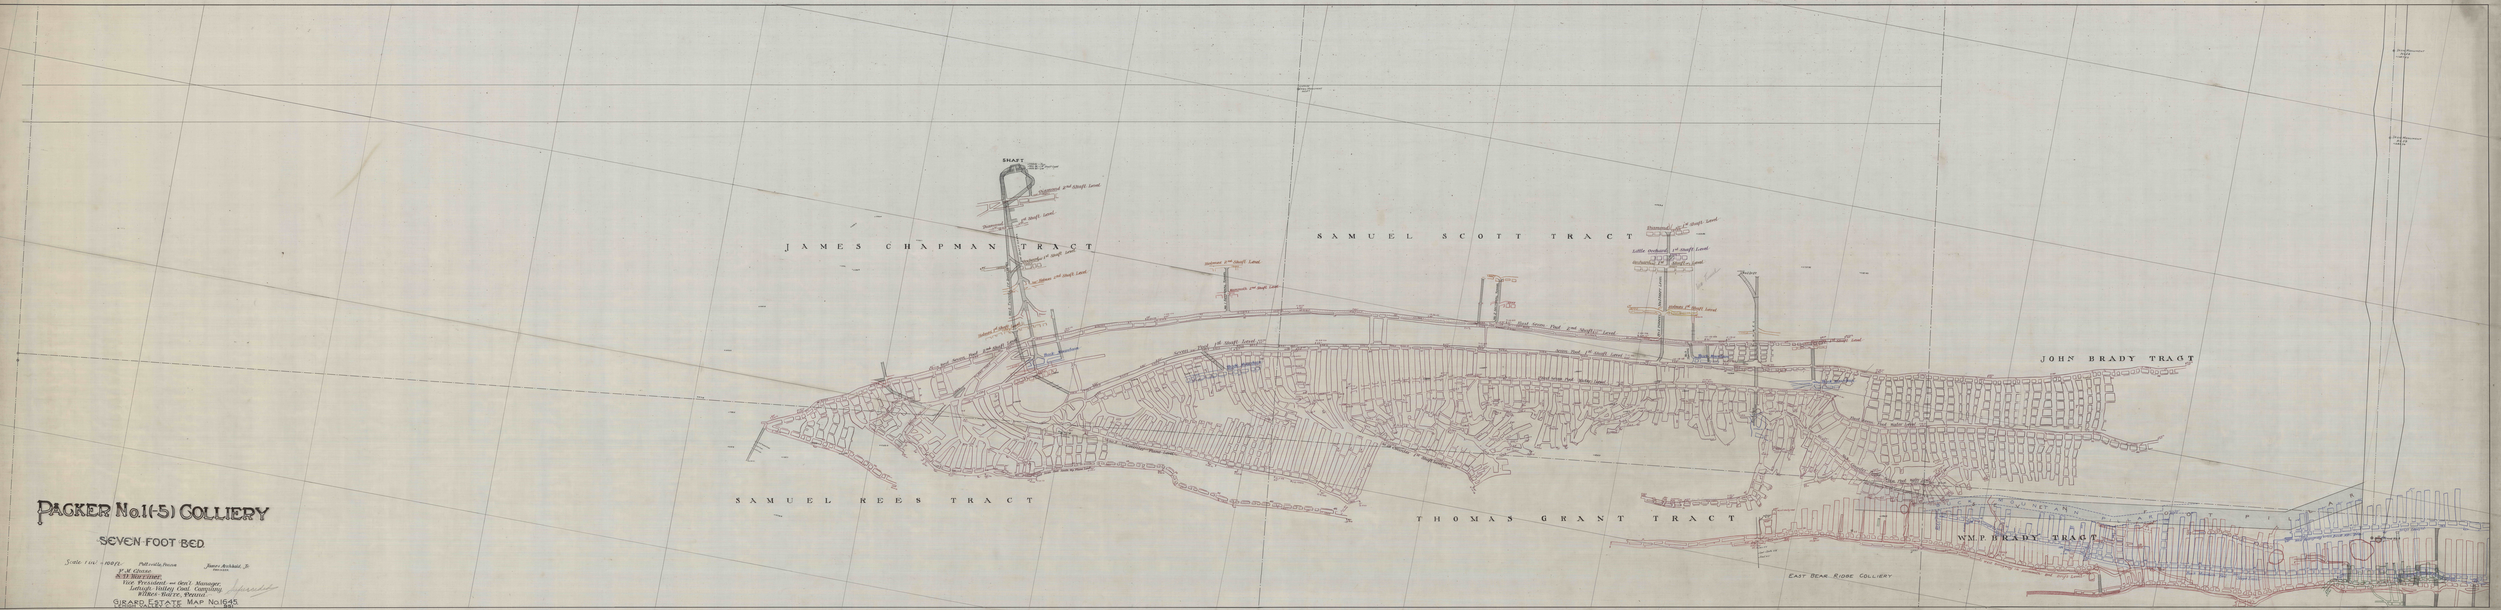

PACKER No.1(-5) COLLIERY

SEVEN FOOT BED.

Scale 1 inch = 100 ft. Pottsville, Penna. James Archbald, Jr. Surveyor.

P.M. Chance
A.T. Birkinbine
Lehigh Valley Coal Company

GIRARD ESTATE MAP No. 1645
LEHIGH VALLEY R.R.