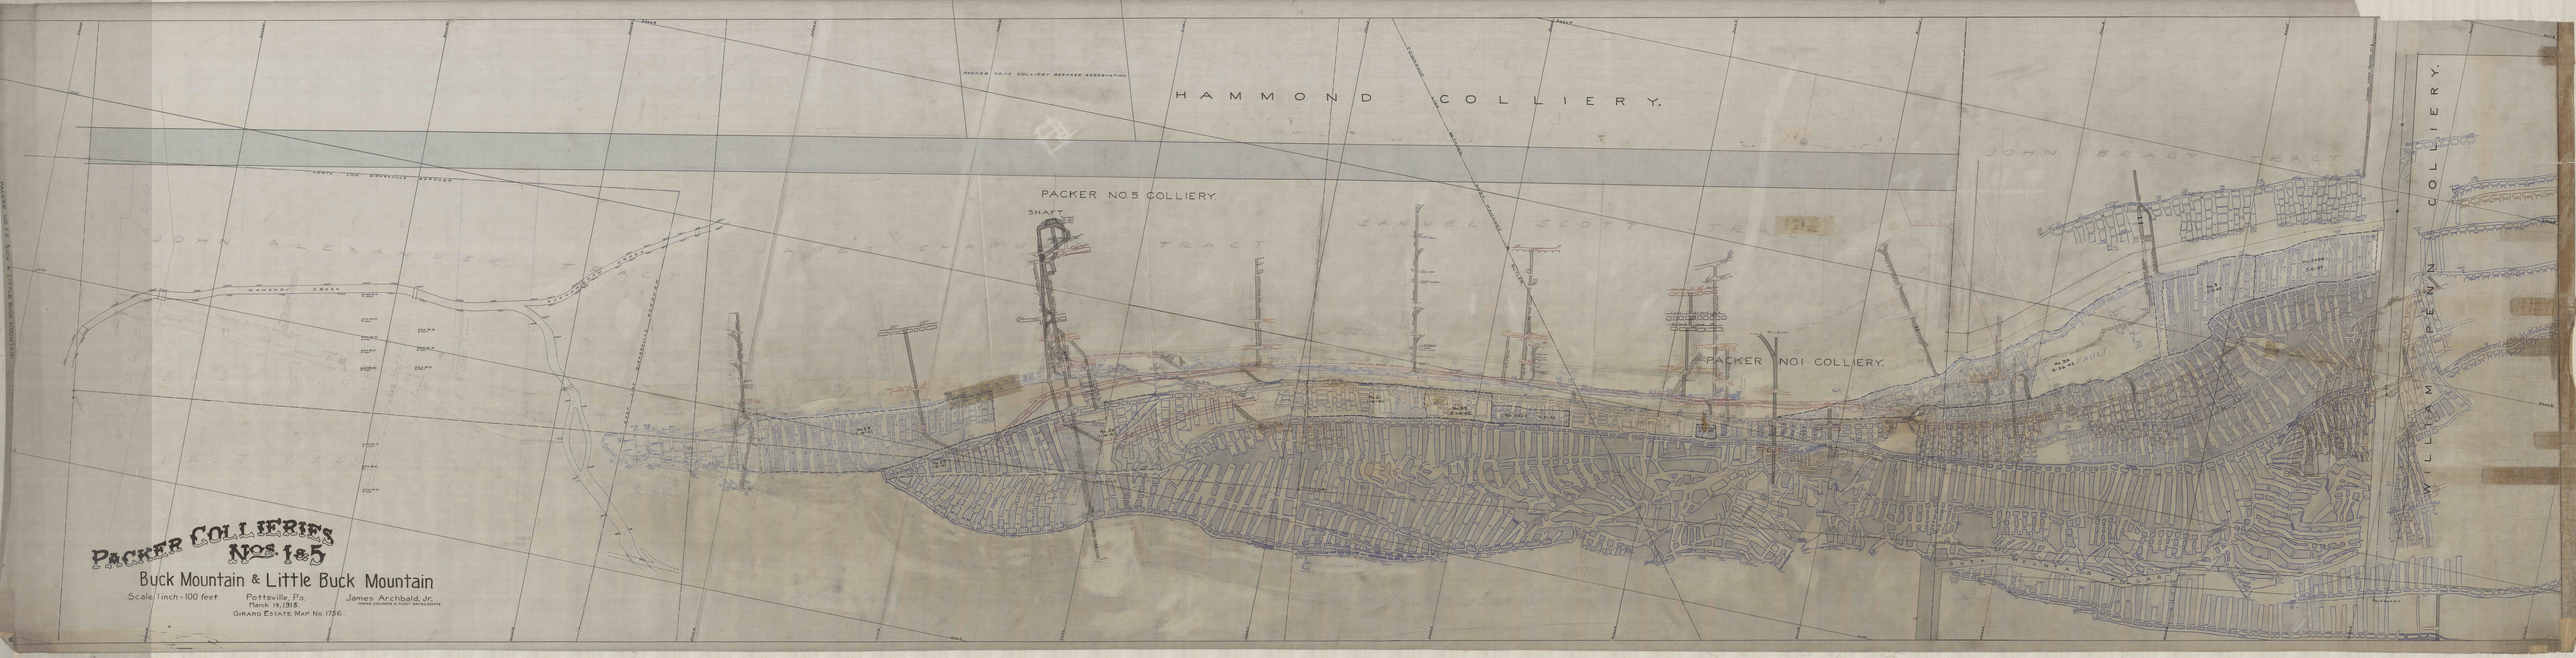

HAMMOND COLLIERY.
PACKER NO.5 COLLIERY.
SHAFT
PACKER NO.1 COLLIERY.
WILLIAM PENN COLLIERY.
SAMUEL SCOTT TRACT
JOHN ALEXANDER TRACT
FAULT
PACKER COLLIERIES
Nos. 1&5
Buck Mountain & Little Buck Mountain
Scale 1 inch = 100 feet
Pottsville, Pa.
March 19, 1918
James Archbald, Jr.
GIRARD ESTATE MAP No. 1756