


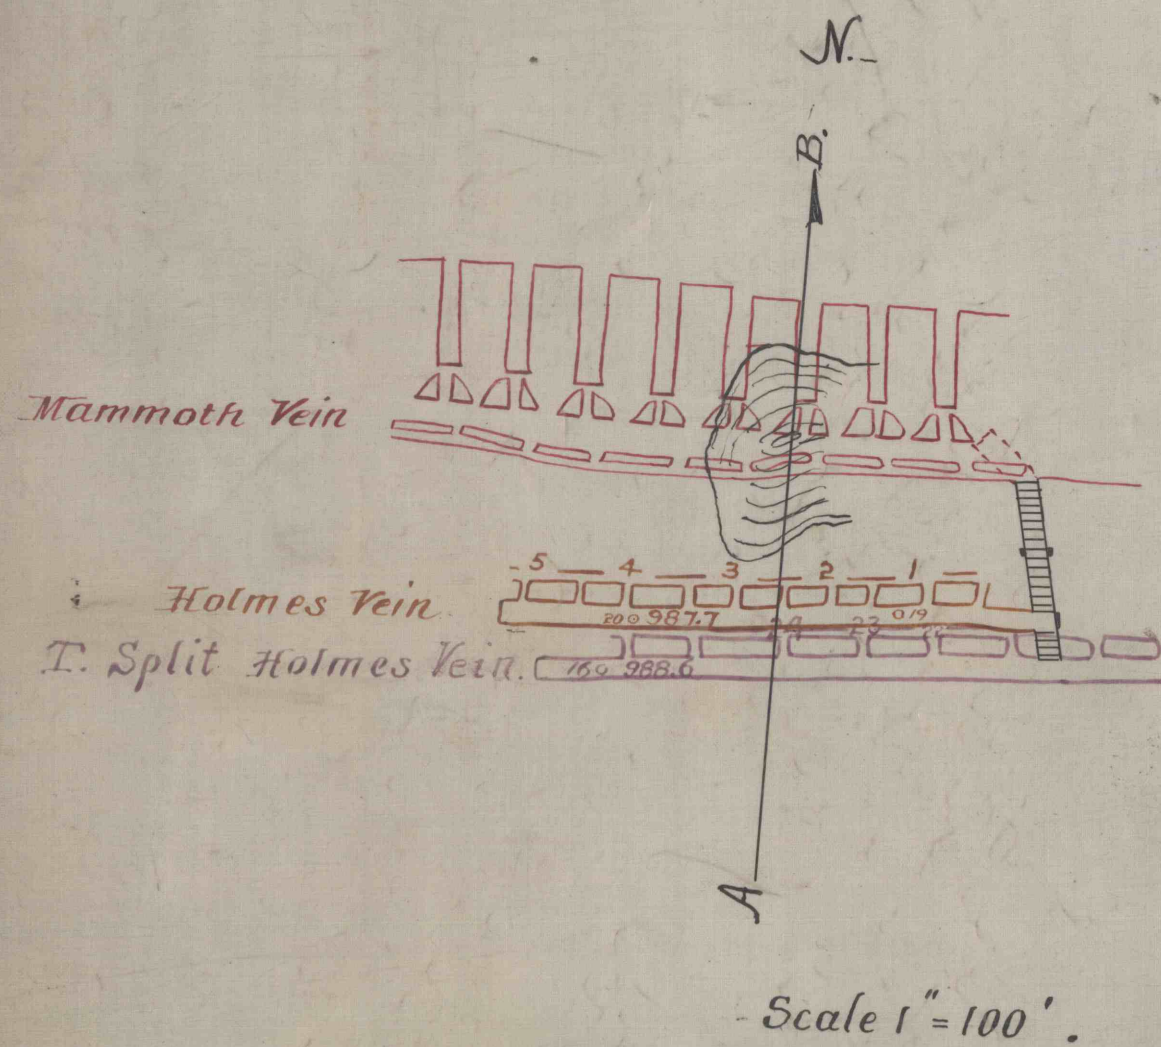

Girard Colliery. Section through workings above Water Level 1050 Feet West of Tunnel.

Pottsville, Pa Oct 19-1903.

Heber S. Thompson
ENGINEER

