



REVISED PLAN AND SIDE ELEVATION SCREEN CHAMBER

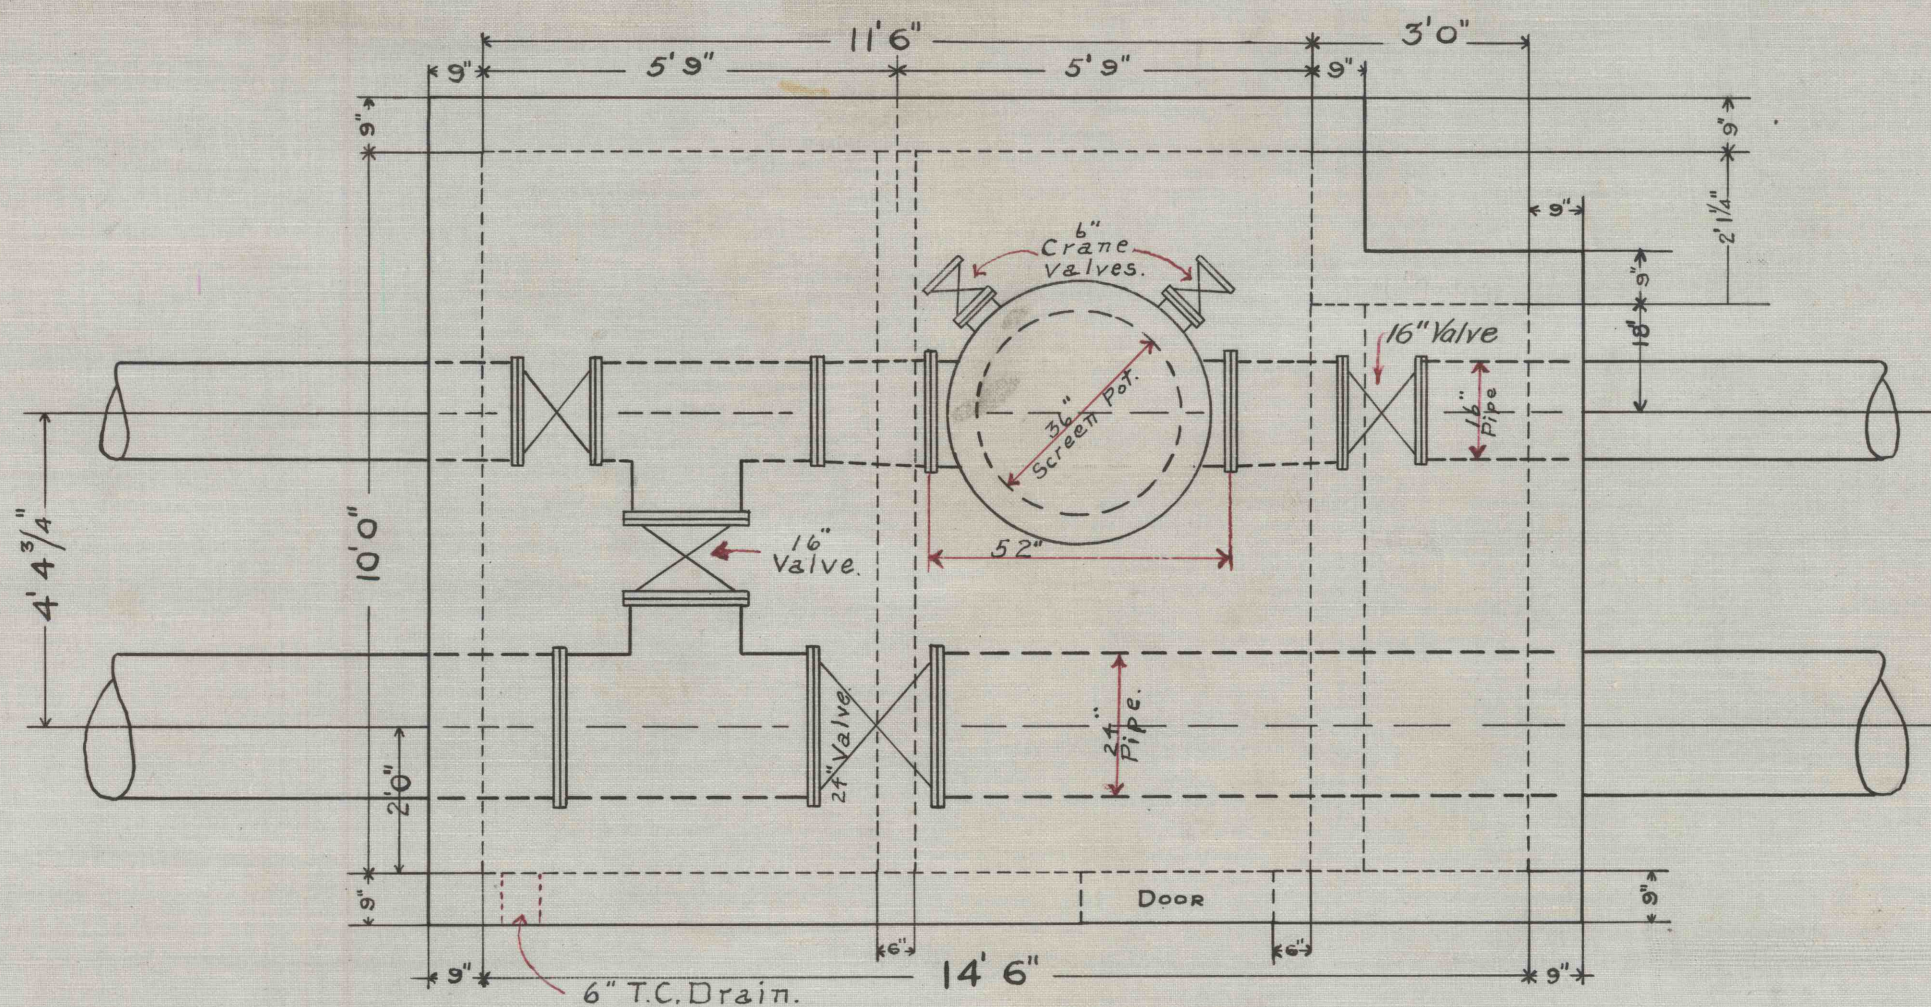

PLAN

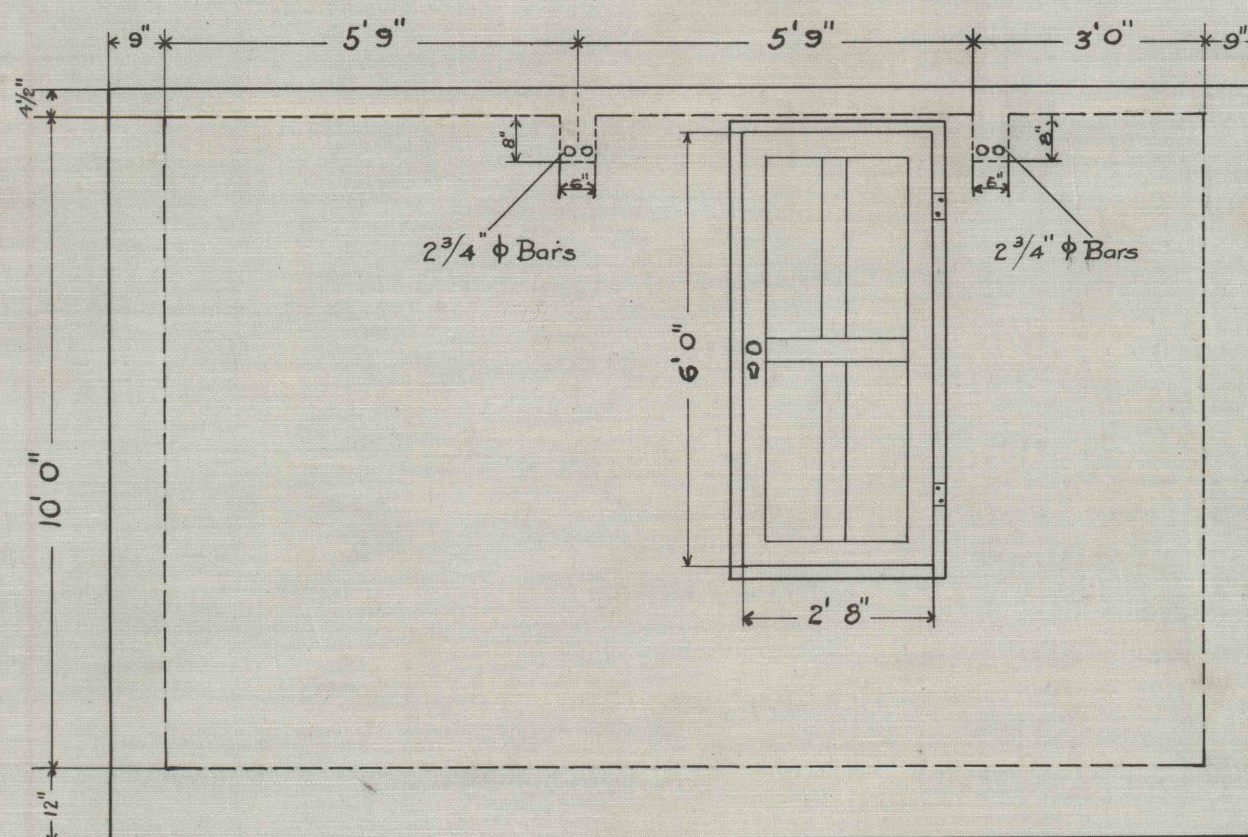

SIDE ELEVATION

SCALE $\frac{3}{8}" \approx 1'$