


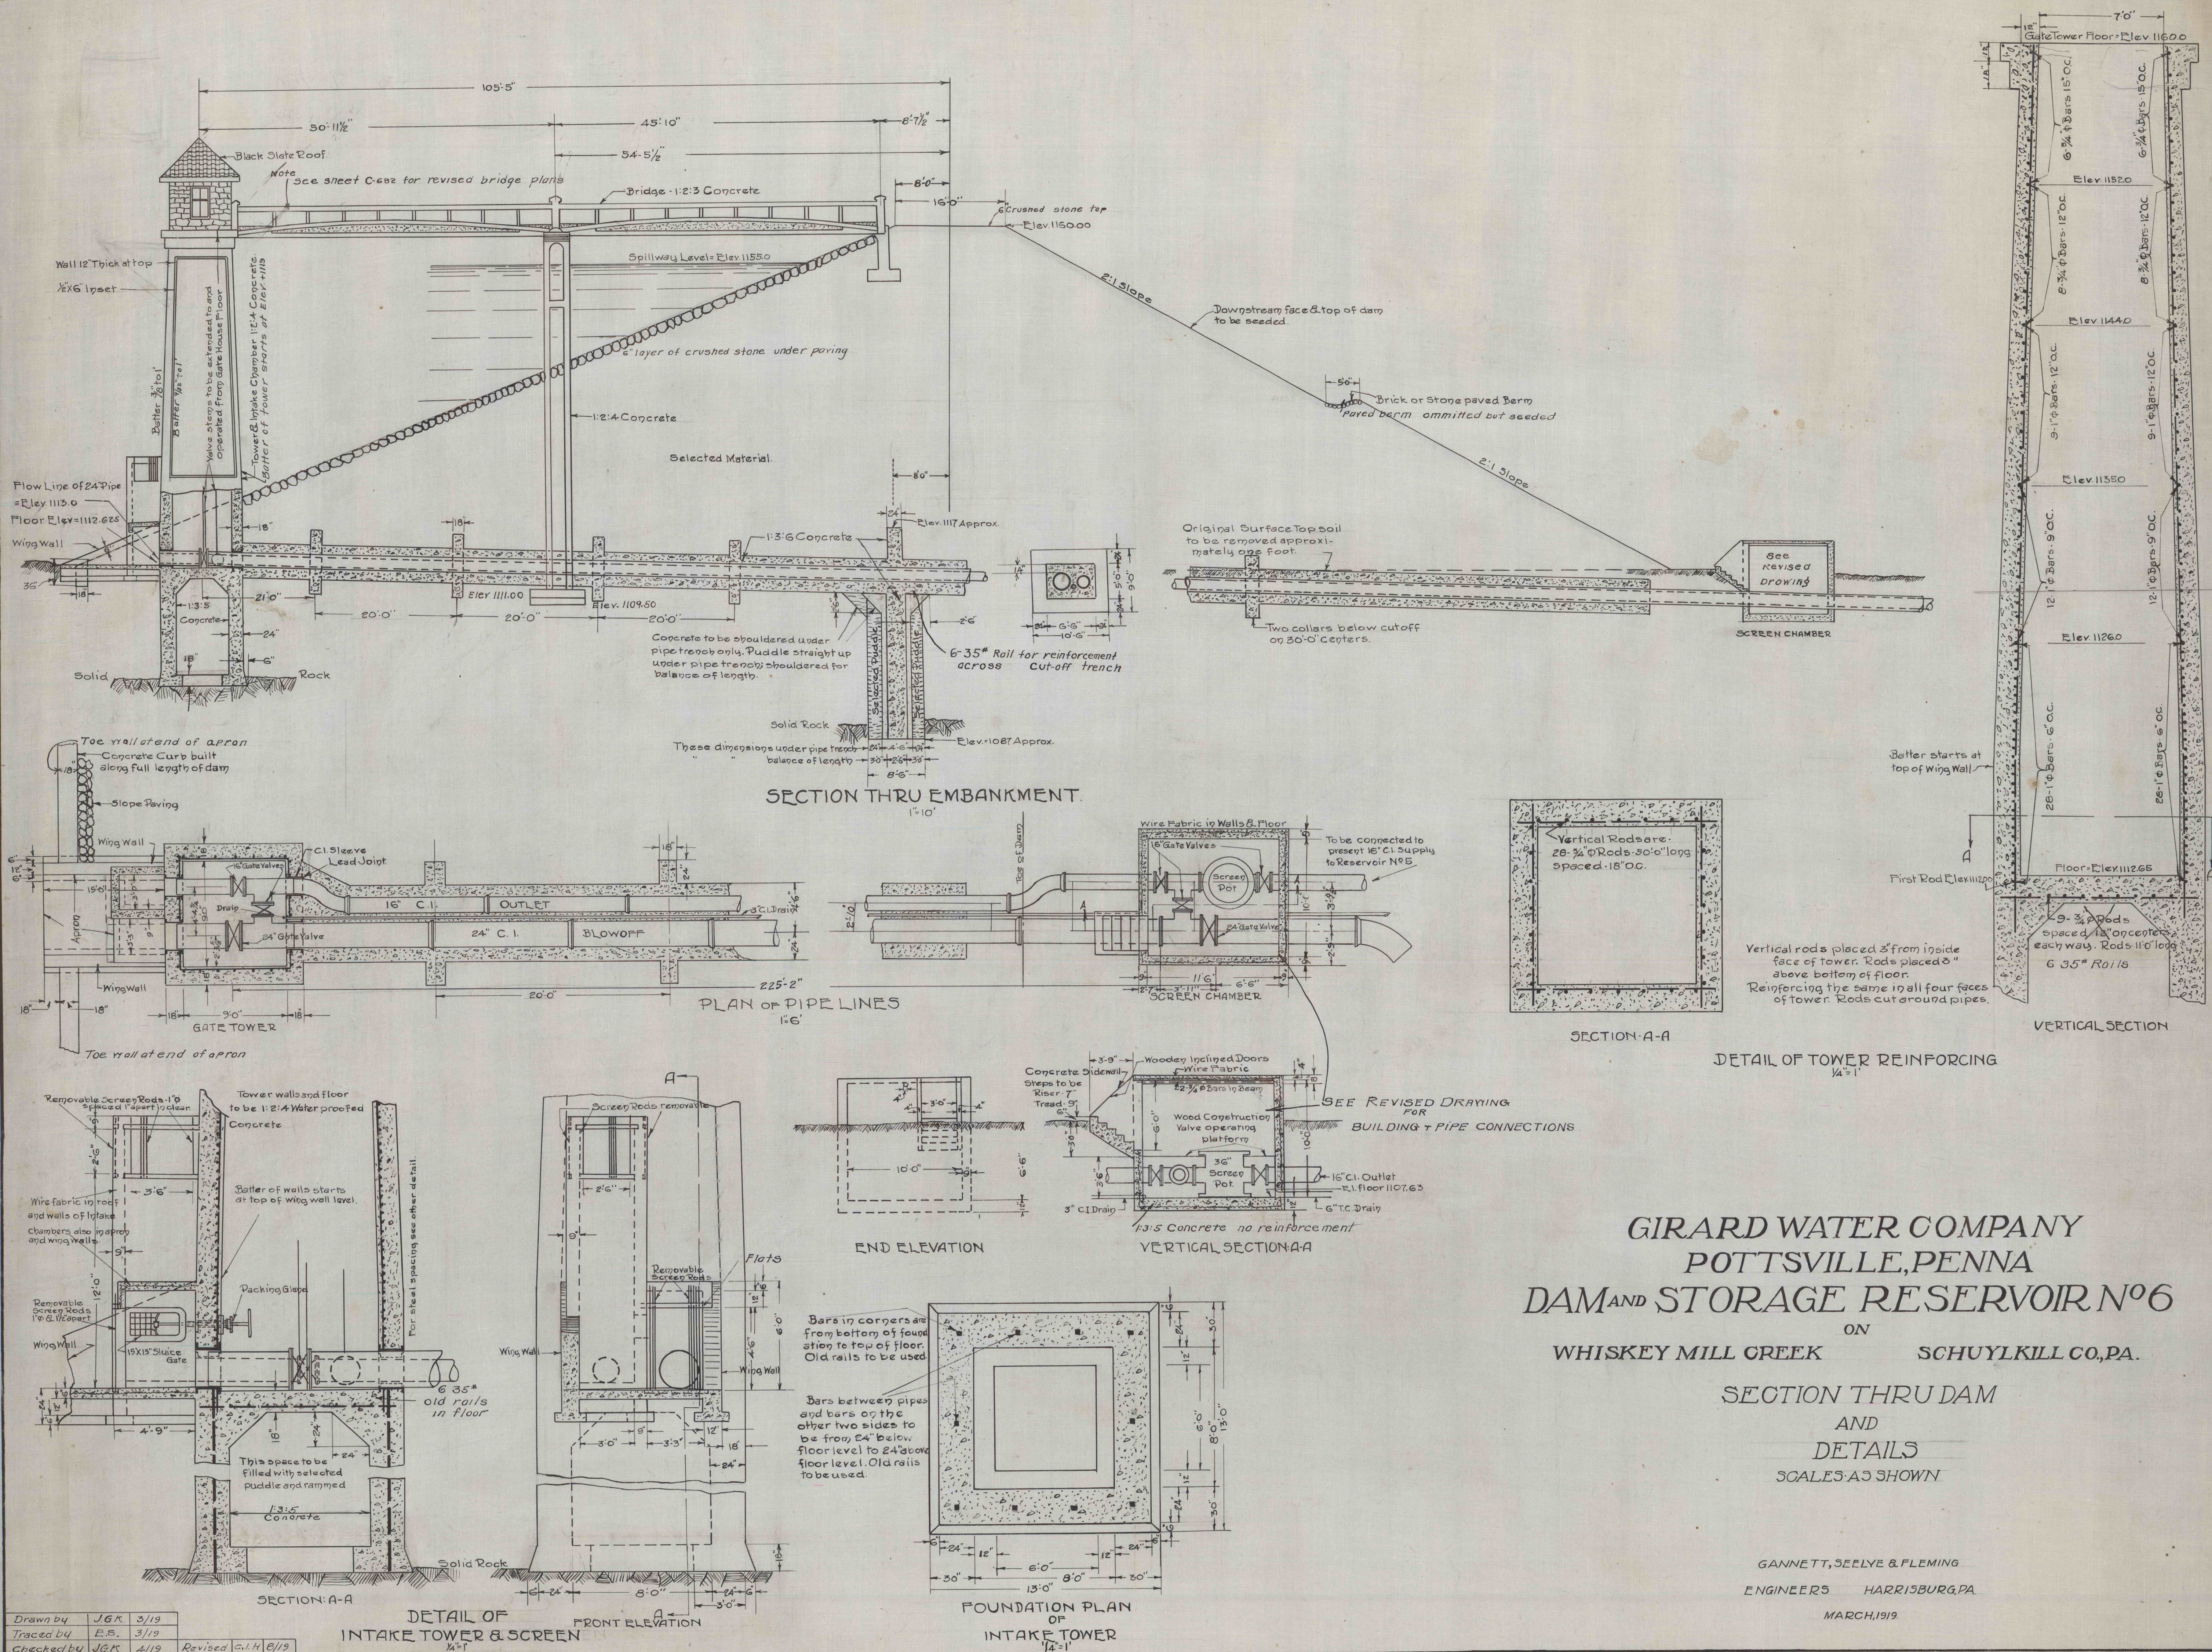

GIRARD WATER COMPANY
POTTSVILLE, PENNA
DAM AND STORAGE RESERVOIR NO. 6
 ON
WHISKEY MILL CREEK **SCHUYLKILL CO., PA.**
SECTION THRU DAM
 AND
DETAILS
 SCALES AS SHOWN

GANNETT, SEELYE & FLEMING
 ENGINEERS HARRISBURG, PA.
 MARCH, 1919

Drawn by J.G.R. 3/19
 Traced by E.S. 3/19
 Checked by J.G.R. 4/19 Revised C.H. 6/19