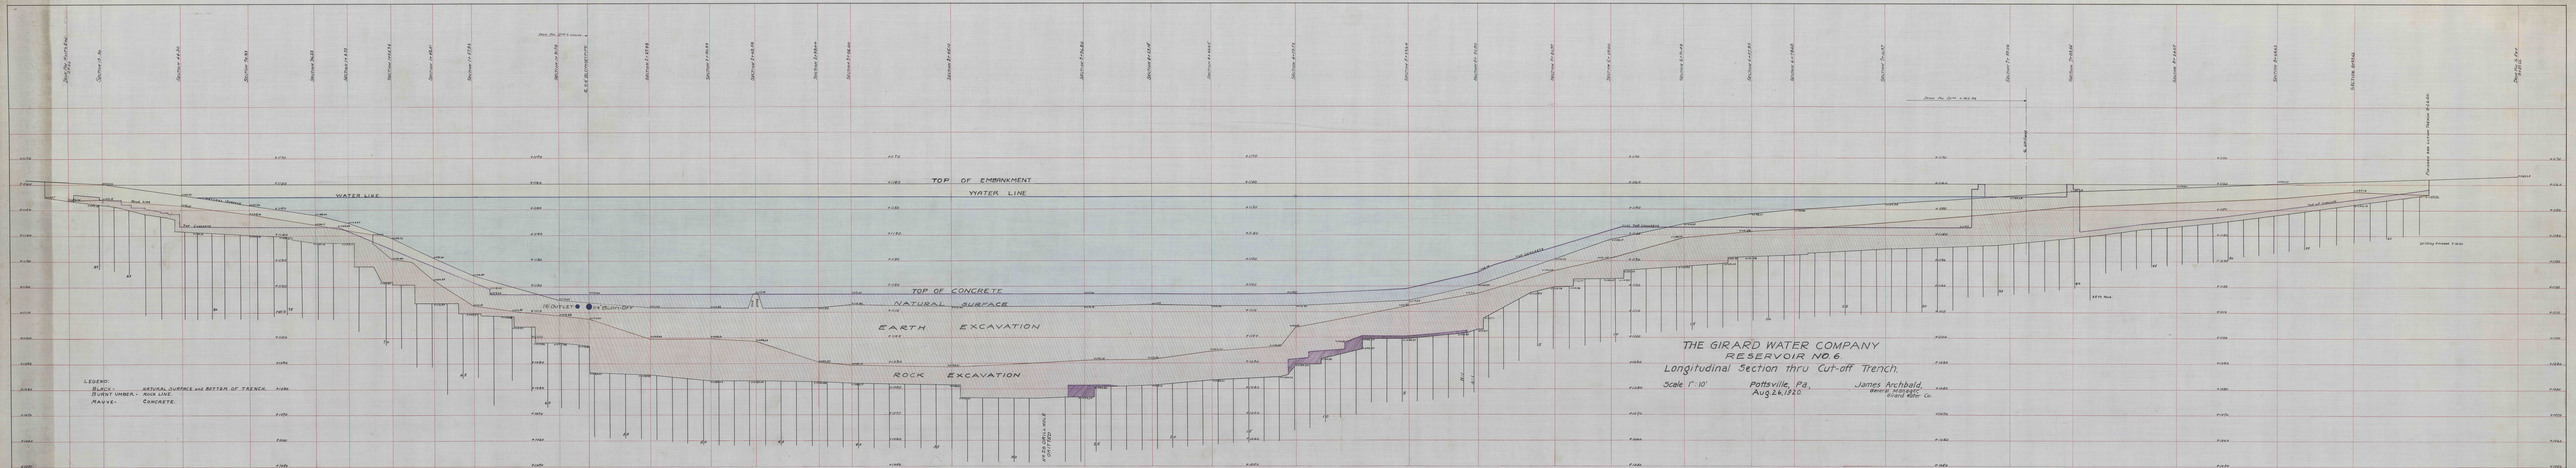

THE GIRARD WATER COMPANY
RESERVOIR NO. 6.
Longitudinal Section thru Cut-off Trench.
Scale 1" 10' Pottsville, Pa., Aug 2d, 1920. James Archbald, Engineer for Girard Water Co.