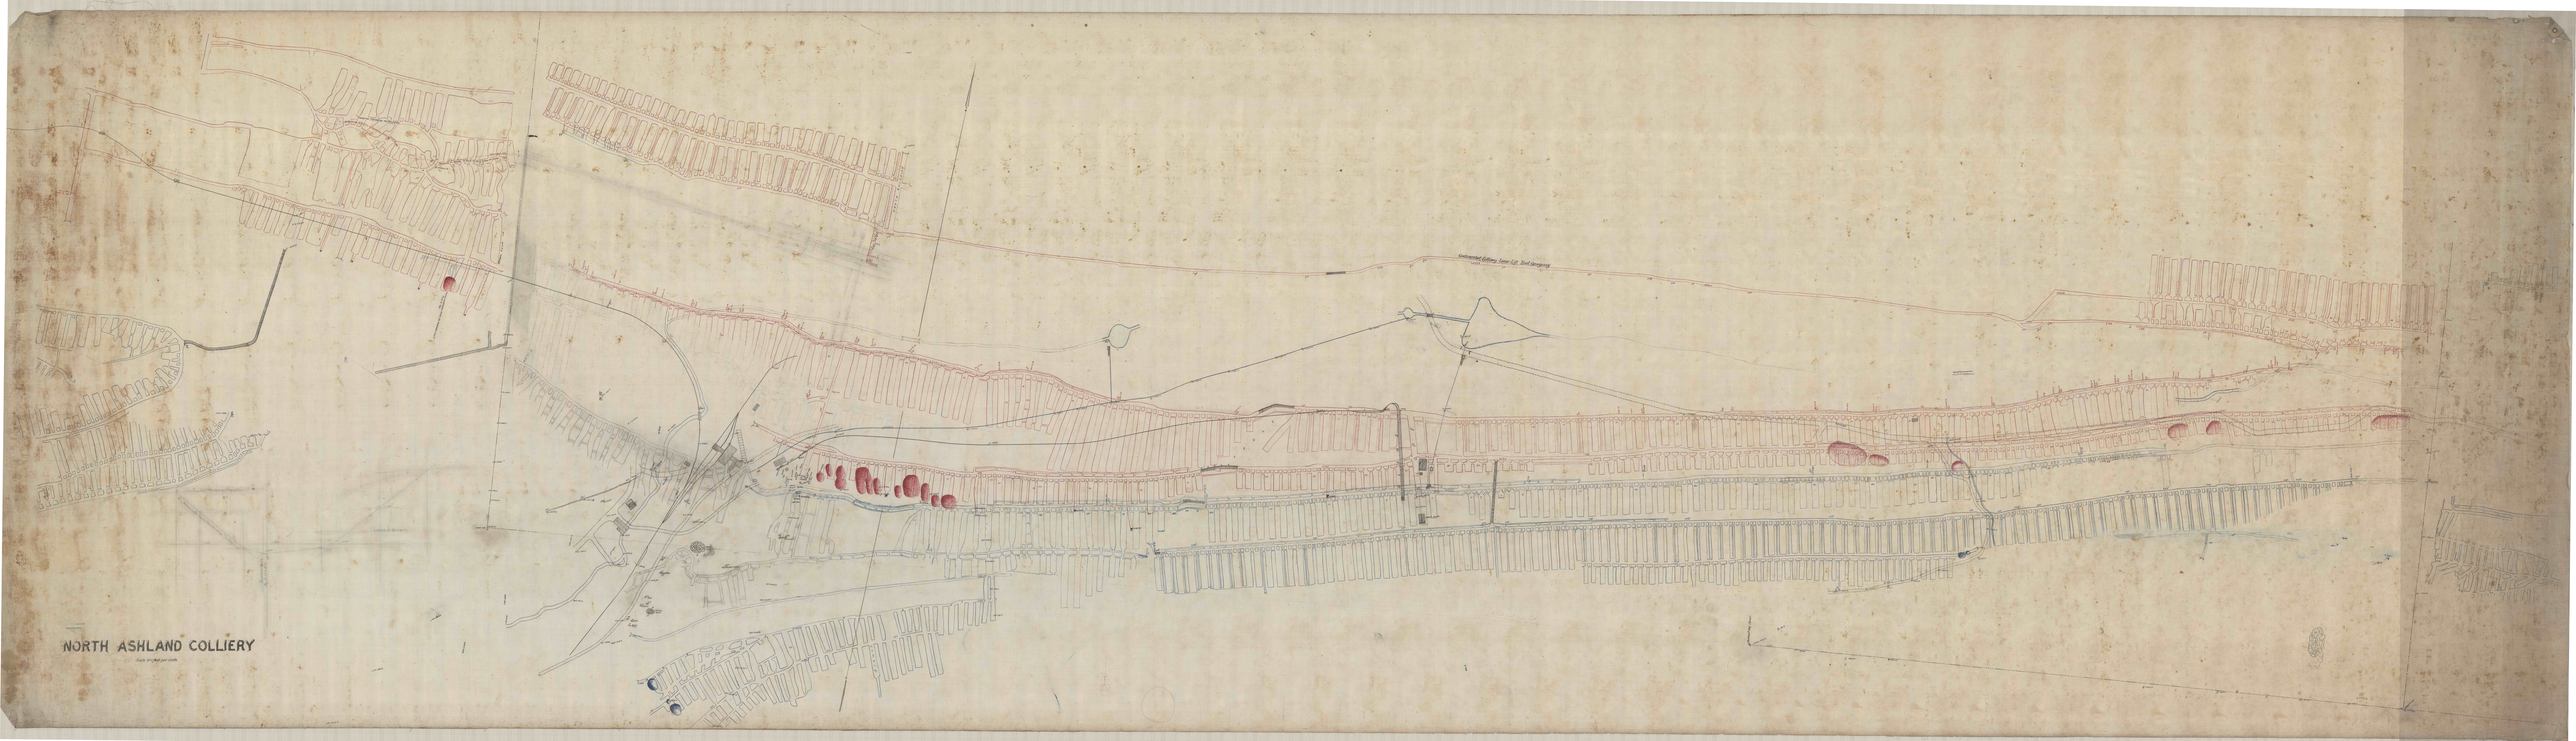

NORTH ASHLAND COLLIERY