


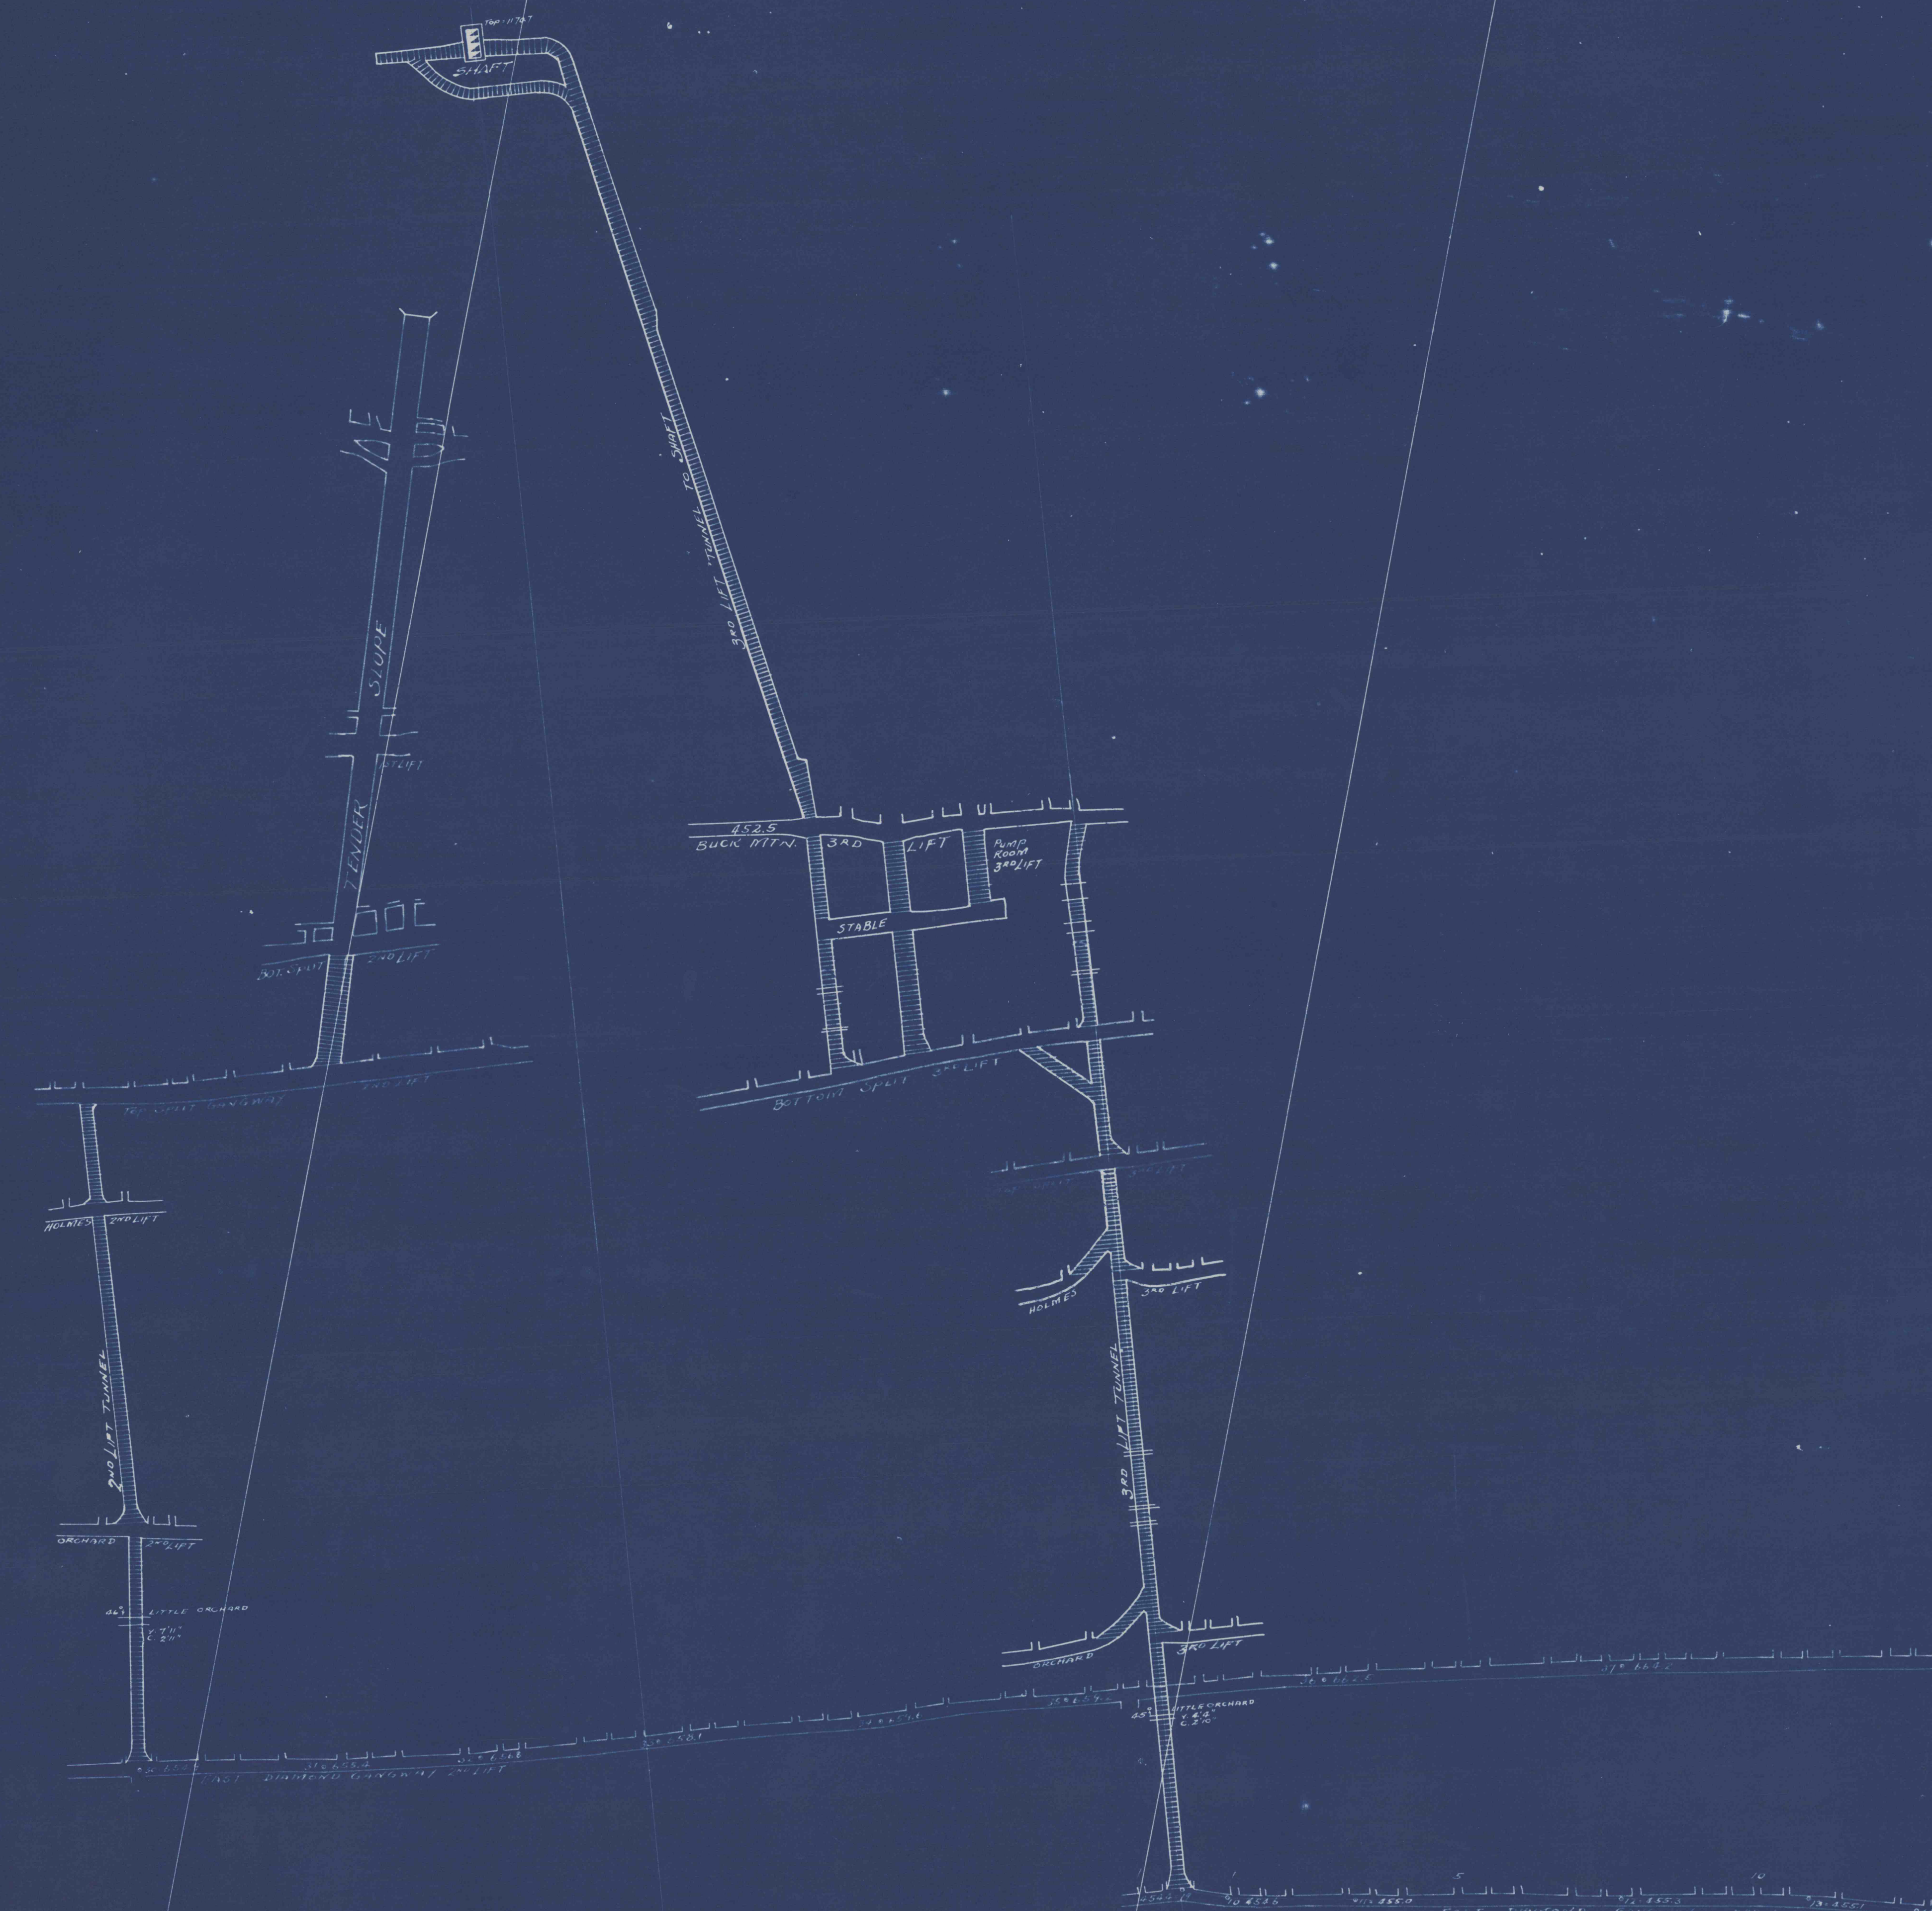

HAMMOND COLLIERY
LITTLE ORCHARD IN
SCALE 1" = 100'

