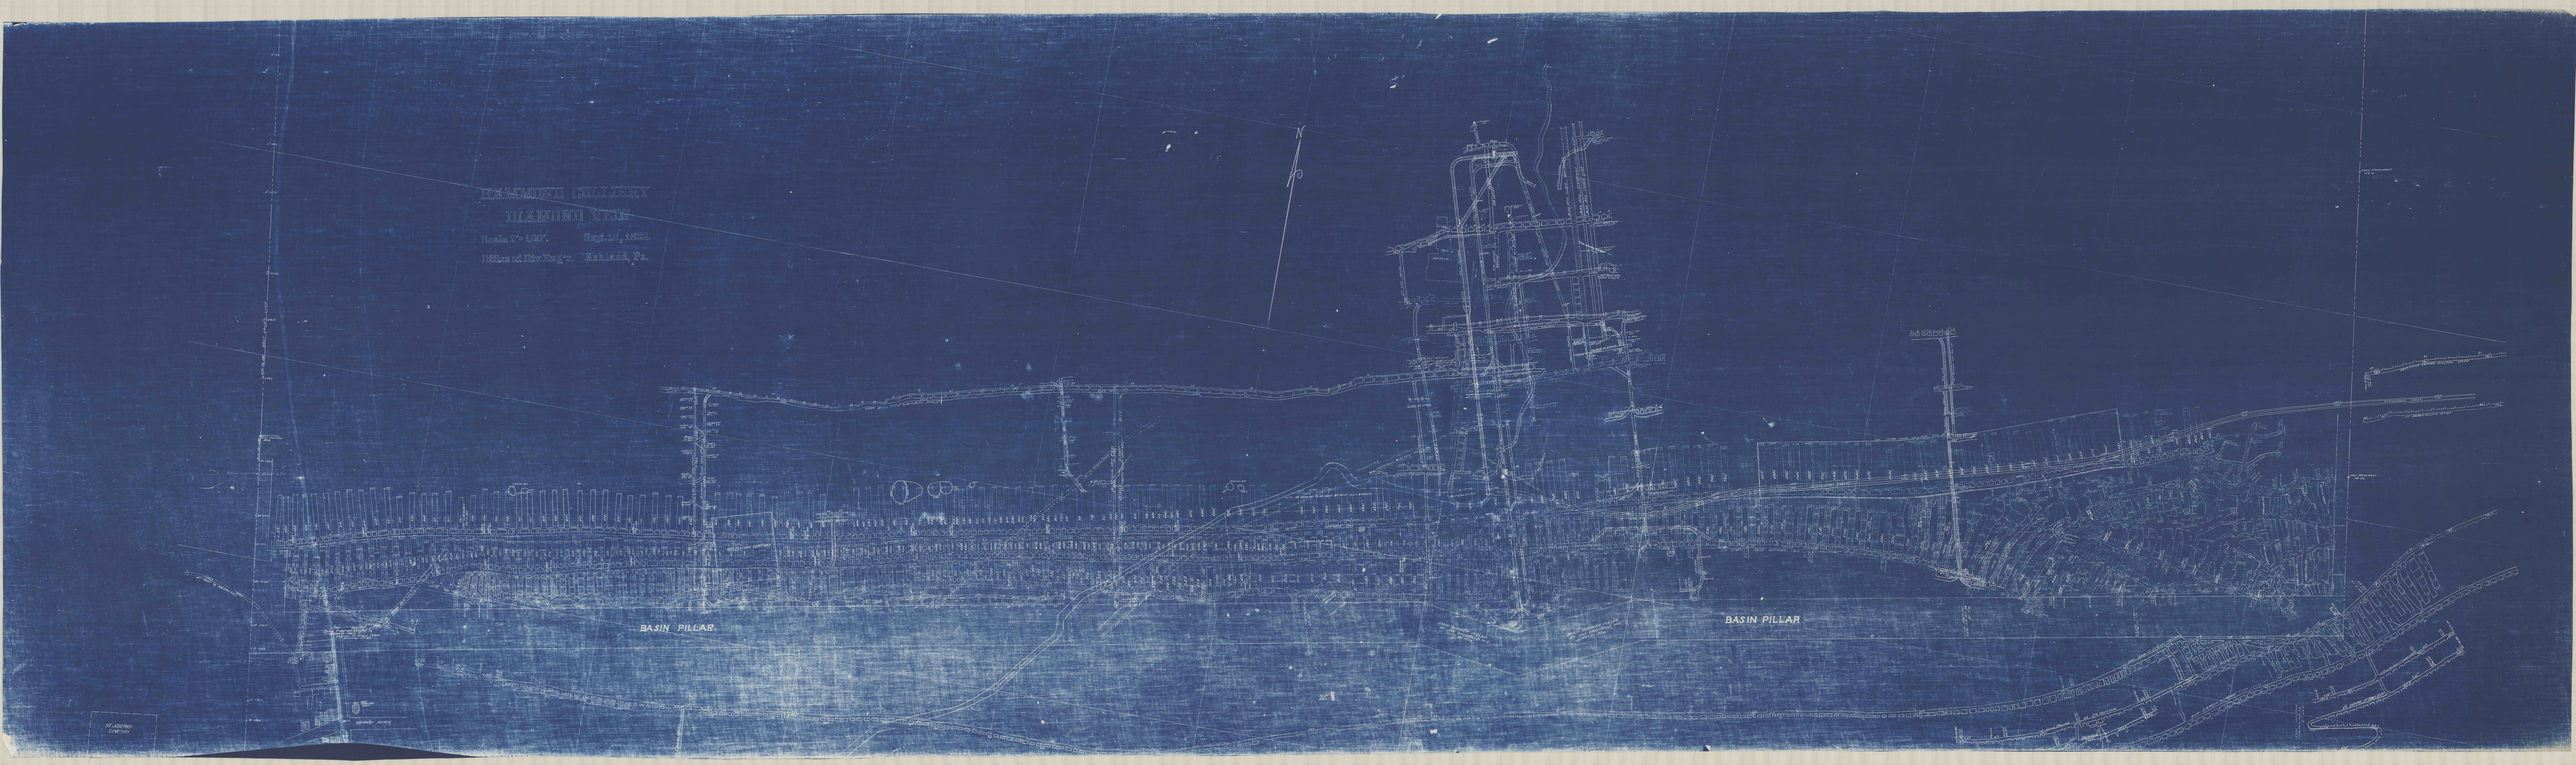
BASIN PILLAR
BASIN PILLAR