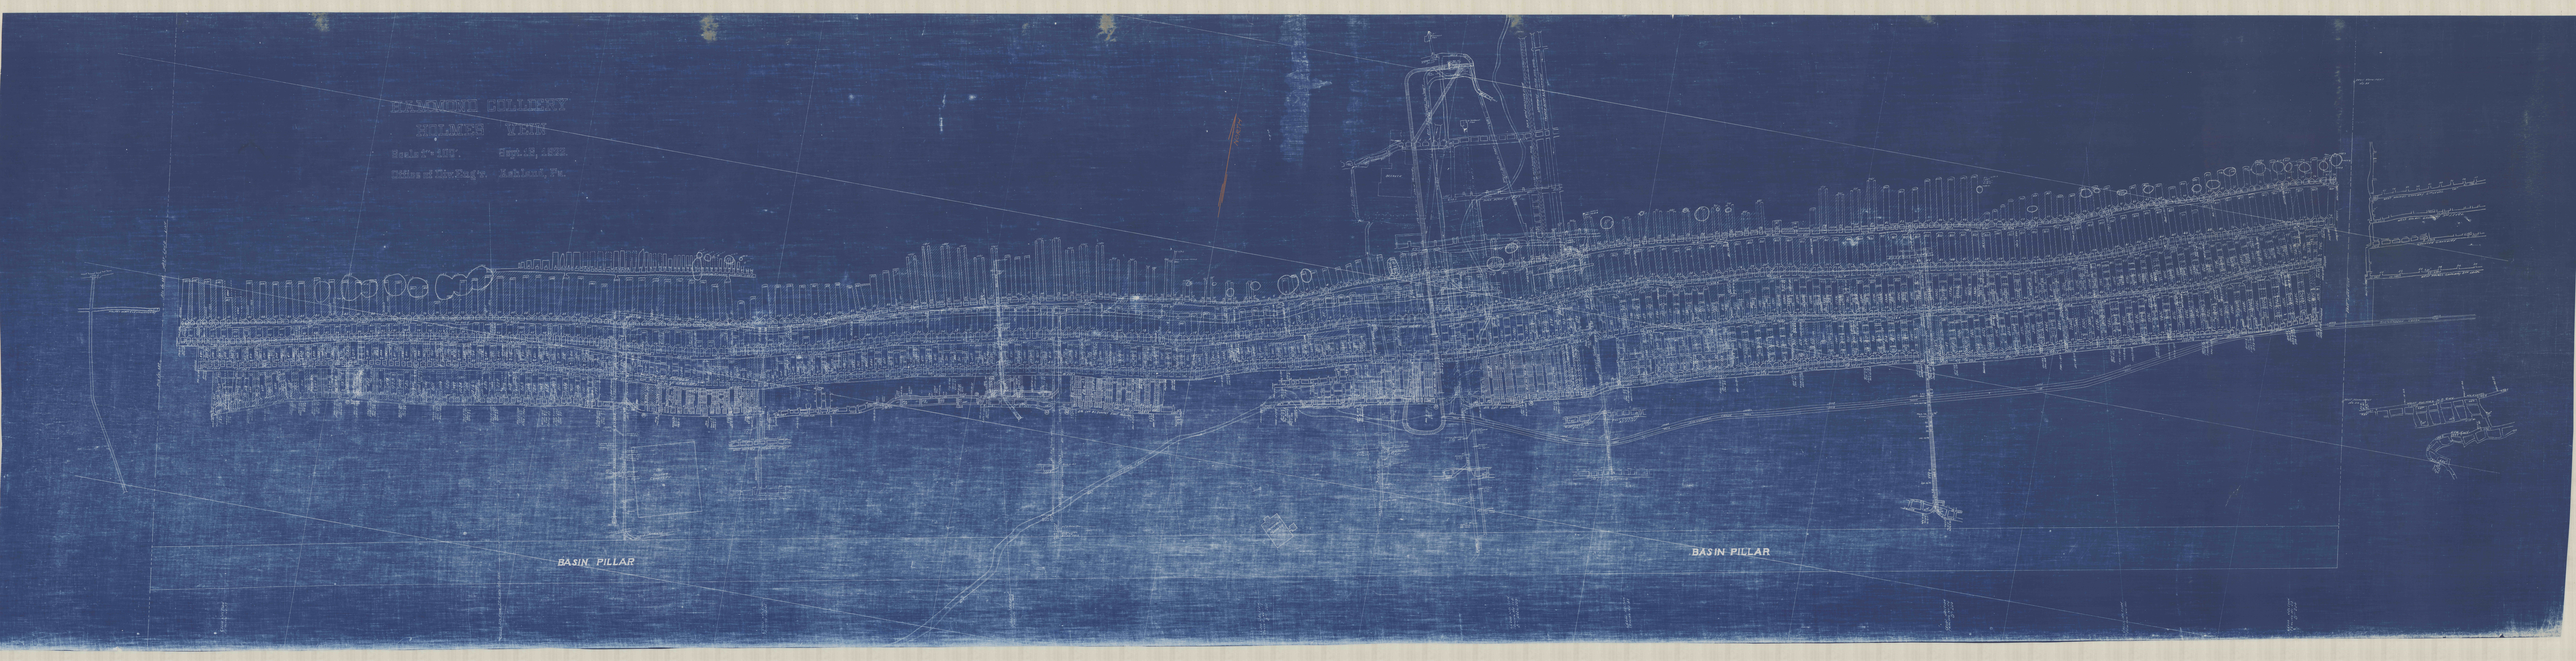

BASIN PILLAR
BASIN PILLAR