


Sketch #4.

JOHN BRADY TRACT

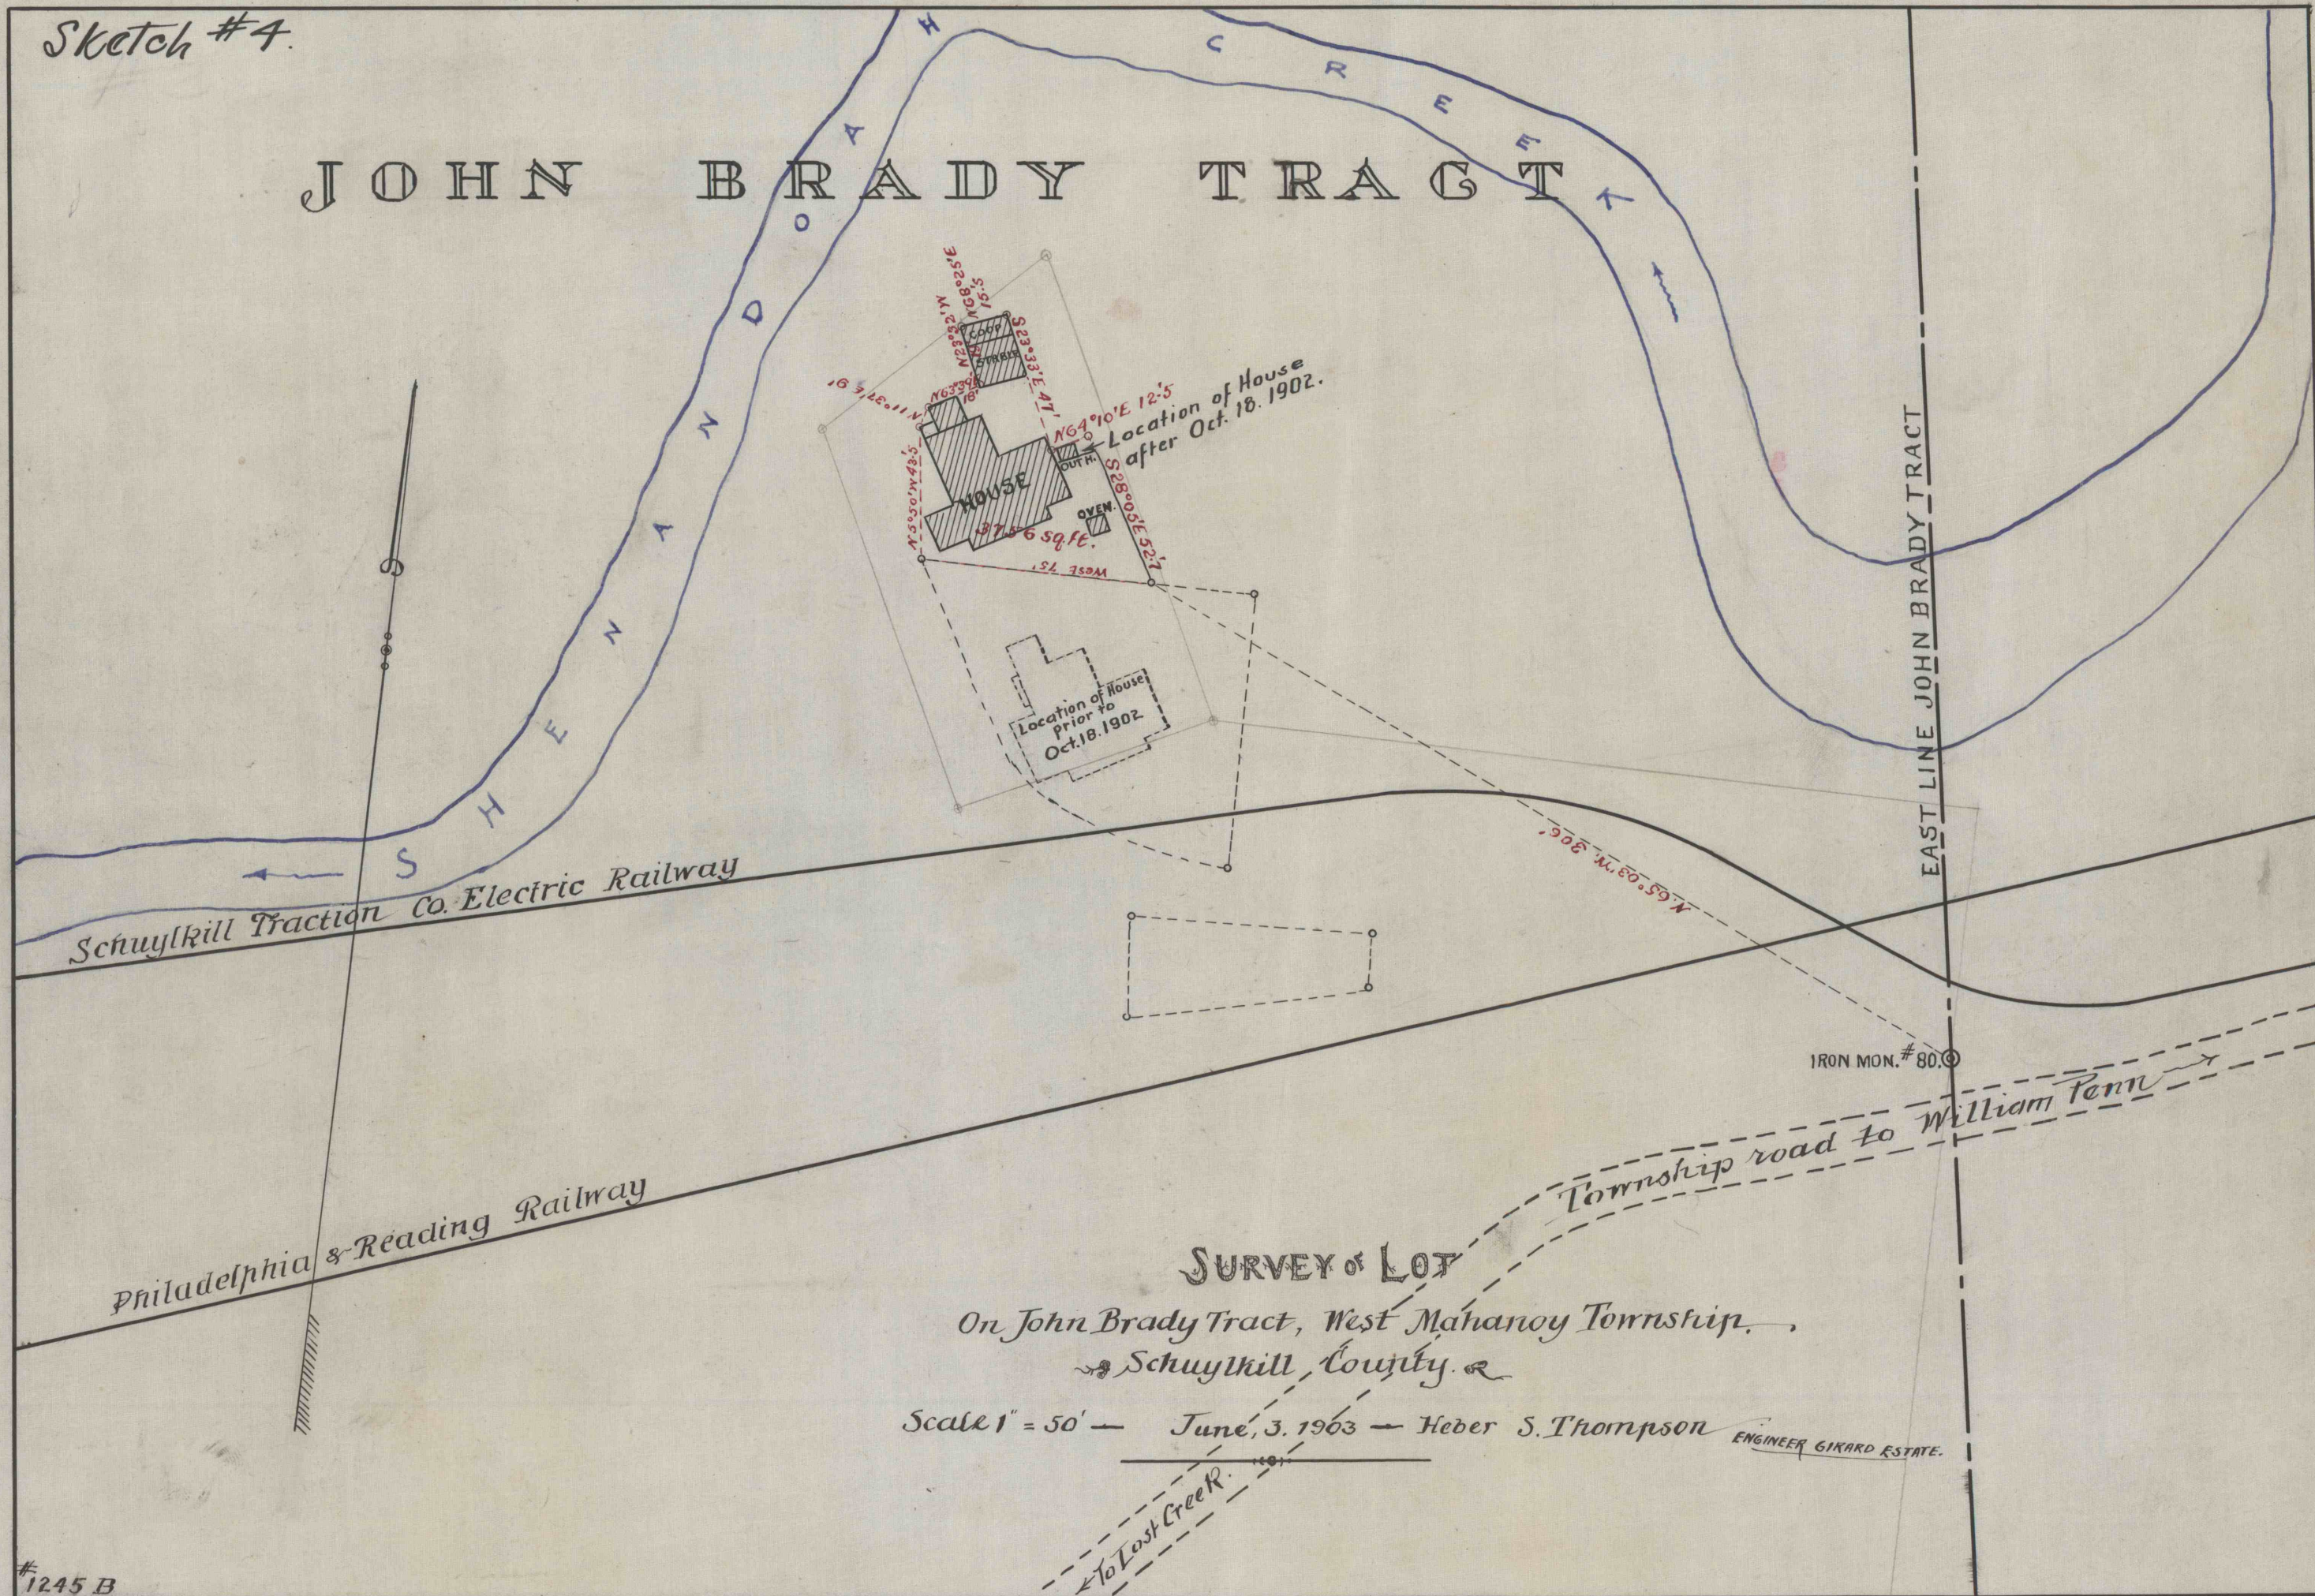

SURVEY OF LOT

On John Brady Tract, West Mahanoy Township,

Schuylkill County, Pa.

Scale 1" = 50' — June, 3, 1903 — Heber S. Thompson

ENGINEER GIKARD ESTATE.

To Last Creek R.