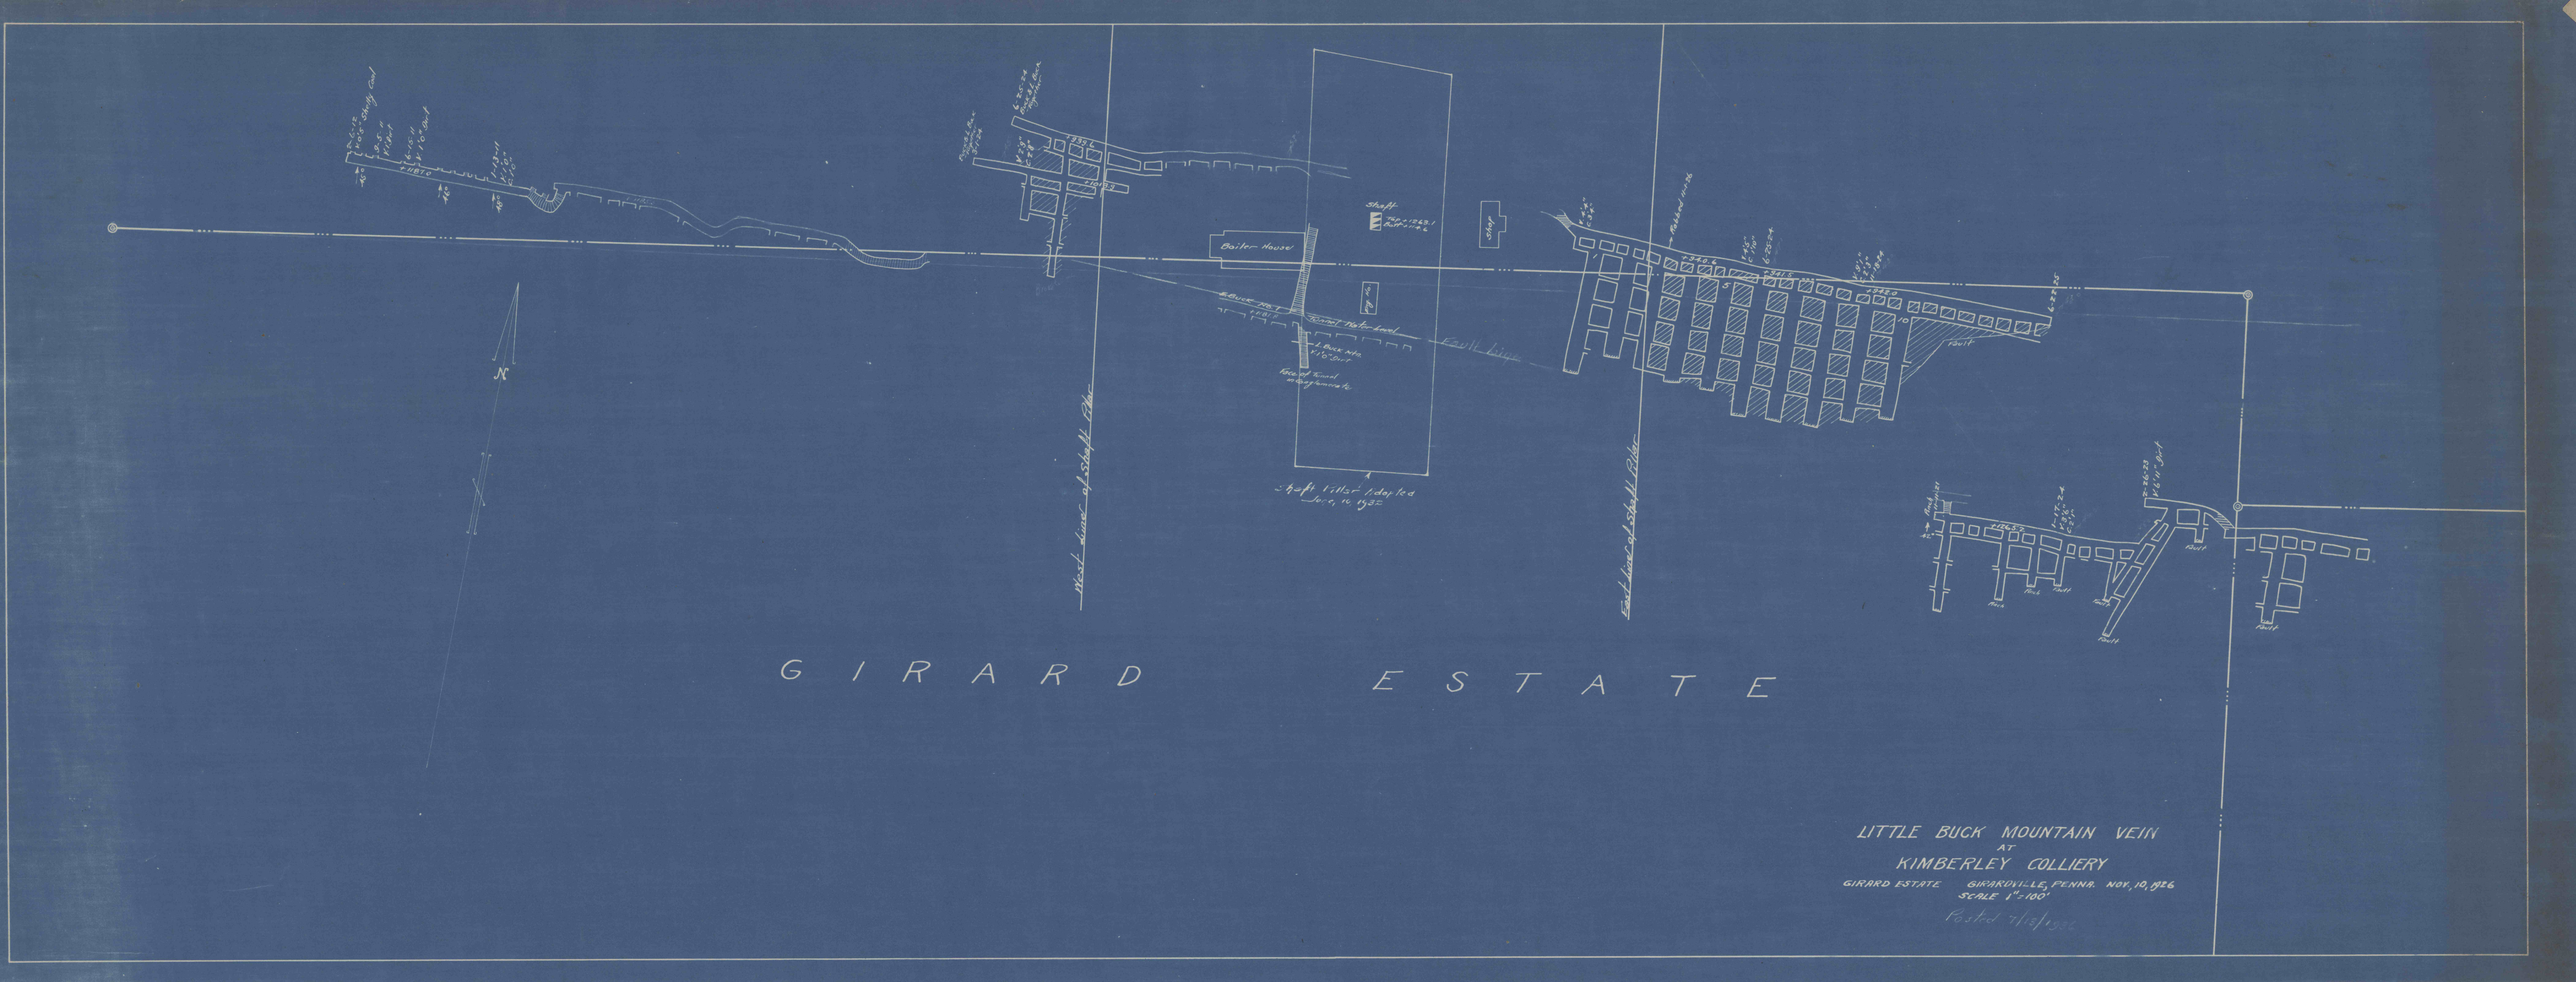
Shaft
Boiler House
Shop
Tunnel Water level
Fault
Fault
Fault
Fault
Fault
Fault
Fault
West boundary of Shaft Pillar
East boundary of Shaft Pillar
Shaft Pillar Adopted
June 16, 1932
N
GIRARD ESTATE
LITTLE BUCK MOUNTAIN VEIN
AT
KIMBERLEY COLLIERY
GIRARD ESTATE GIRARDVILLE, PENNA. NOV. 10, 1926
SCALE 1" = 100'
Posted 7/12/1932