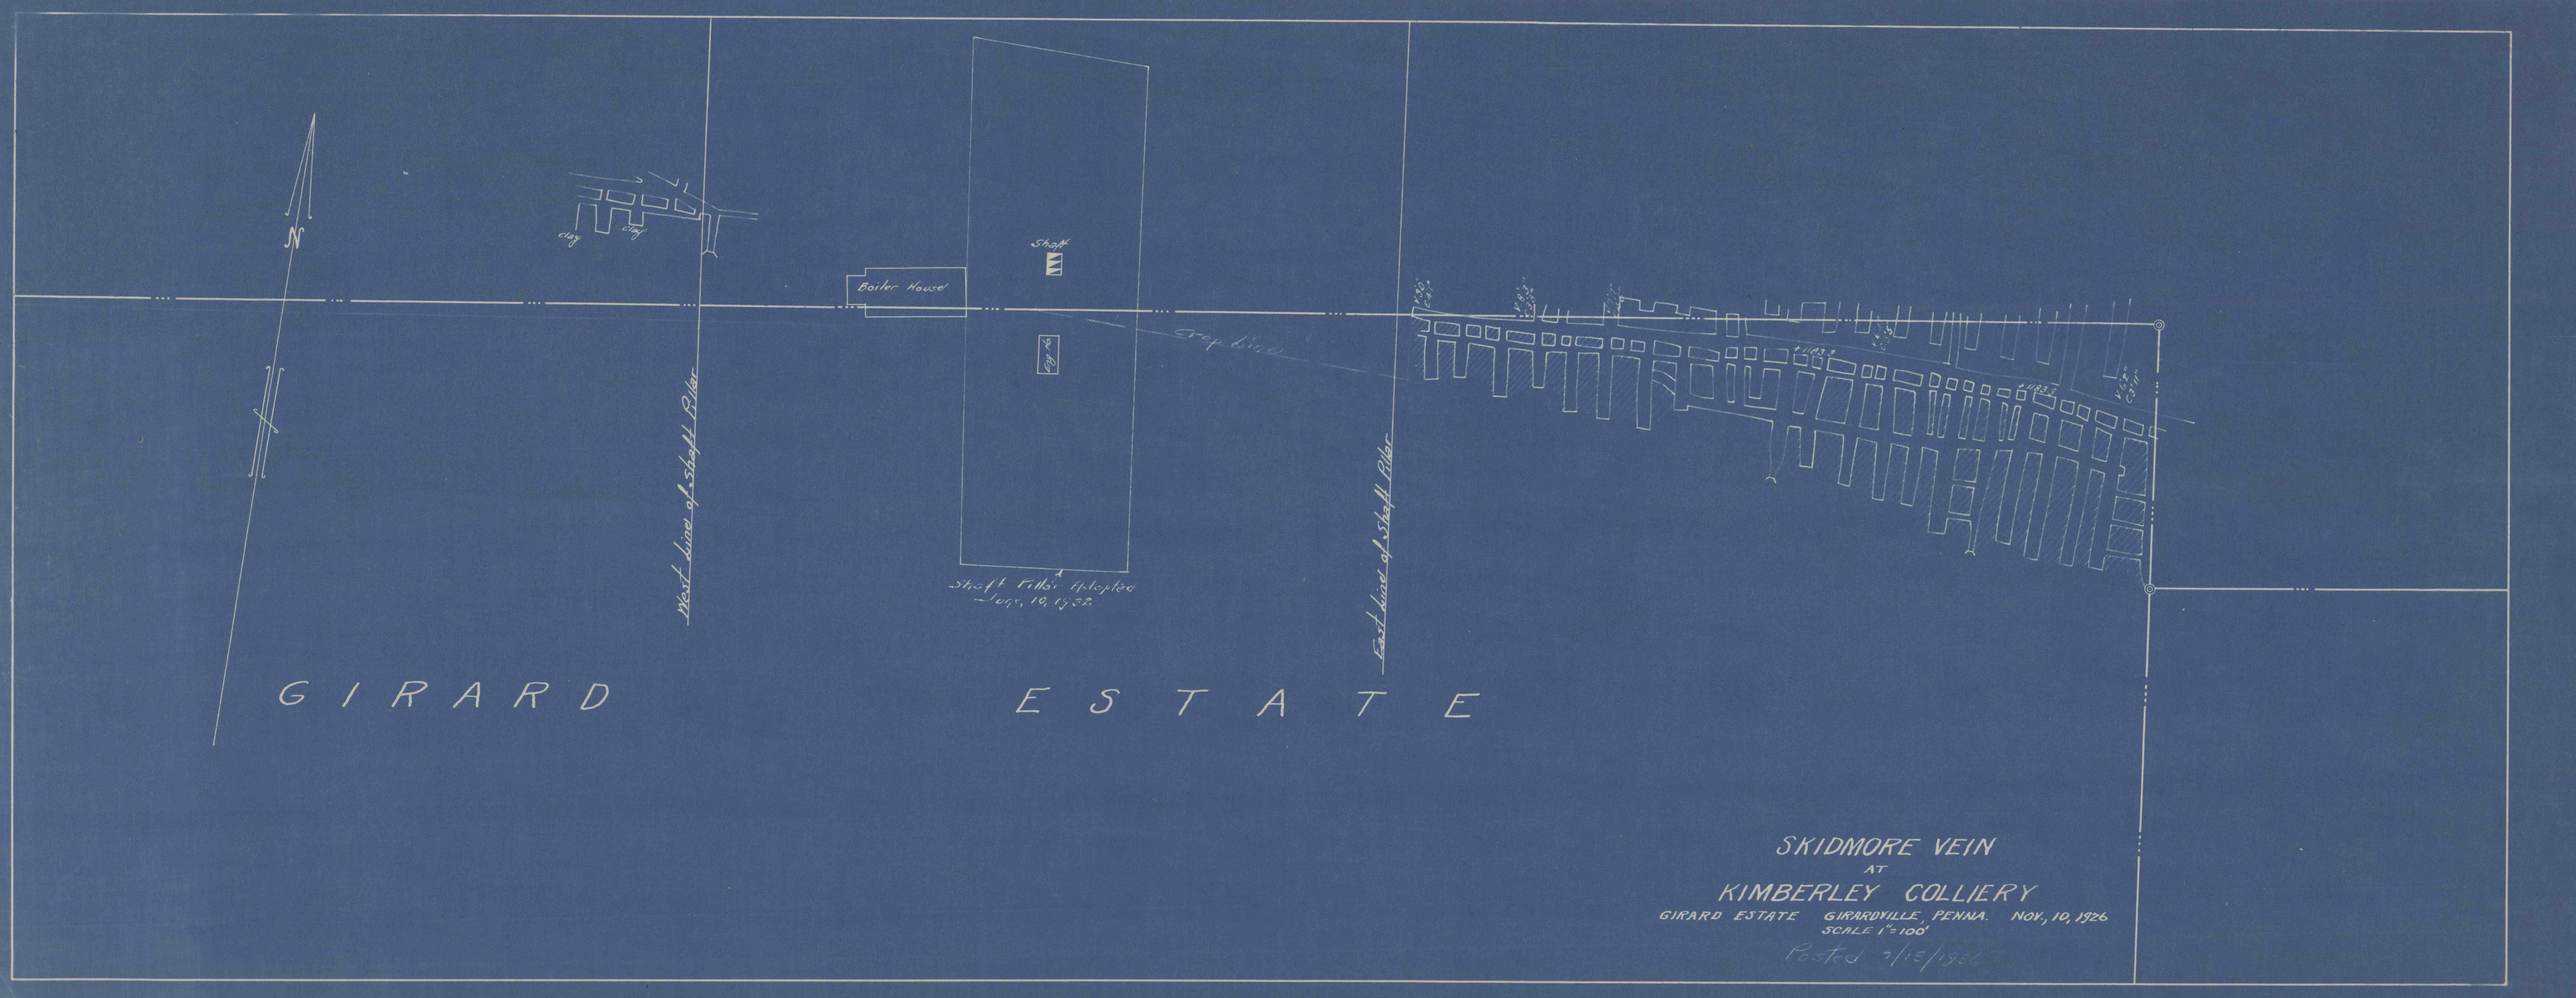
N
clay
clay
Boiler House
Shaft
clay
Shaft Filled Up Aug. 10, 1932
West line of Shaft Pillar
East line of Shaft Pillar
GIRARD ESTATE
SKIDMORE VEIN
AT
KIMBERLEY COLLIERY
GIRARD ESTATE GIRARDVILLE, PENNA. NOV. 10, 1926
SCALE 1" = 100'
Posted 7/13/1928