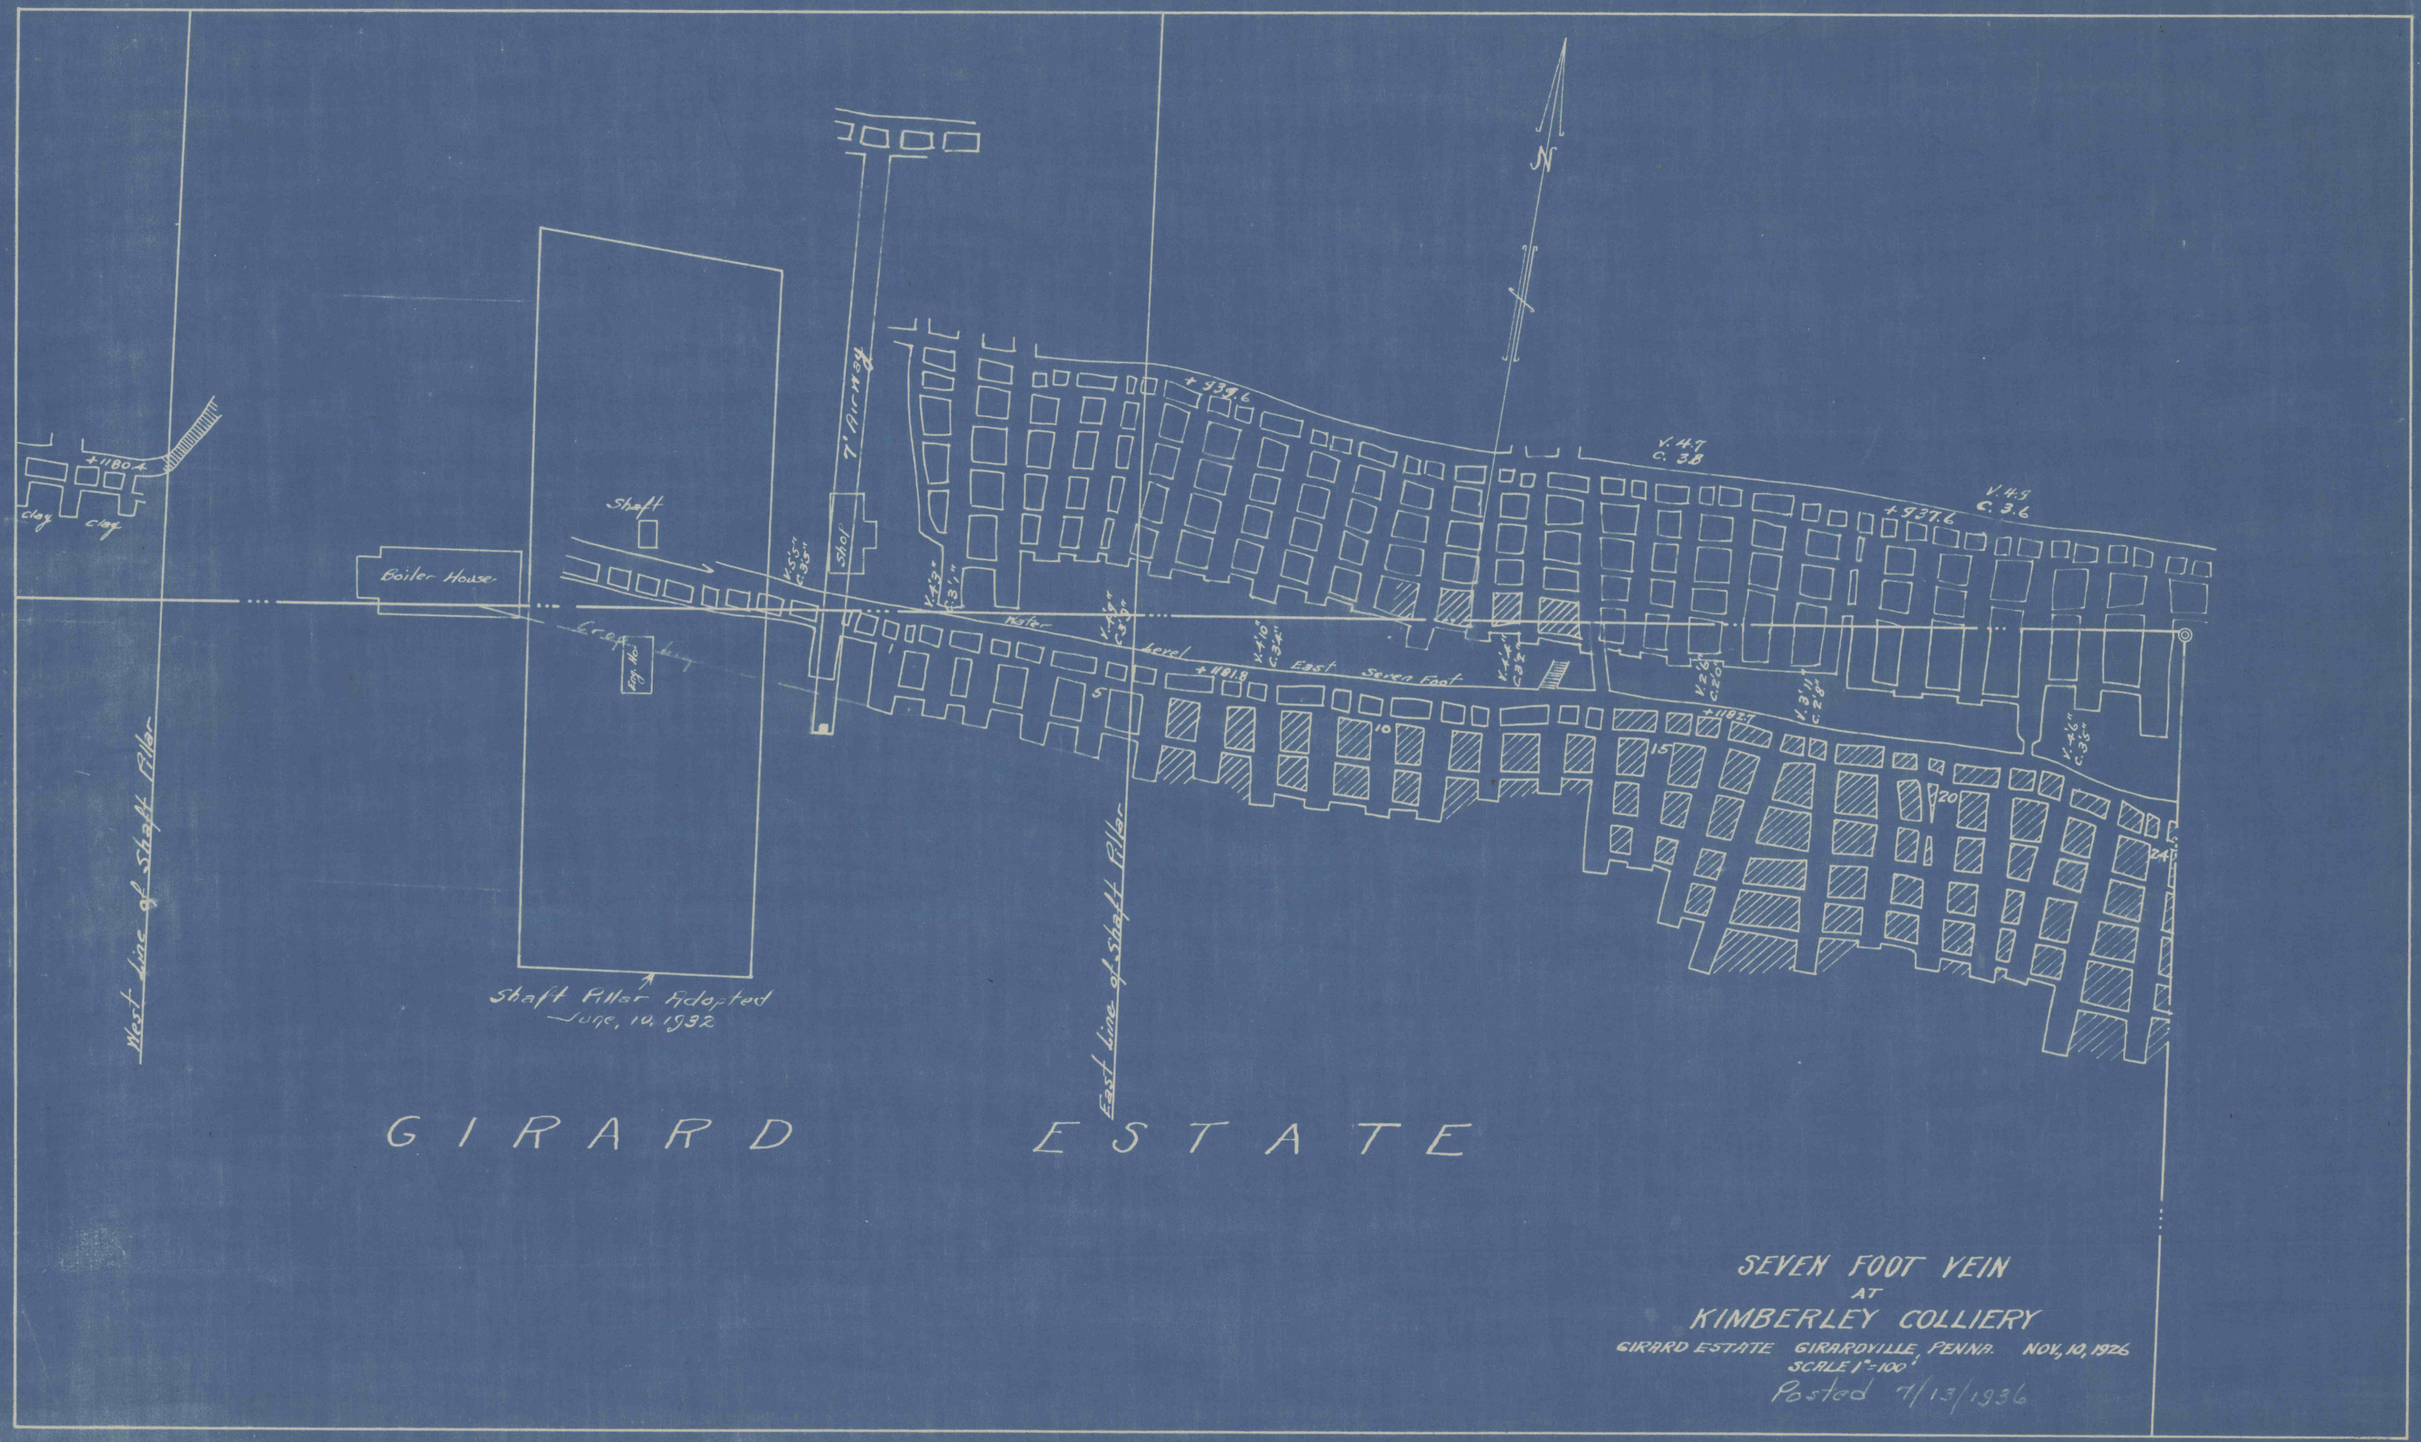
+1180.4
clay
clay
Boiler House
Shaft
7' Airway
Shaft
Water level
East Seven Foot
+1181.8
+1192.7
+939.6
+937.6
V. 4.7
C. 3.8
V. 4.3
C. 3.6
5
10
15
20
24
West line of shaft Pillar
East line of shaft Pillar
Shaft Pillar Adopted
June, 10, 1932
GIRARD ESTATE
SEVEN FOOT VEIN
AT
KIMBERLEY COLLIERY
GIRARD ESTATE GIRARDVILLE, PENNA. NOV, 10, 1926
SCALE 1"=100'
Posted 7/13/1936