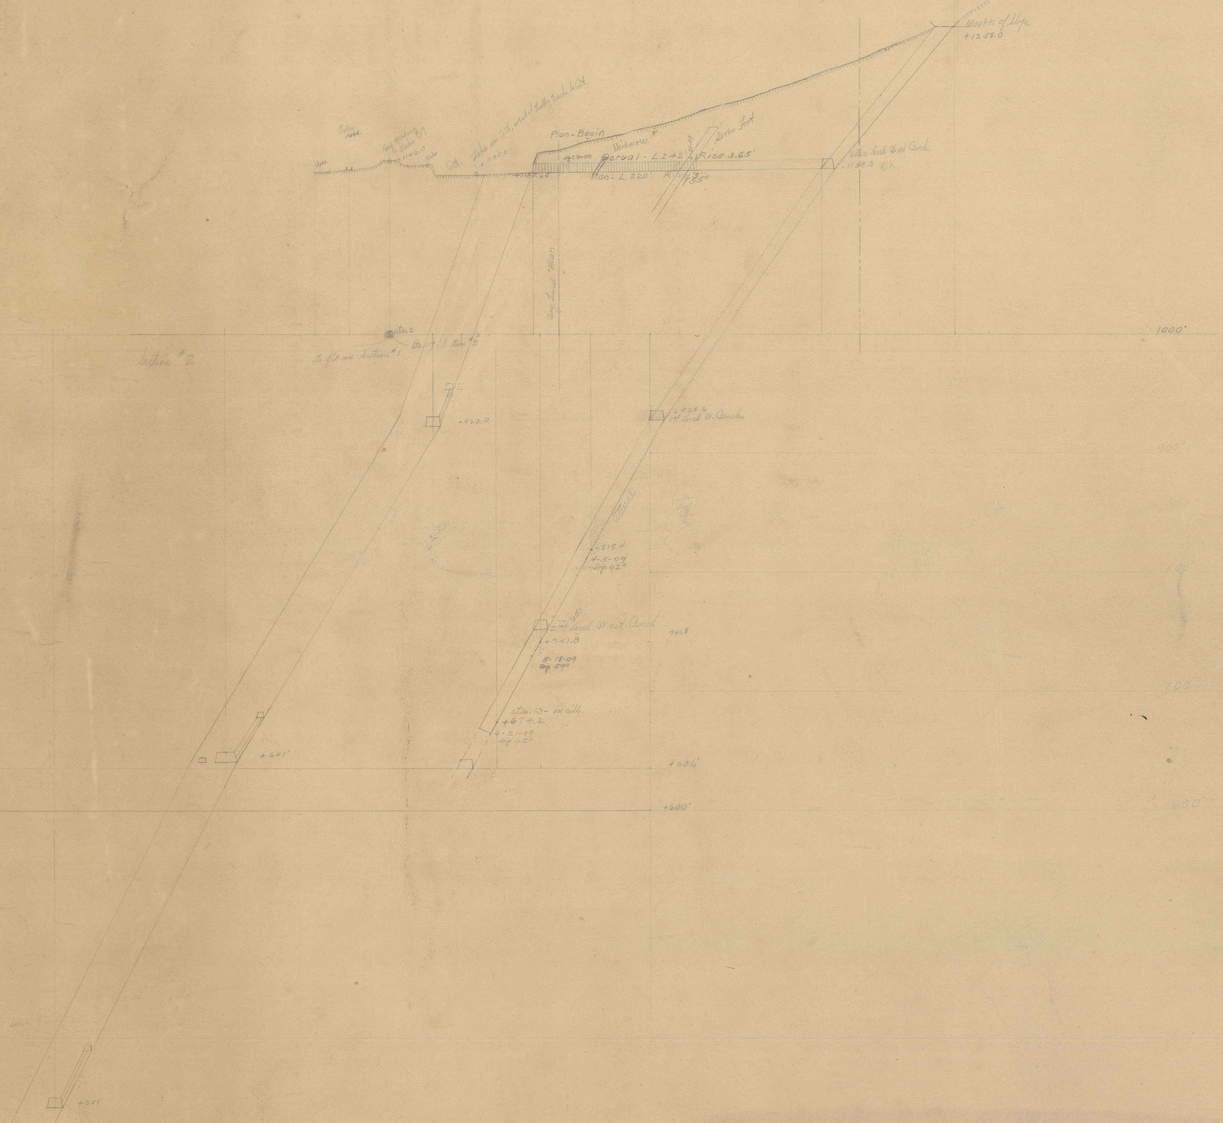

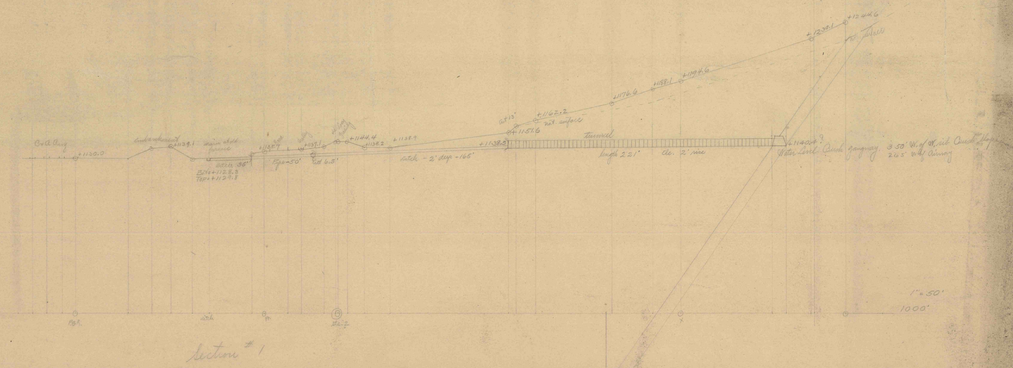

Section #1