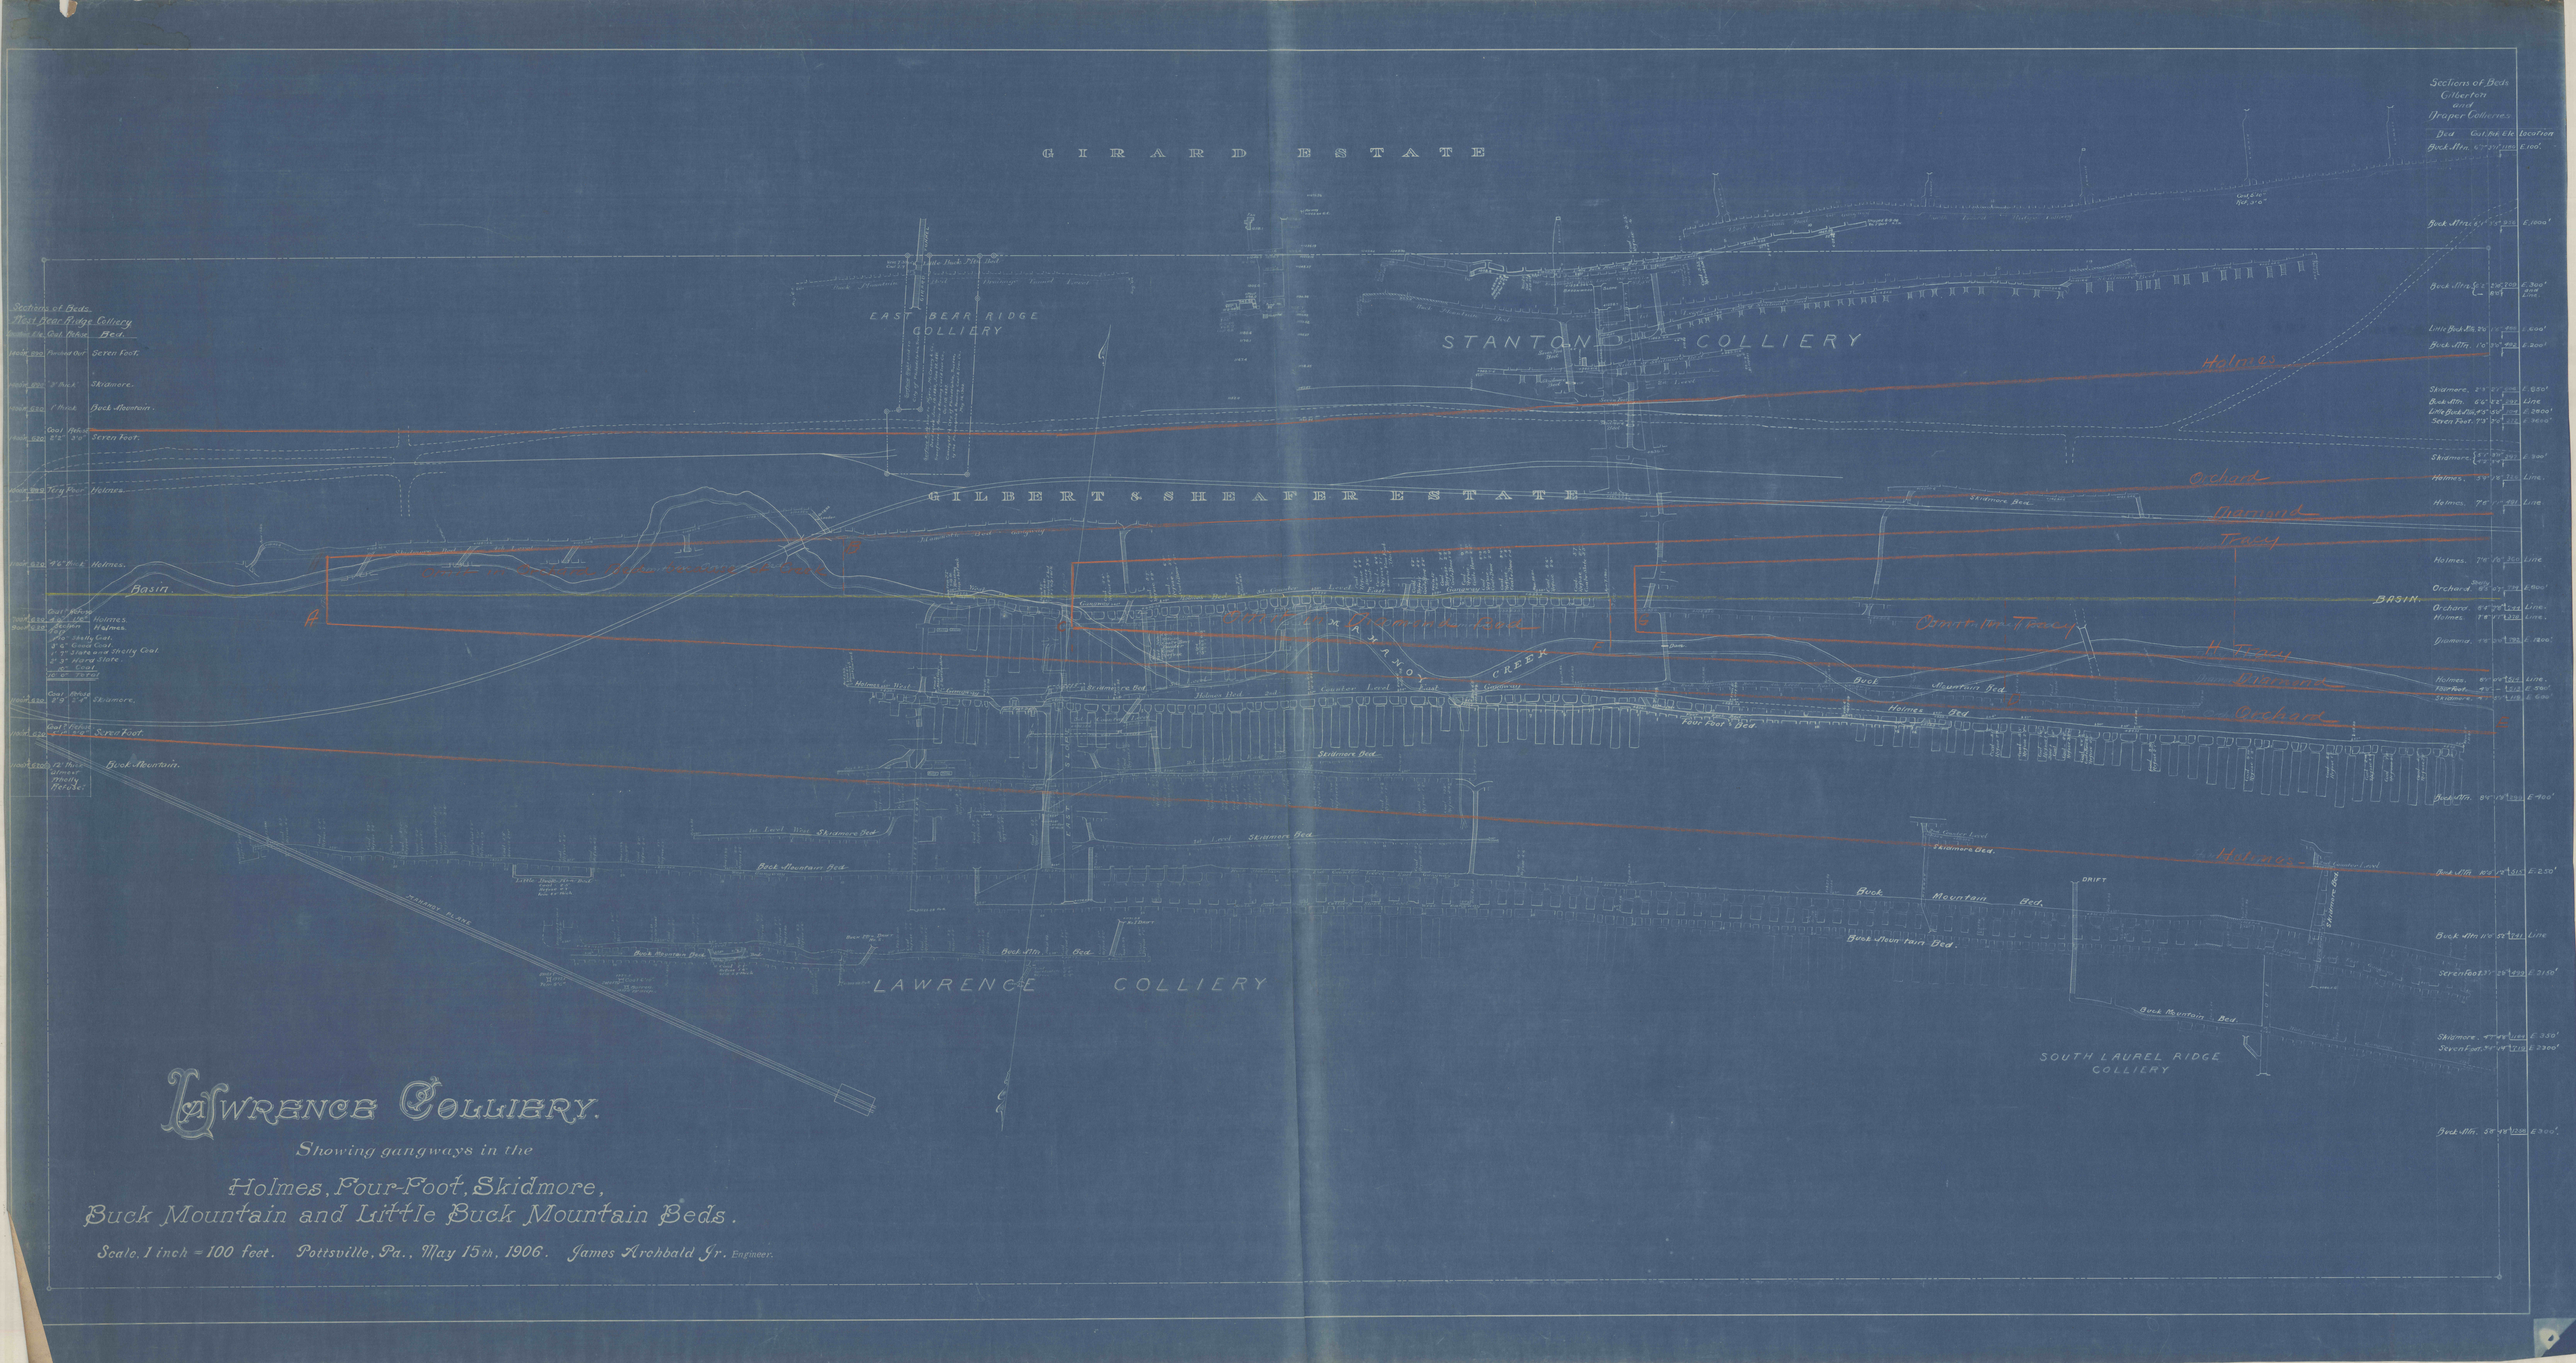
GIRARD ESTATE
EAST BEAR RIDGE COLLIERY
STANTON COLLIERY
GILBERT & SHEAFER ESTATE
Holmes
Orchard
Diamond
Tracy
BASIN
Four Foot Bed
Skidmore Bed
Buck Mountain Bed
Four Foot V Bed
SAXON CREEK
LAWRENCE COLLIERY
SOUTH LAUREL RIDGE COLLIERY
DRIFT
Sections of Beds East Bear Ridge Colliery
Sections of Beds Gilberton and Draper Collieries
Lawrence Colliery.
Showing gangways in the
Holmes, Four-Foot, Skidmore,
Buck Mountain and Little Buck Mountain Beds.
Scale, 1 inch = 100 feet. Pottsville, Pa., May 15th, 1906. James Archbald Jr. Engineer.