


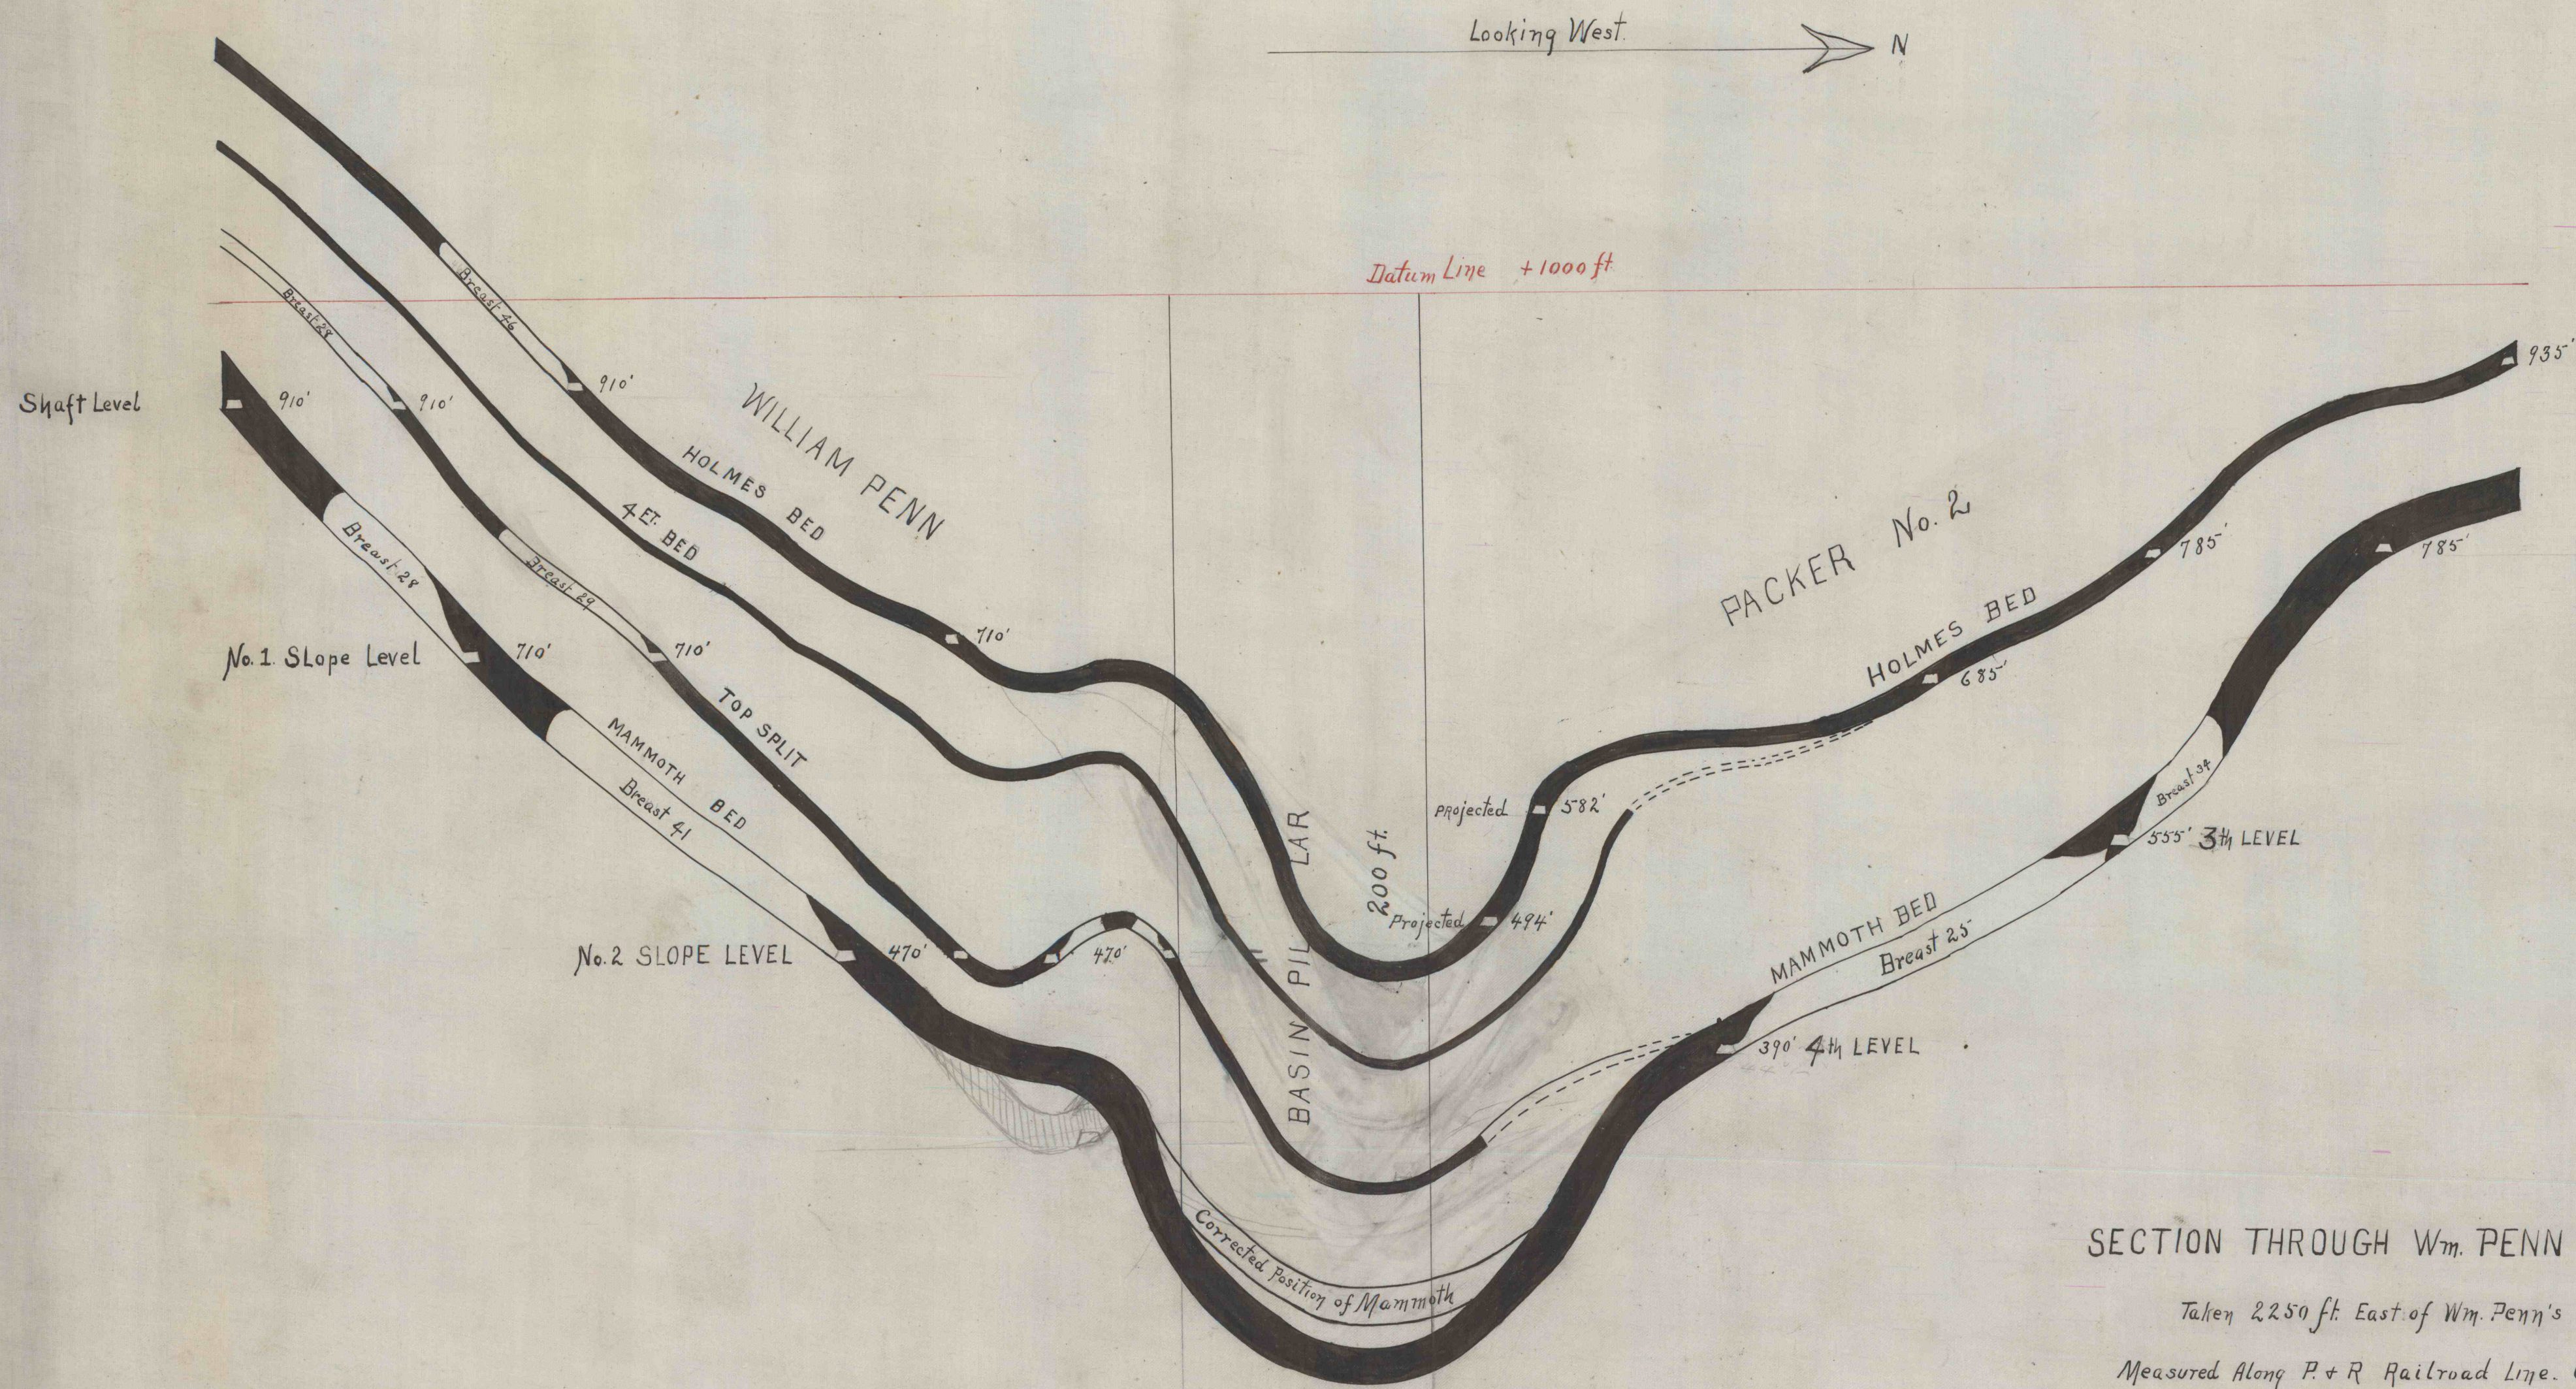

SECTION THROUGH Wm. PENN AND PACKER No. 2

Taken 2250 ft. East of Wm. Penn's Western Lease Limit

Measured Along P. & R. Railroad Line. Course S. 9° 27' E.

Showing Position of Four Foot & Holmes Beds on No. 2 Slope Level

With Reference to Basin Pillar

Scale 1" = 100'

Pottsville Pa.

October 1st. 1896

Heber S. Thompson
Engineer.