



Section on Line A.

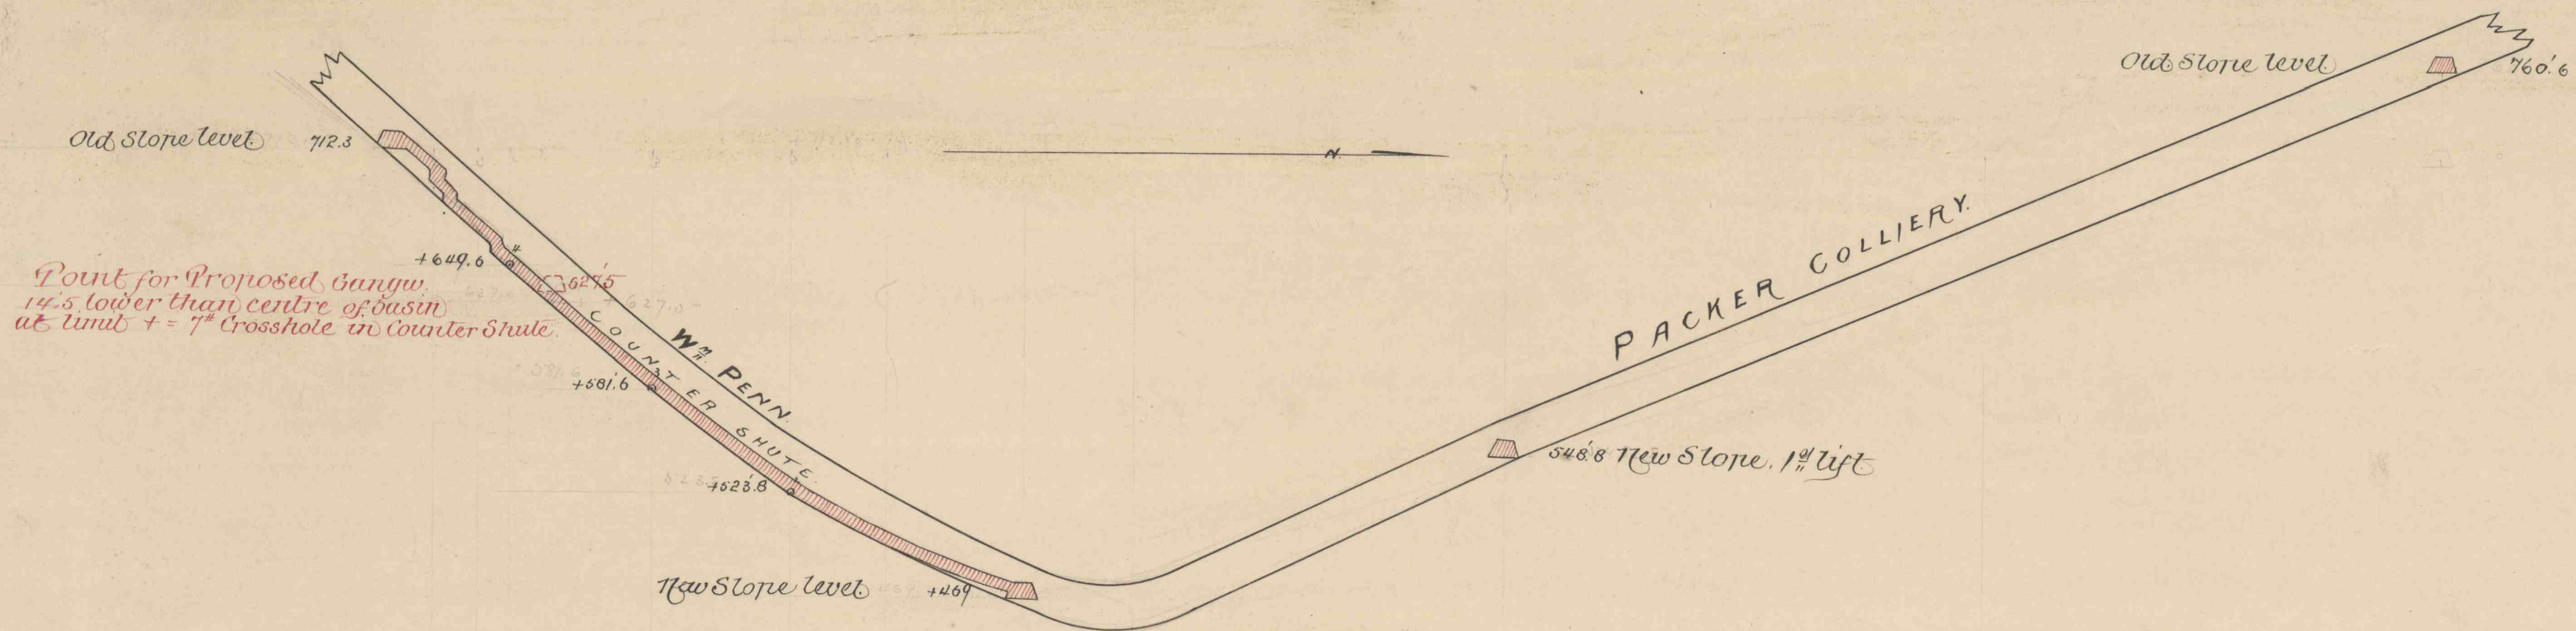

Section on Line B.

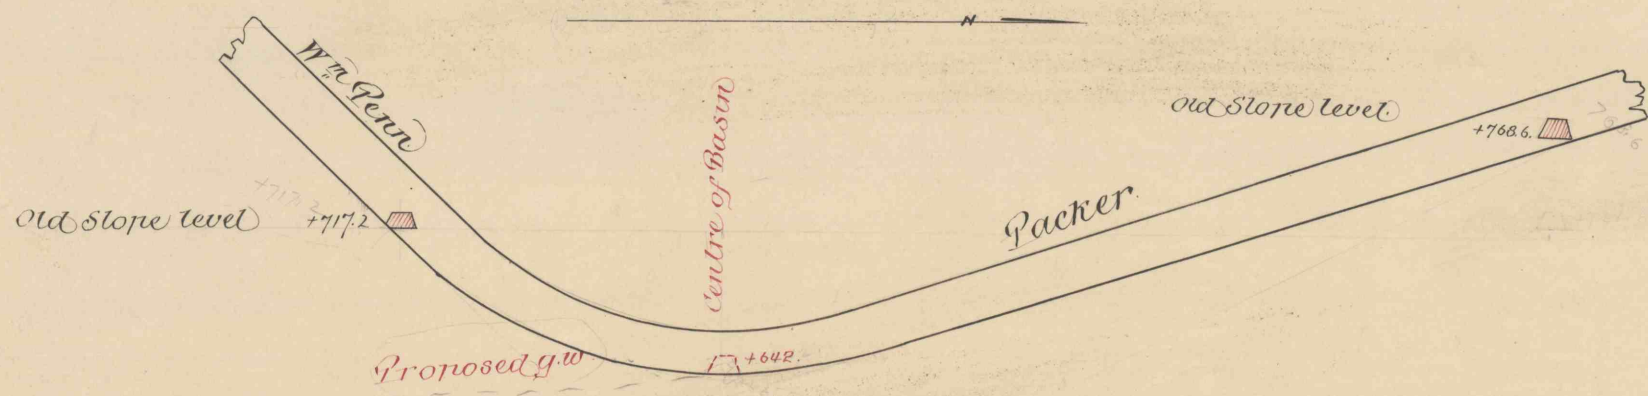

Scale 100'

Feb. 27. 83

Scale 100'

Feb. 27. 83.

Heber D. Harpison.

Engineer