


North looking West

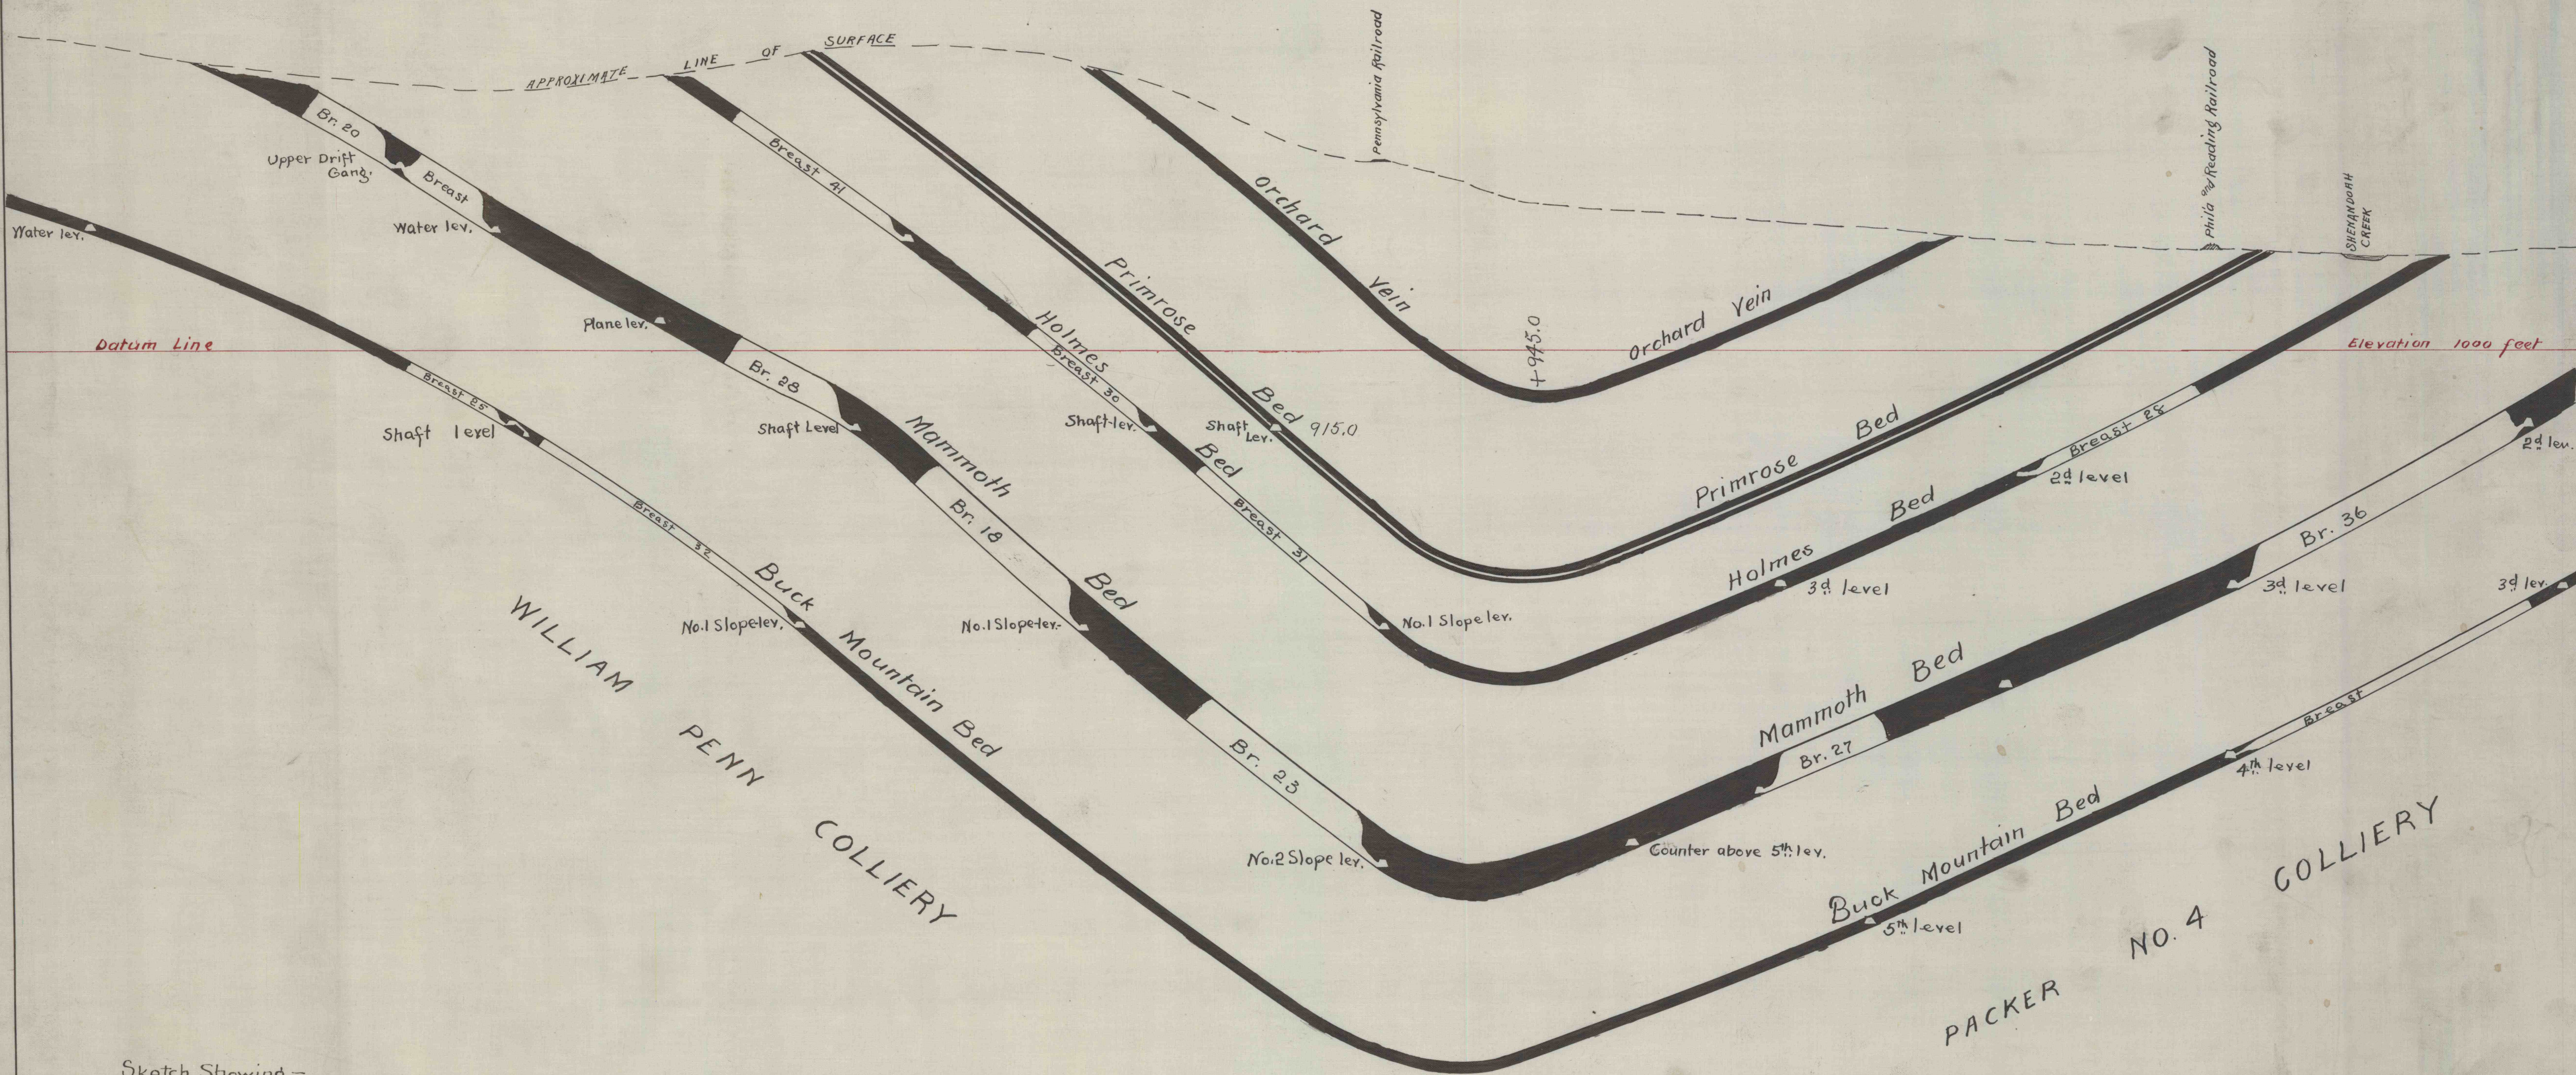

Sketch Showing—
Vertical Section through Orchard Bed and other measures
at William Penn Colliery 500 yards East of the Tunnel to the Orchard
Bed-shaft Level and on a course of North 9° 30' West
Scale 1 inch = 100 feet
Pottsville, Pa.

Heber S. Thompson
Engineer Girard Estate

September 16-1894