


City Lands

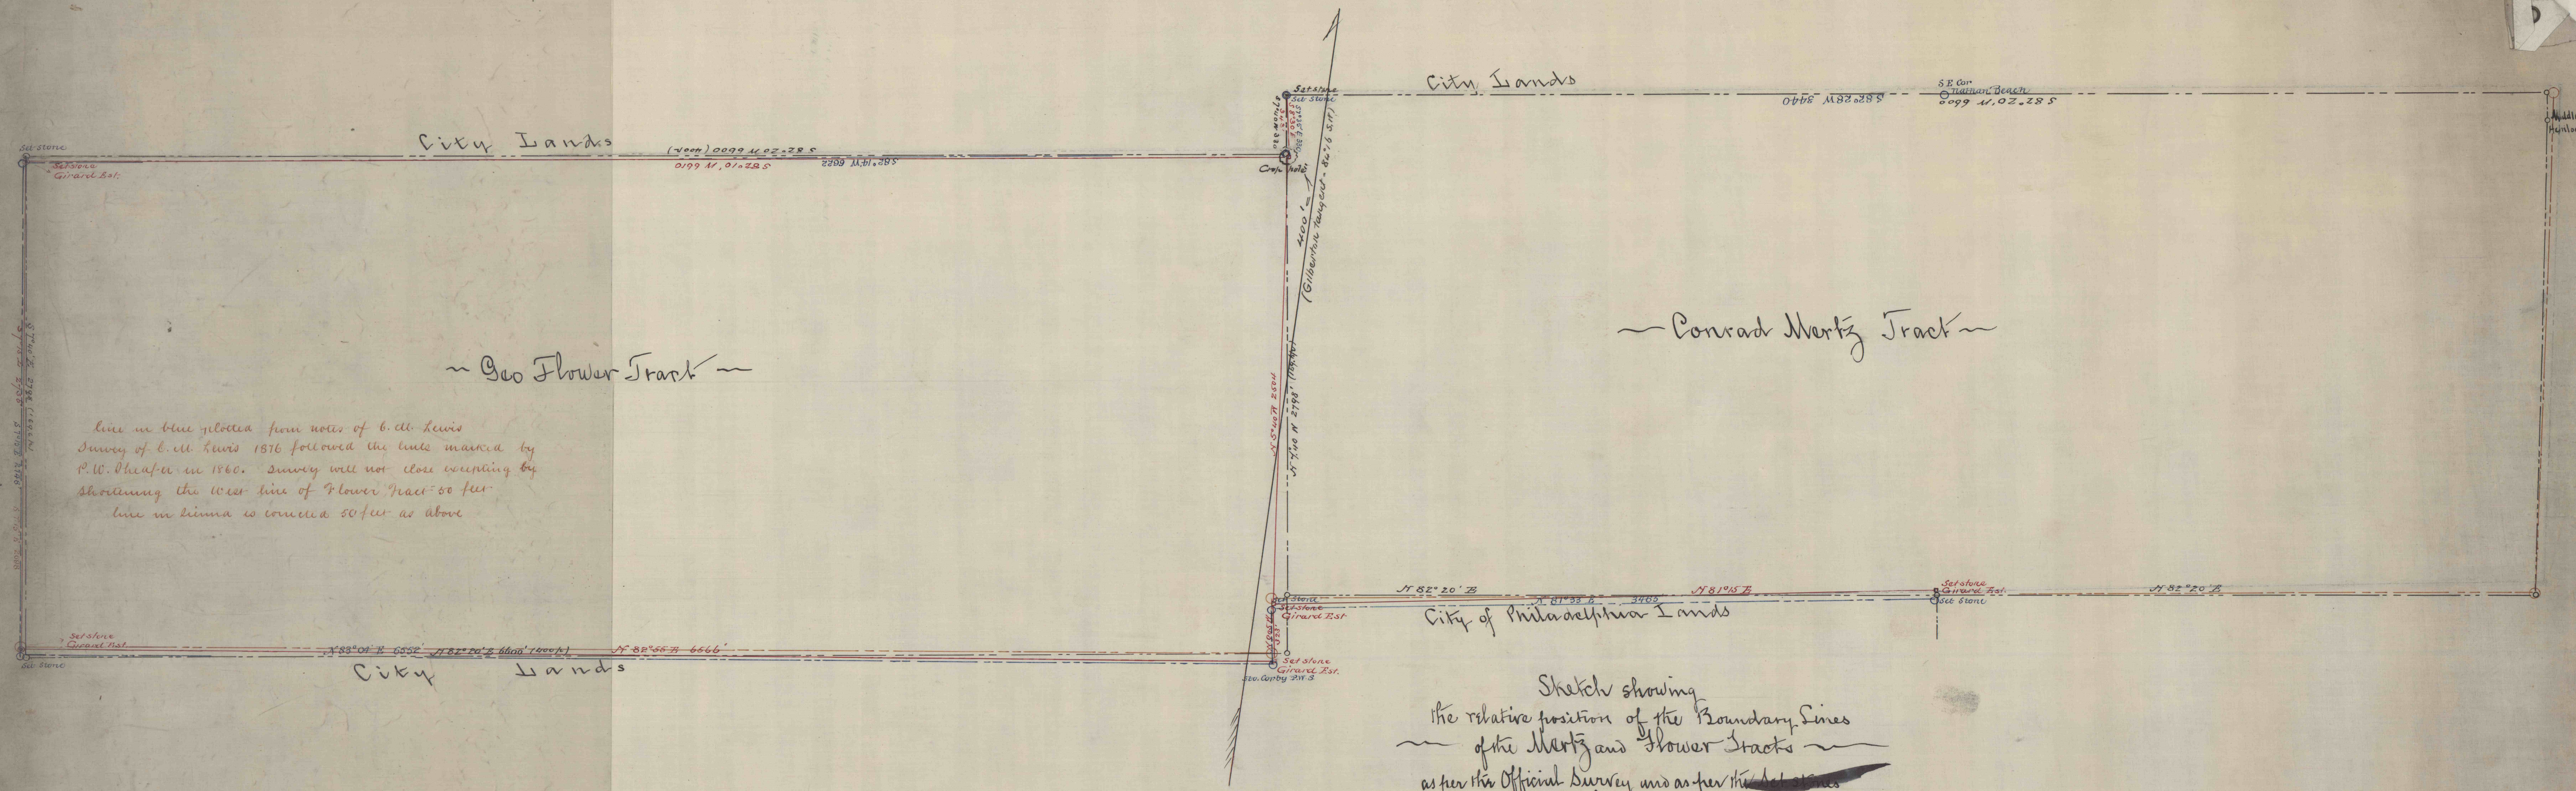

Geo Flower Tract

Conrad Mertz Tract

Line in blue plotted from notes of C. M. Lewis
Survey of C. M. Lewis 1876 followed the line marked by
P. W. Sheaffer in 1860. Survey will not close excepting by
shortening the West line of Flower Tract 50 feet
Line in pink is corrected 50 feet as above

Sketch showing
the relative position of the Boundary Lines
of the Mertz and Flower Tracts
as per the Official Survey and as per the Set stones
of the Girard Estate.

Official Lines in Black
Girard Est survey in Red
C. M. Lewis Survey in Blue
Scale 400 ft = 1 in.
P. W. Sheaffer Engineer
Pottsville. July 1885