


5

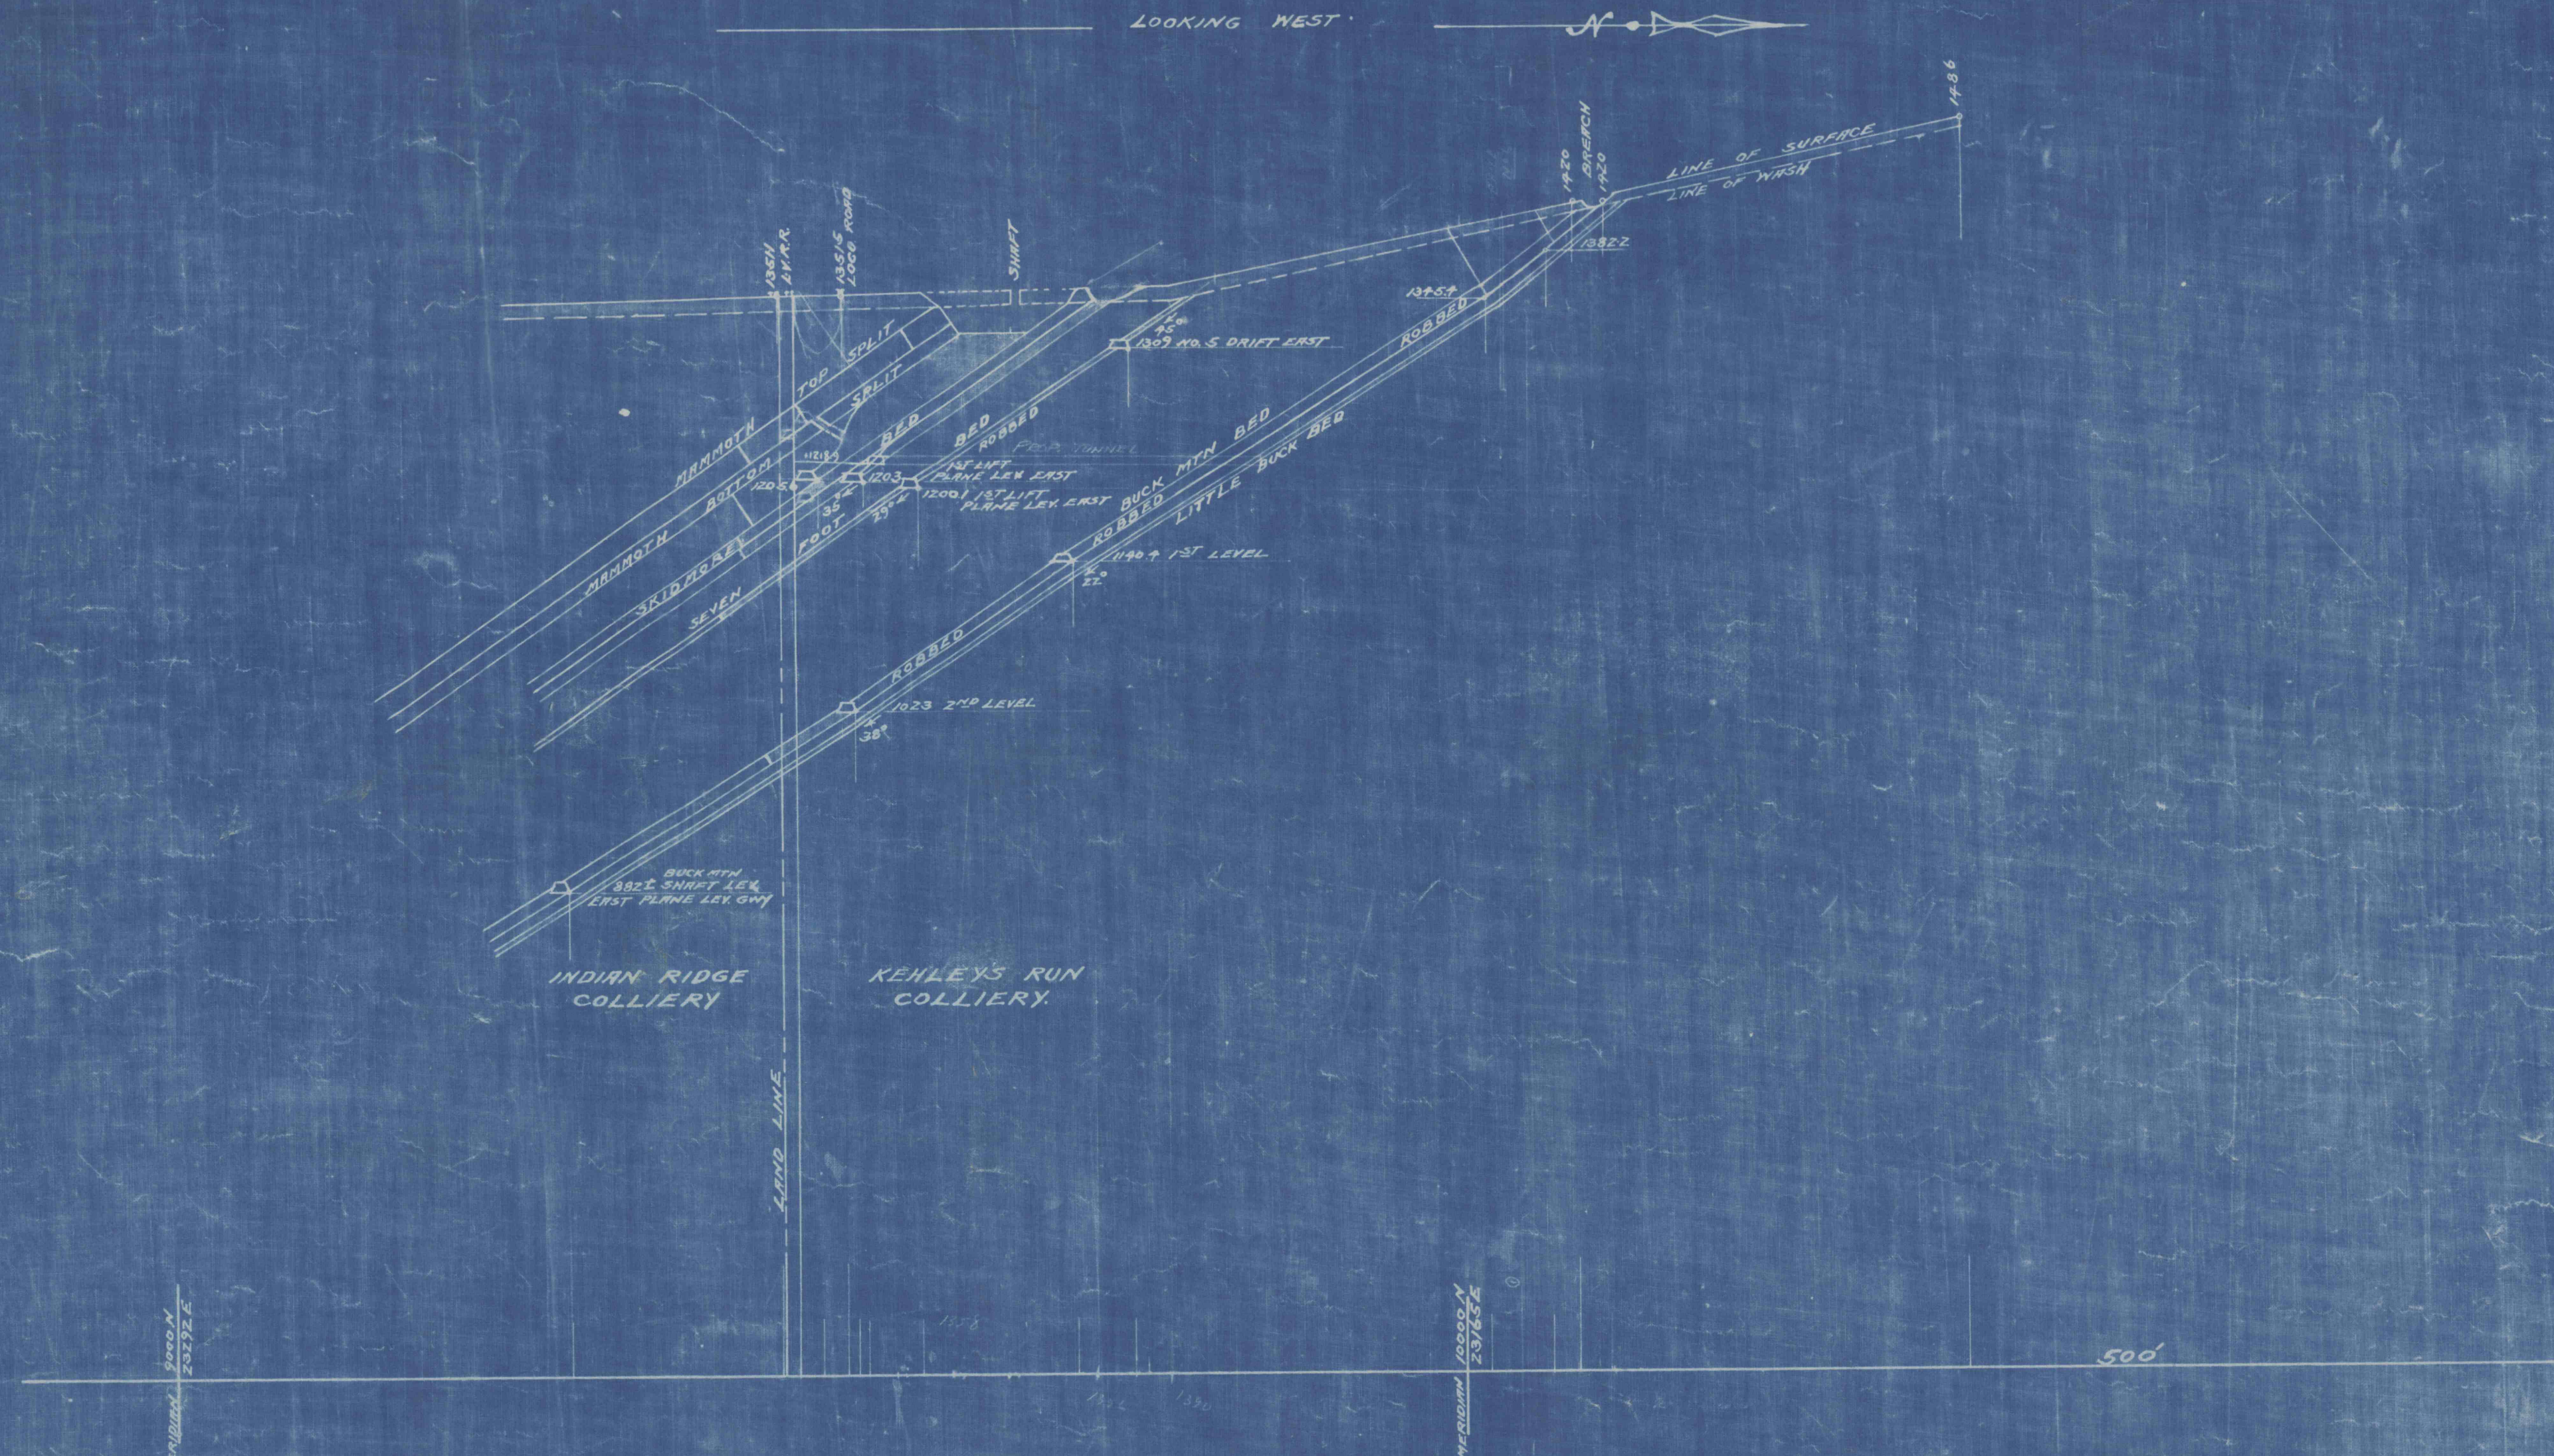

KEHLEY'S RUN COLLIERY.  
CROSS SECTION THRO BREAST No. 31 ON FIRST LIFT PLANE LEVEL  
EAST BOTTOM SPLIT GANGWAY.

SCALE 1" = 100'

FRACKVILLE, PENNA.

THOMAS COLLIERY COMPANY.  
SHENANDOAH, PA.

JUNE-9-1917.