


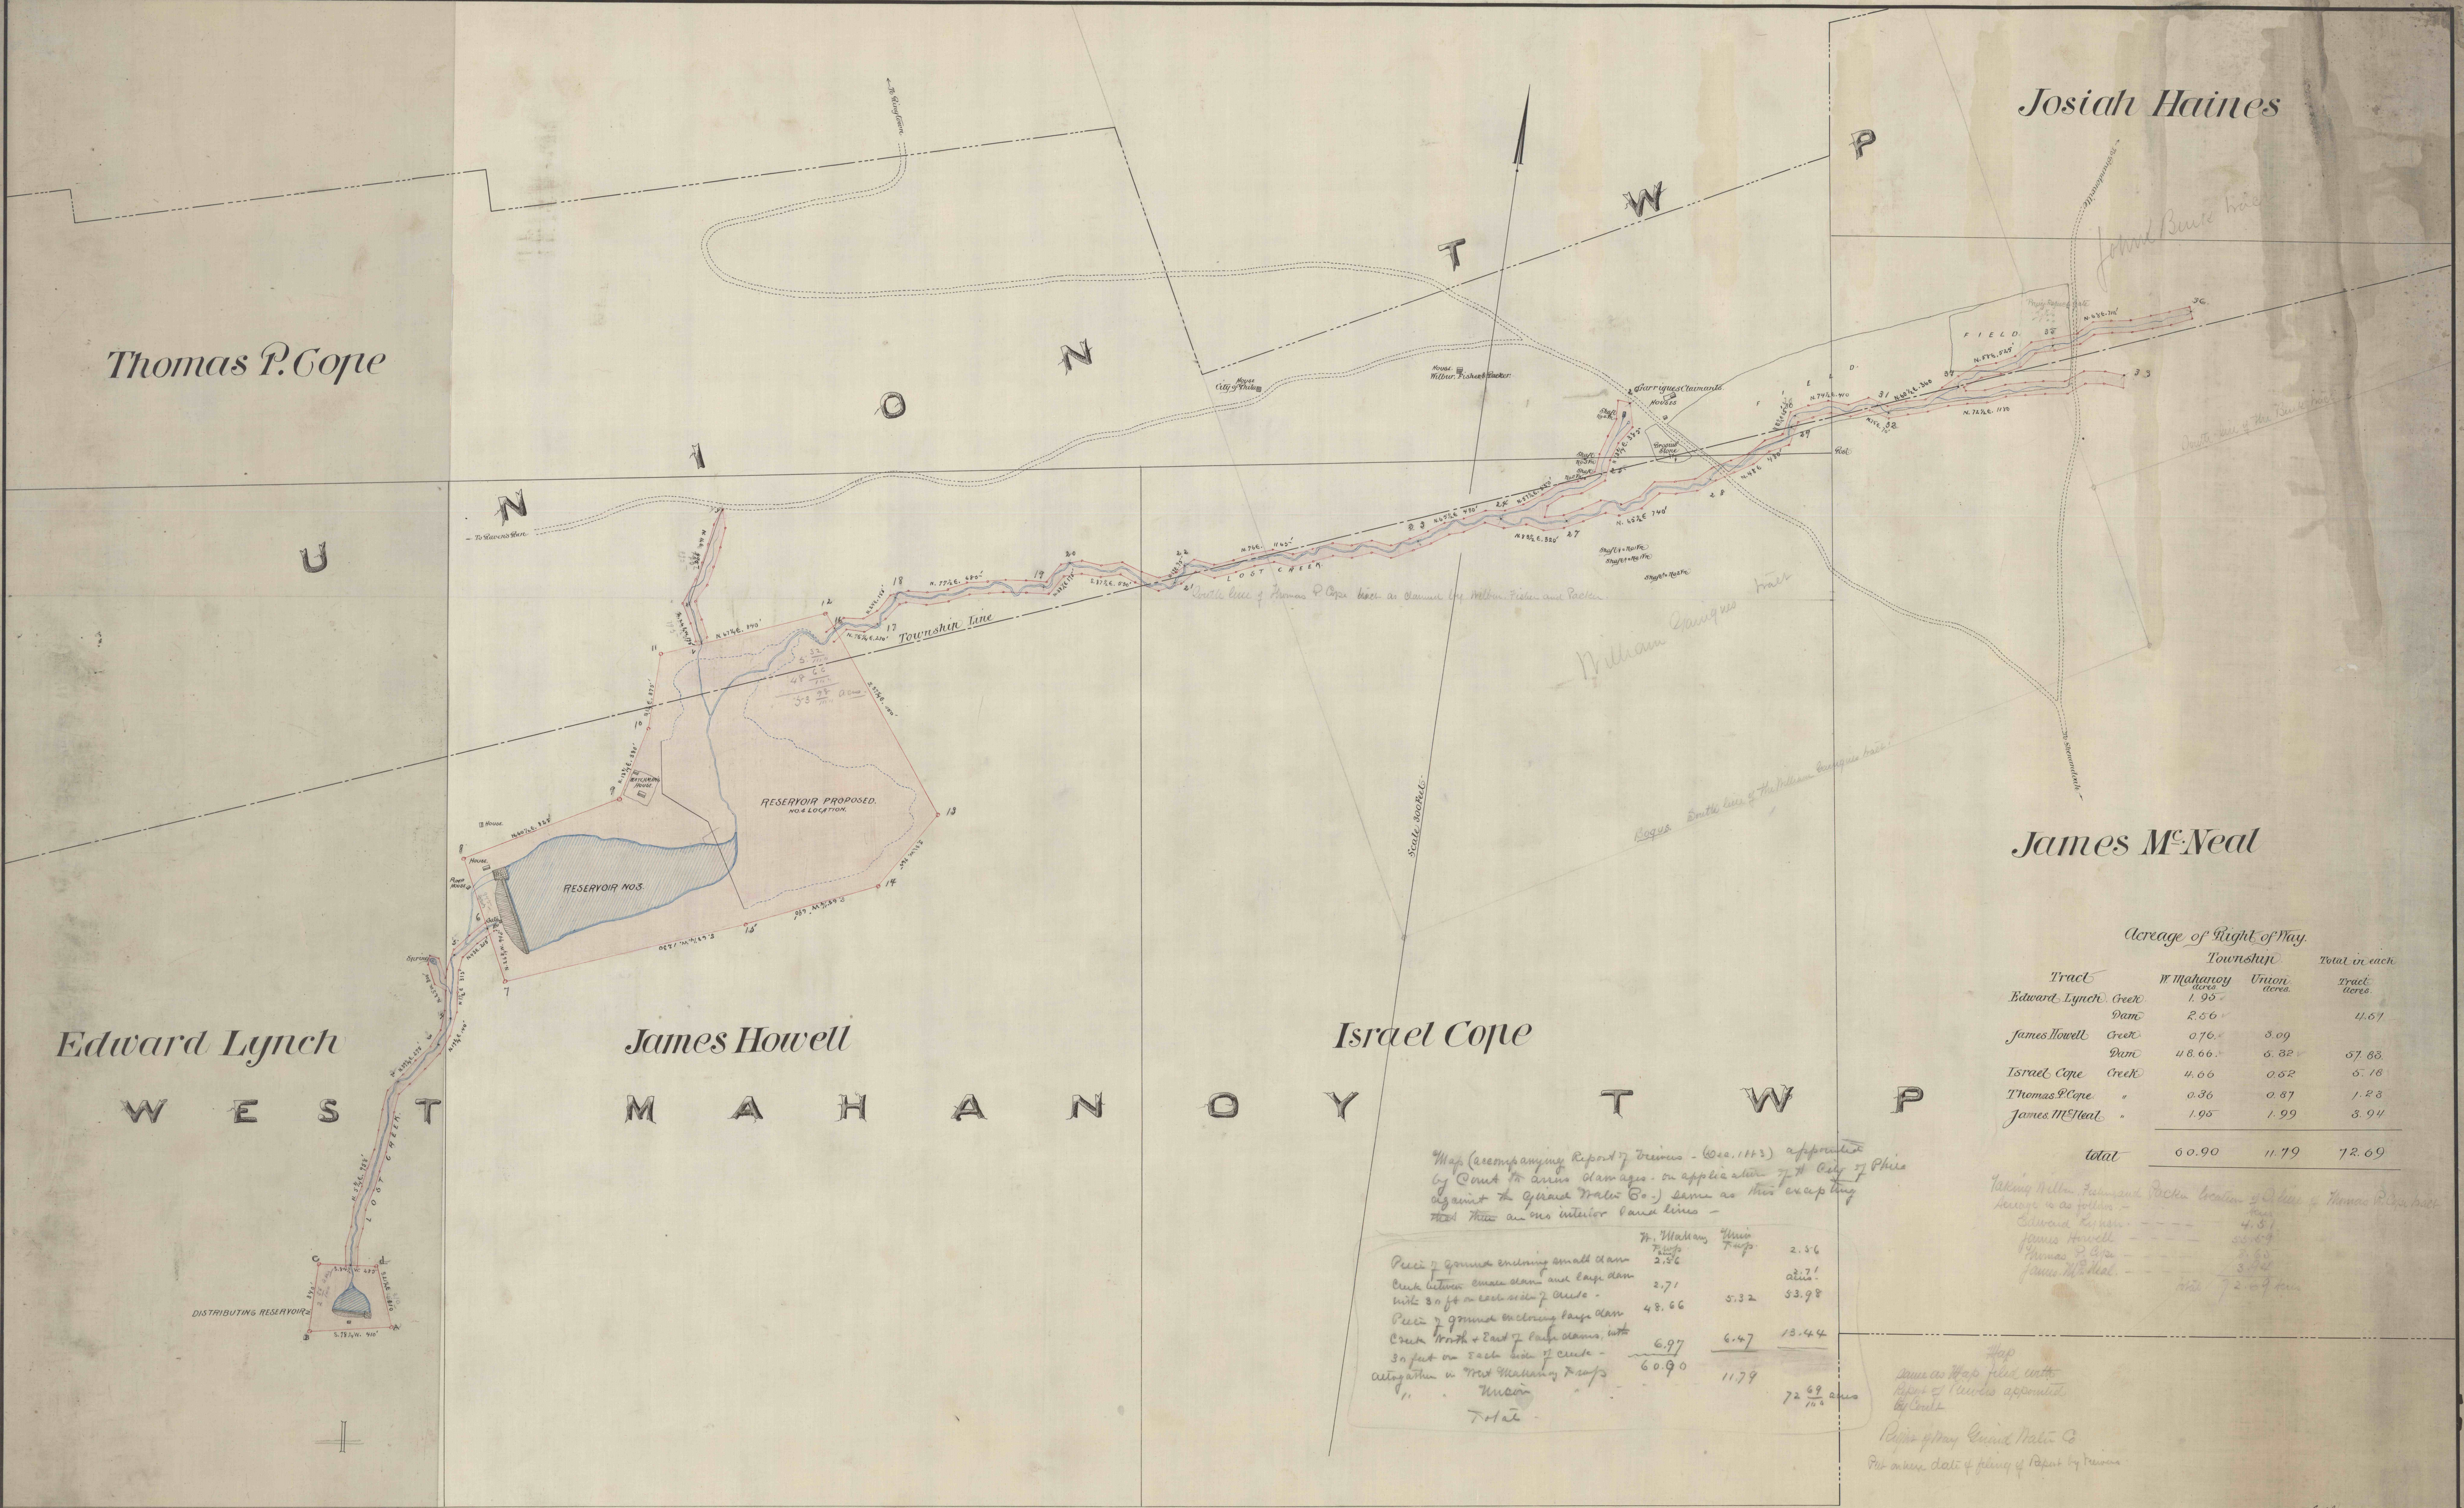

Josiah Haines

Thomas P. Cope

James McNeal

Israel Cope

James Howell

Edward Lynch

Acreage of Right of Way.

Tract	Township		Total in each
	West Mahanoy	Union	
Edward Lynch, Creek	1.95		
Dam	2.56		4.51
James Howell, Creek	0.76	3.09	
Dam	48.66	5.32	57.83
Israel Cope, Creek	4.66	0.52	5.18
Thomas P. Cope, "	0.36	0.87	1.23
James McNeal, "	1.95	1.99	3.94
total	60.90	11.79	72.69

Map (accompanying Report of Bureau - Dec. 11, 1883) approved by Court for assessment on application of the City of Philadelphia against the Grand Malin Co. same as this excepting that there are no interior land lines -

	West Mahanoy	Union	
Piece of ground enclosing small dam	2.56		2.56
Creek between small dam and large dam with 30 ft on each side of creek	2.71		2.71
Piece of ground enclosing large dam	48.66	5.32	53.98
Creek North + East of large dam, with 30 feet on each side of creek	6.97	6.47	13.44
altogether in West Mahanoy Township	60.90	11.79	
Union			72.69
Total			72.69

Taking Union Township location of dam & Thomas P. Cope tract as follows -
Edward Lynch - 4.51
James Howell - 57.83
Thomas P. Cope - 1.23
James McNeal - 3.94
Total 72.69

Map as Map filed with Report of Bureau approved by Court.
Report filed Grand Malin Co.
For answer date of filing of Report by Bureau