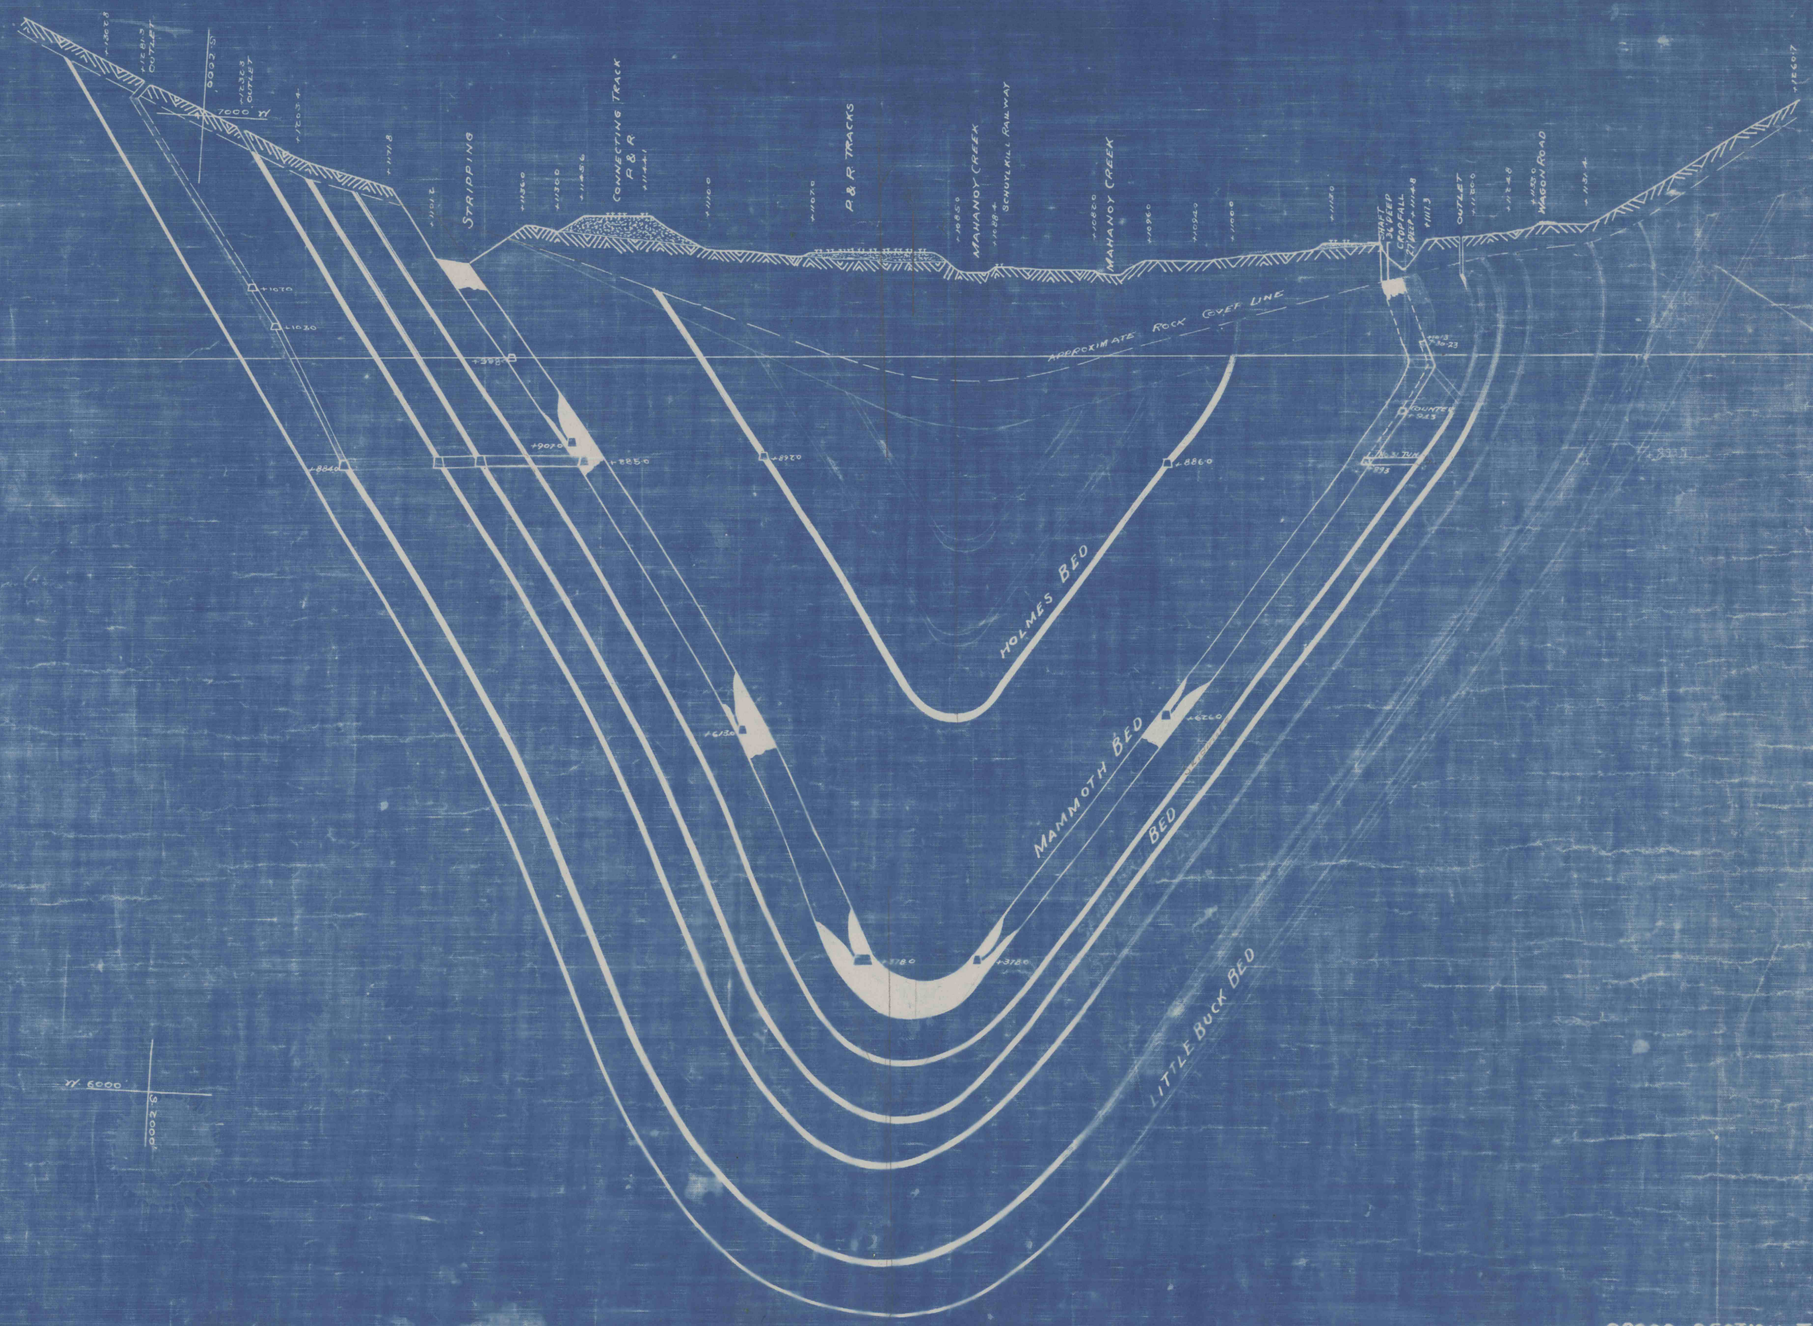

CROSS SECTION THRU
NO. 3 TUNNEL
AT
WEST BEAR RIDGE COLLIERY
HARLEIGH BROOKWOOD LOW COTTAGEVILLE, PA.
SEPT. 1918 SCALE 1" = 100'