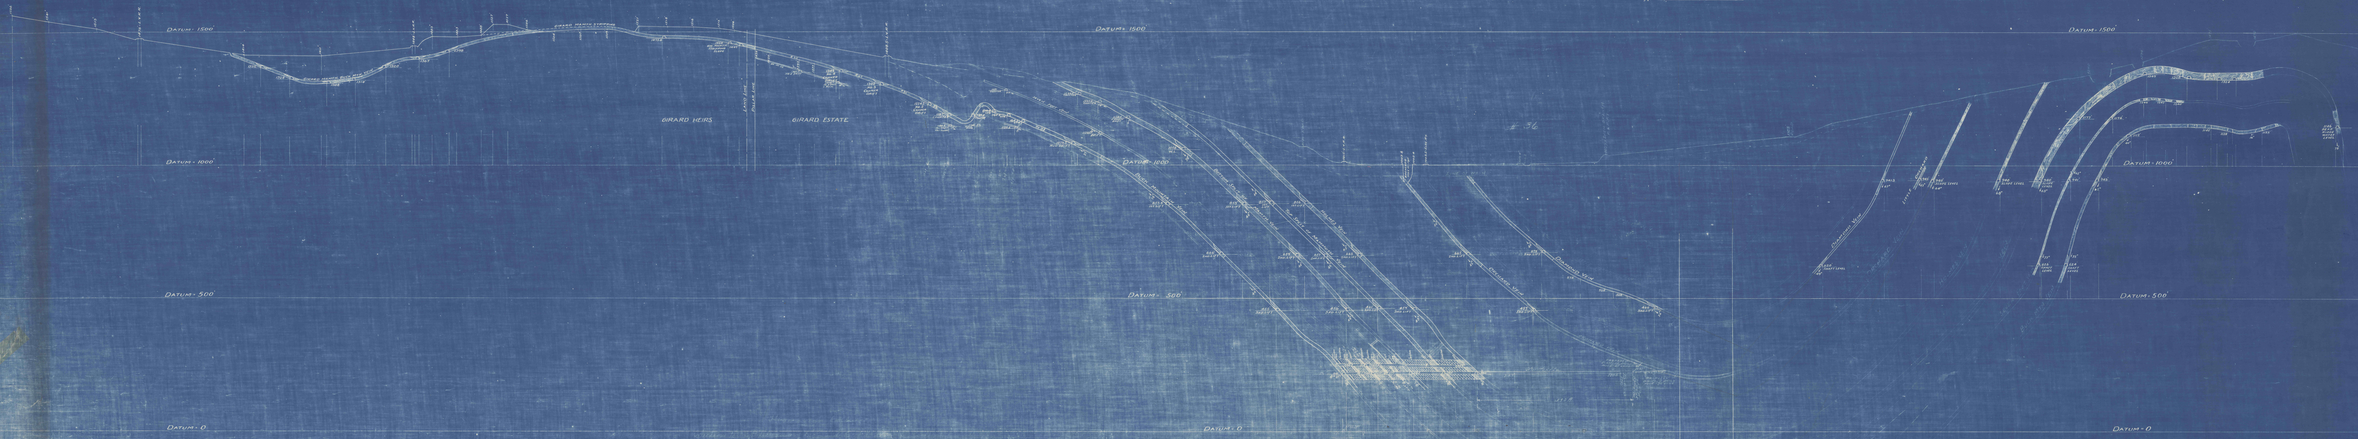

No 36

HAMMOND COLLIERY

SECTION ACROSS BASIN AT A POINT 1950 FEET WEST OF EAST LINE OF LEASE

SCALE – 100 FT. PER INCH
F. D. WEISER DIVISION ENGINEER
ASHLAND, MARCH 7-1911

HAMMOND COLLIERY WORKINGS
PACKER NO. 5 COLLIERY WORKINGS
N
DATUM = 1500
DATUM – 1000
DATUM – 500
DATUM – 0
GIRARD MAMTH STRIPPING
1454
GIR. MAMTH STRIPPING SLOPE
1447
1475.4
1408.5 – L.V.R.R.
LAND LINE
PILLAR LINE
GIRARD HEIRS
GIRARD ESTATE
1349 NO. 4 CONNER DRIFT
1300 NO. 3 CONNER DRIFT
1274.5 NO. 2 CONNER DRIFT
1187 COUNTER
1281 COUNTER
1139.2