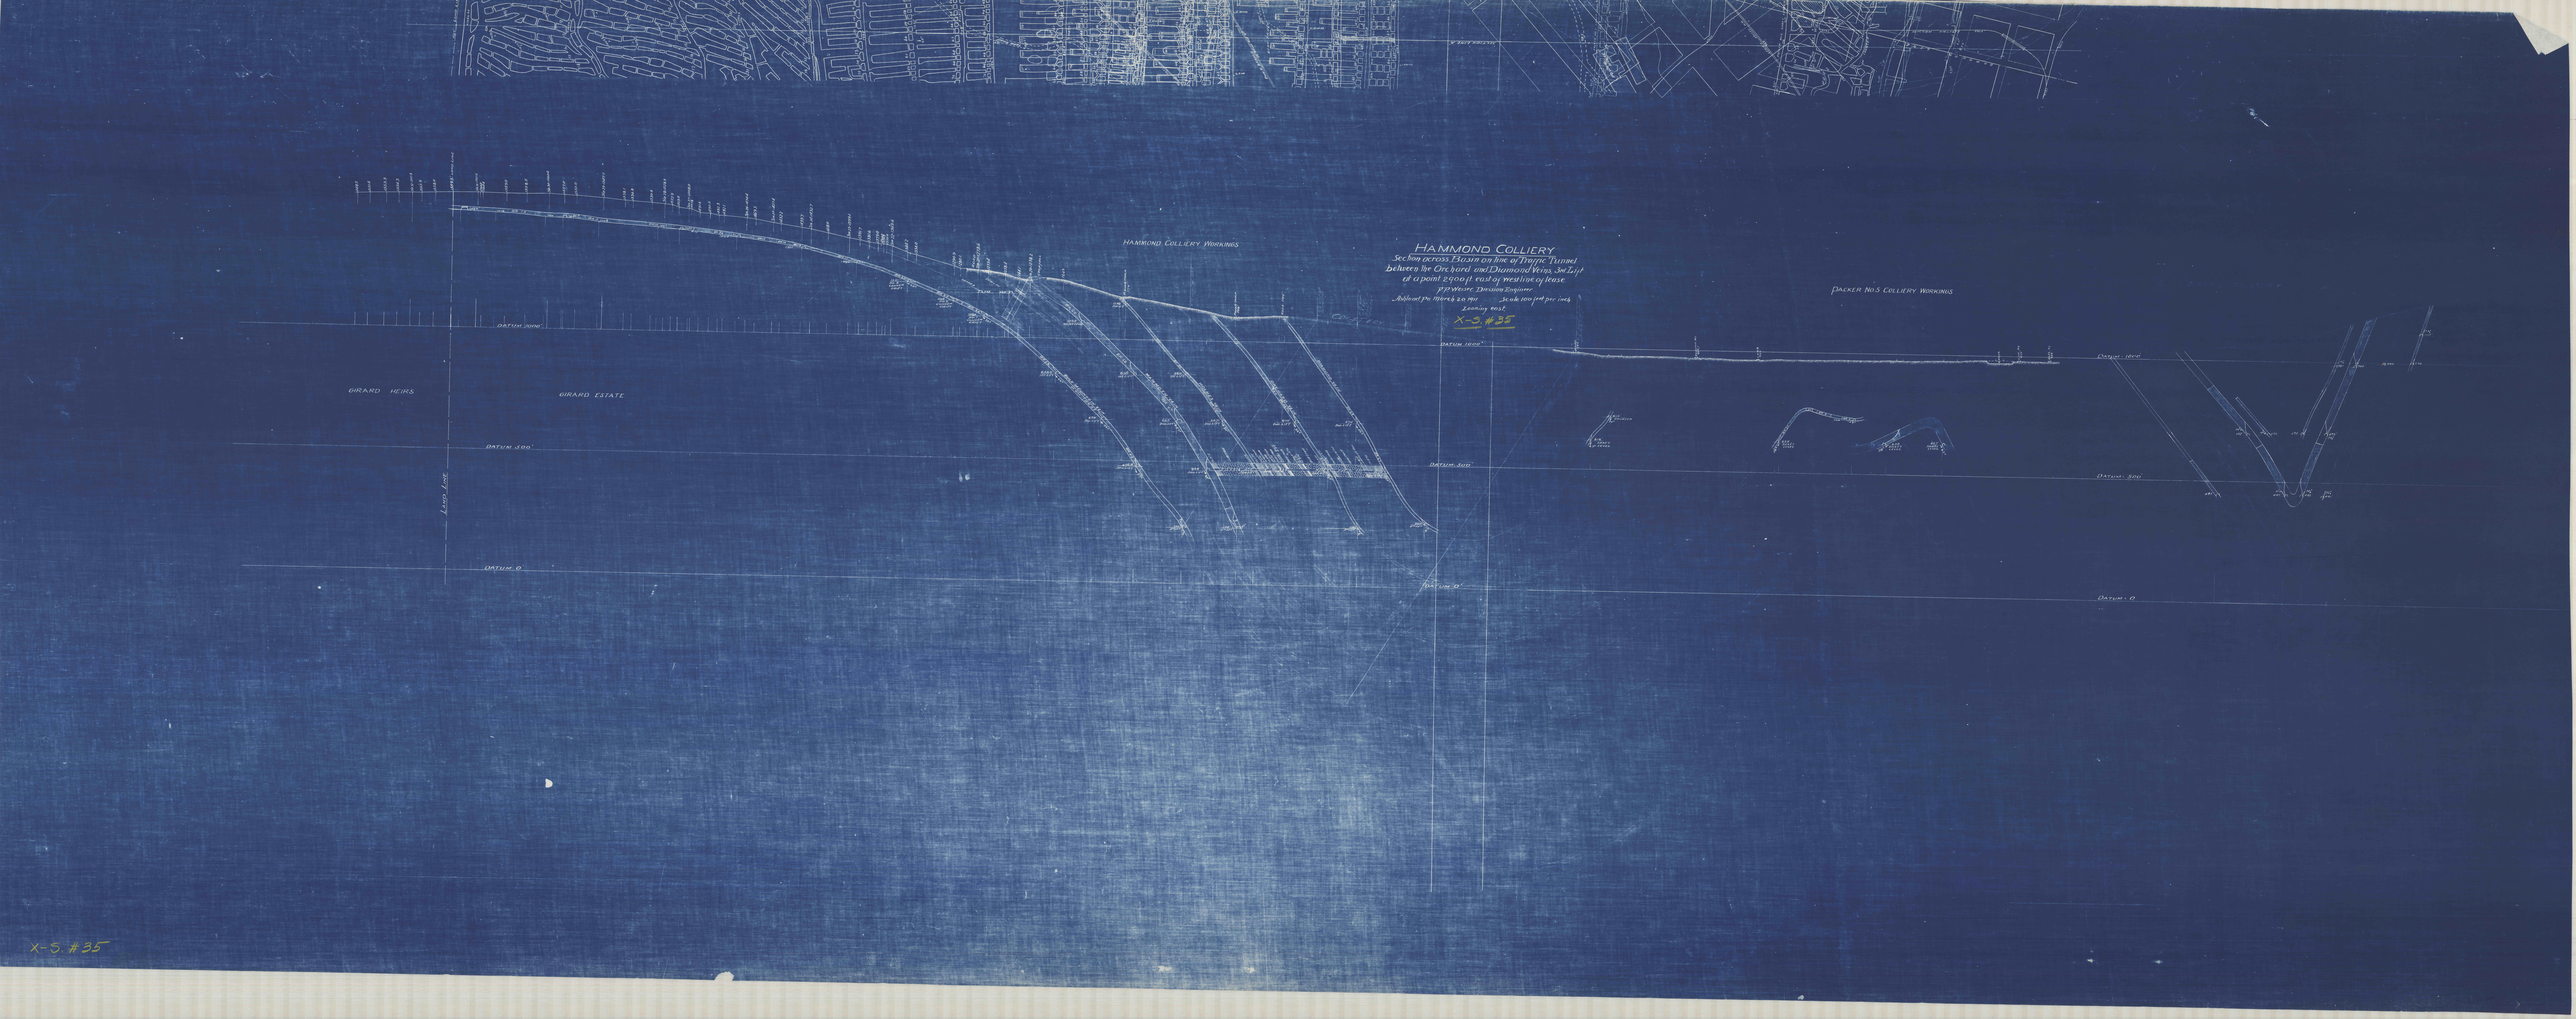

HAMMOND COLLIERY
Section across Basin on line of Traffic Tunnel between the Orchard and Diamond Veins, 3rd Lift at a point 2,900 ft. east of mouth of lease.
J.T.P. Weare, Division Engineer.
Published Feb. March 20 1911. Scale 100 feet per inch. Looking east.
X-5. #35
HAMMOND COLLIERY WORKINGS
PACKER No. 5 COLLIERY WORKINGS
LEASE LINE
DATUM 1000'
DATUM 500'
DATUM 0'
DATUM 1000
DATUM 500
DATUM 0

X-5. #35