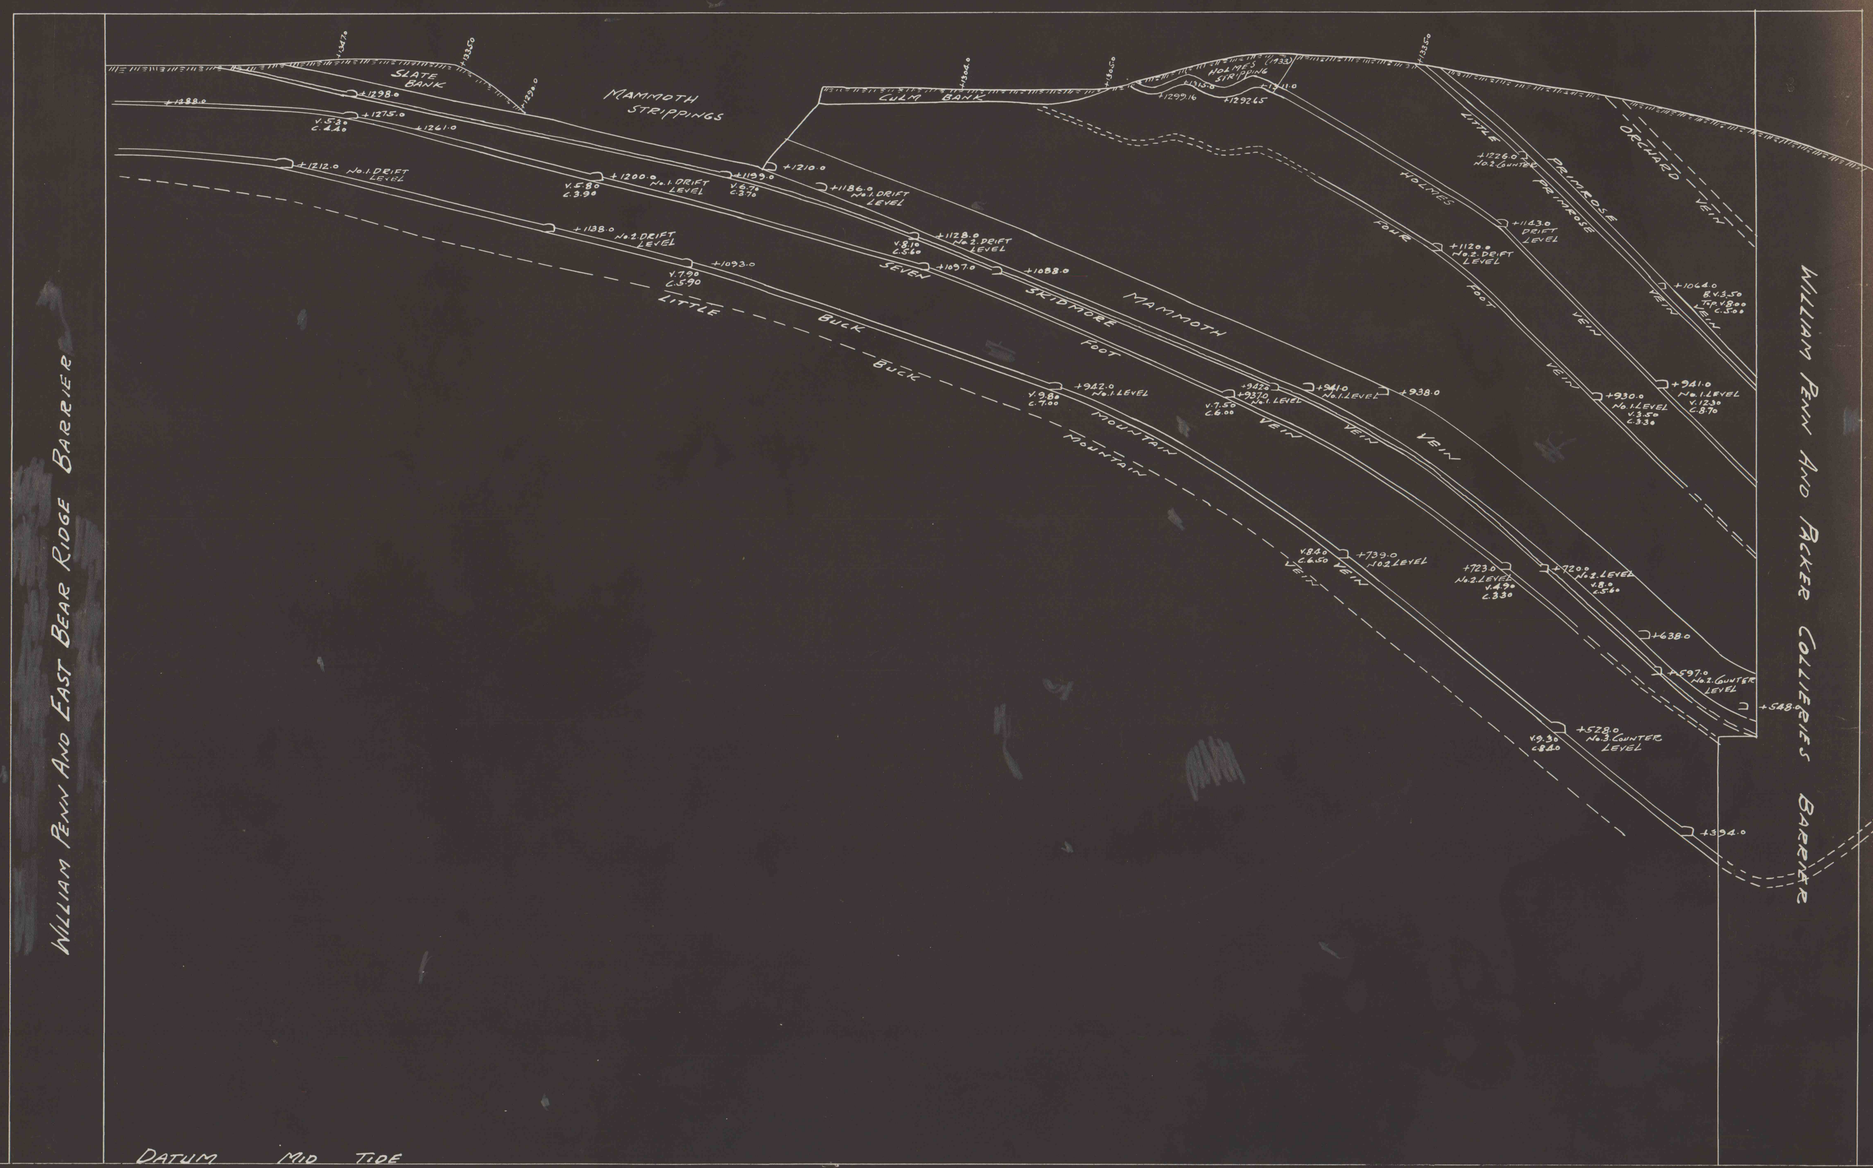SECTION THRU EAST LINE OF LEASE
WILLIAM PENN COLLIERY
SHAFT, PA. 1-14-34 SCALE 1" = 100'