


4

LOOKING WEST

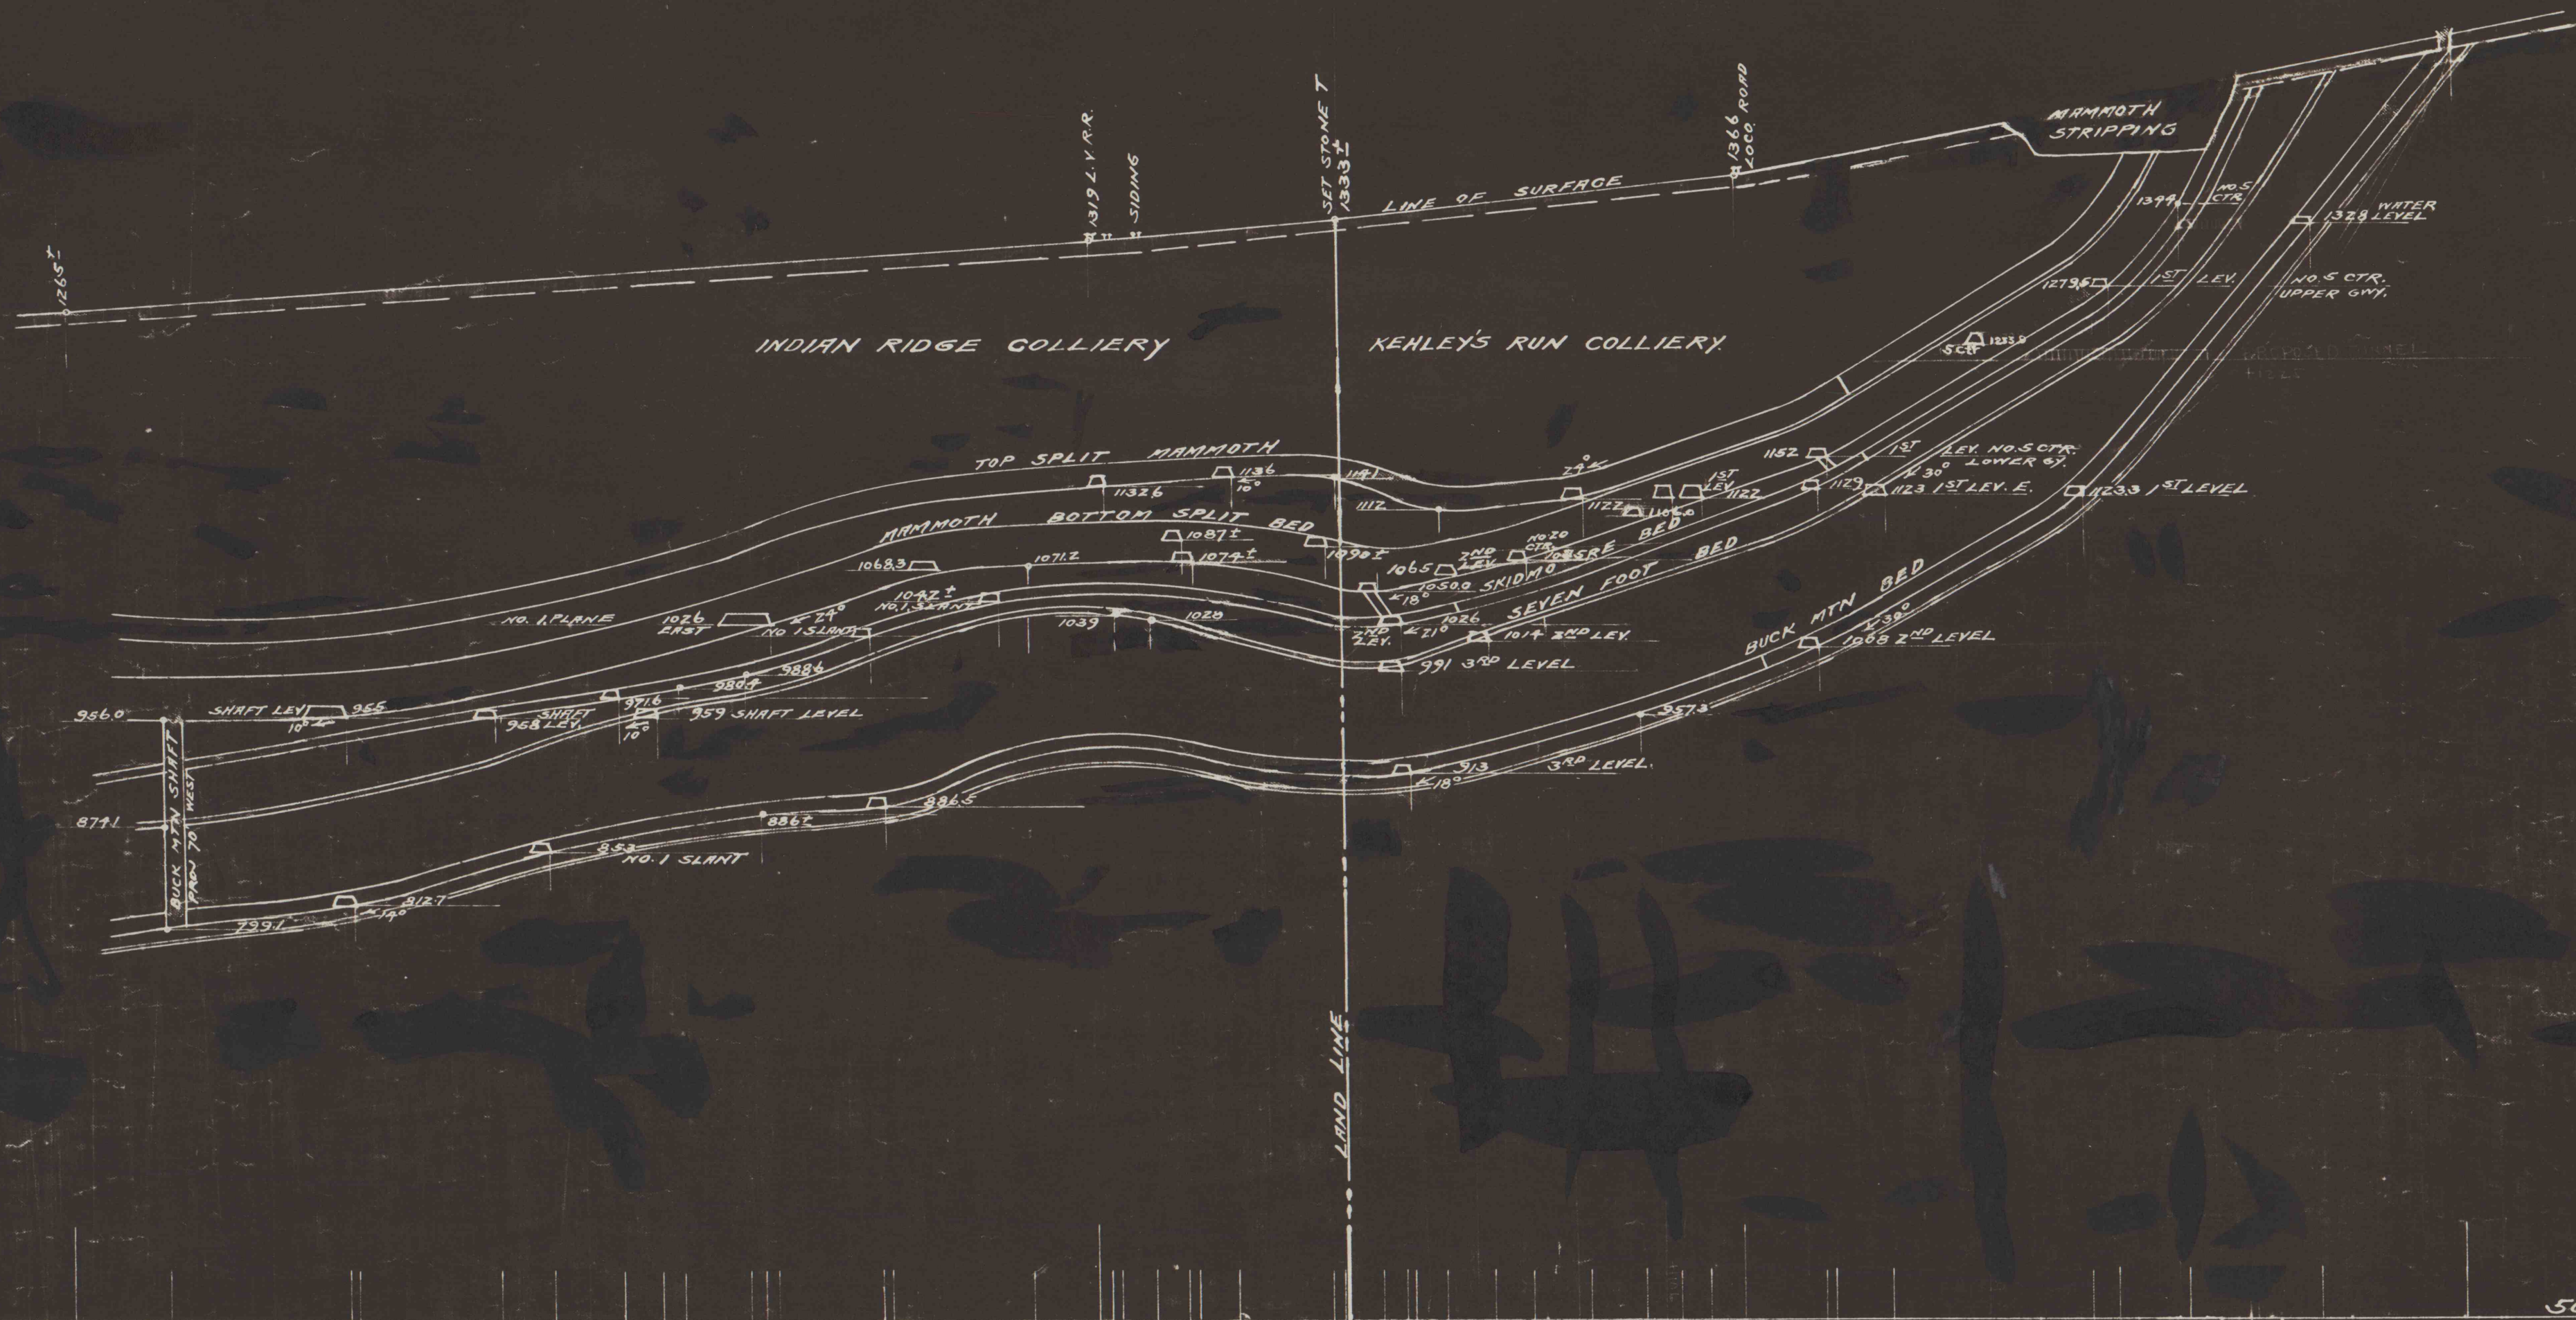

KEHLEY'S RUN COLLIERY

CROSS SECTION THROUGH SET STONE T¹ AT 375 FEET EAST OF AND
PARALLEL TO MERIDIAN LINE 21000 E.

SCALE 1" = 100'

FRACKVILLE, PENNA.

THOMAS COLLIERY COMPANY,
SHENANDORM, PENNA.

JUNE 14-1917.