


No 1

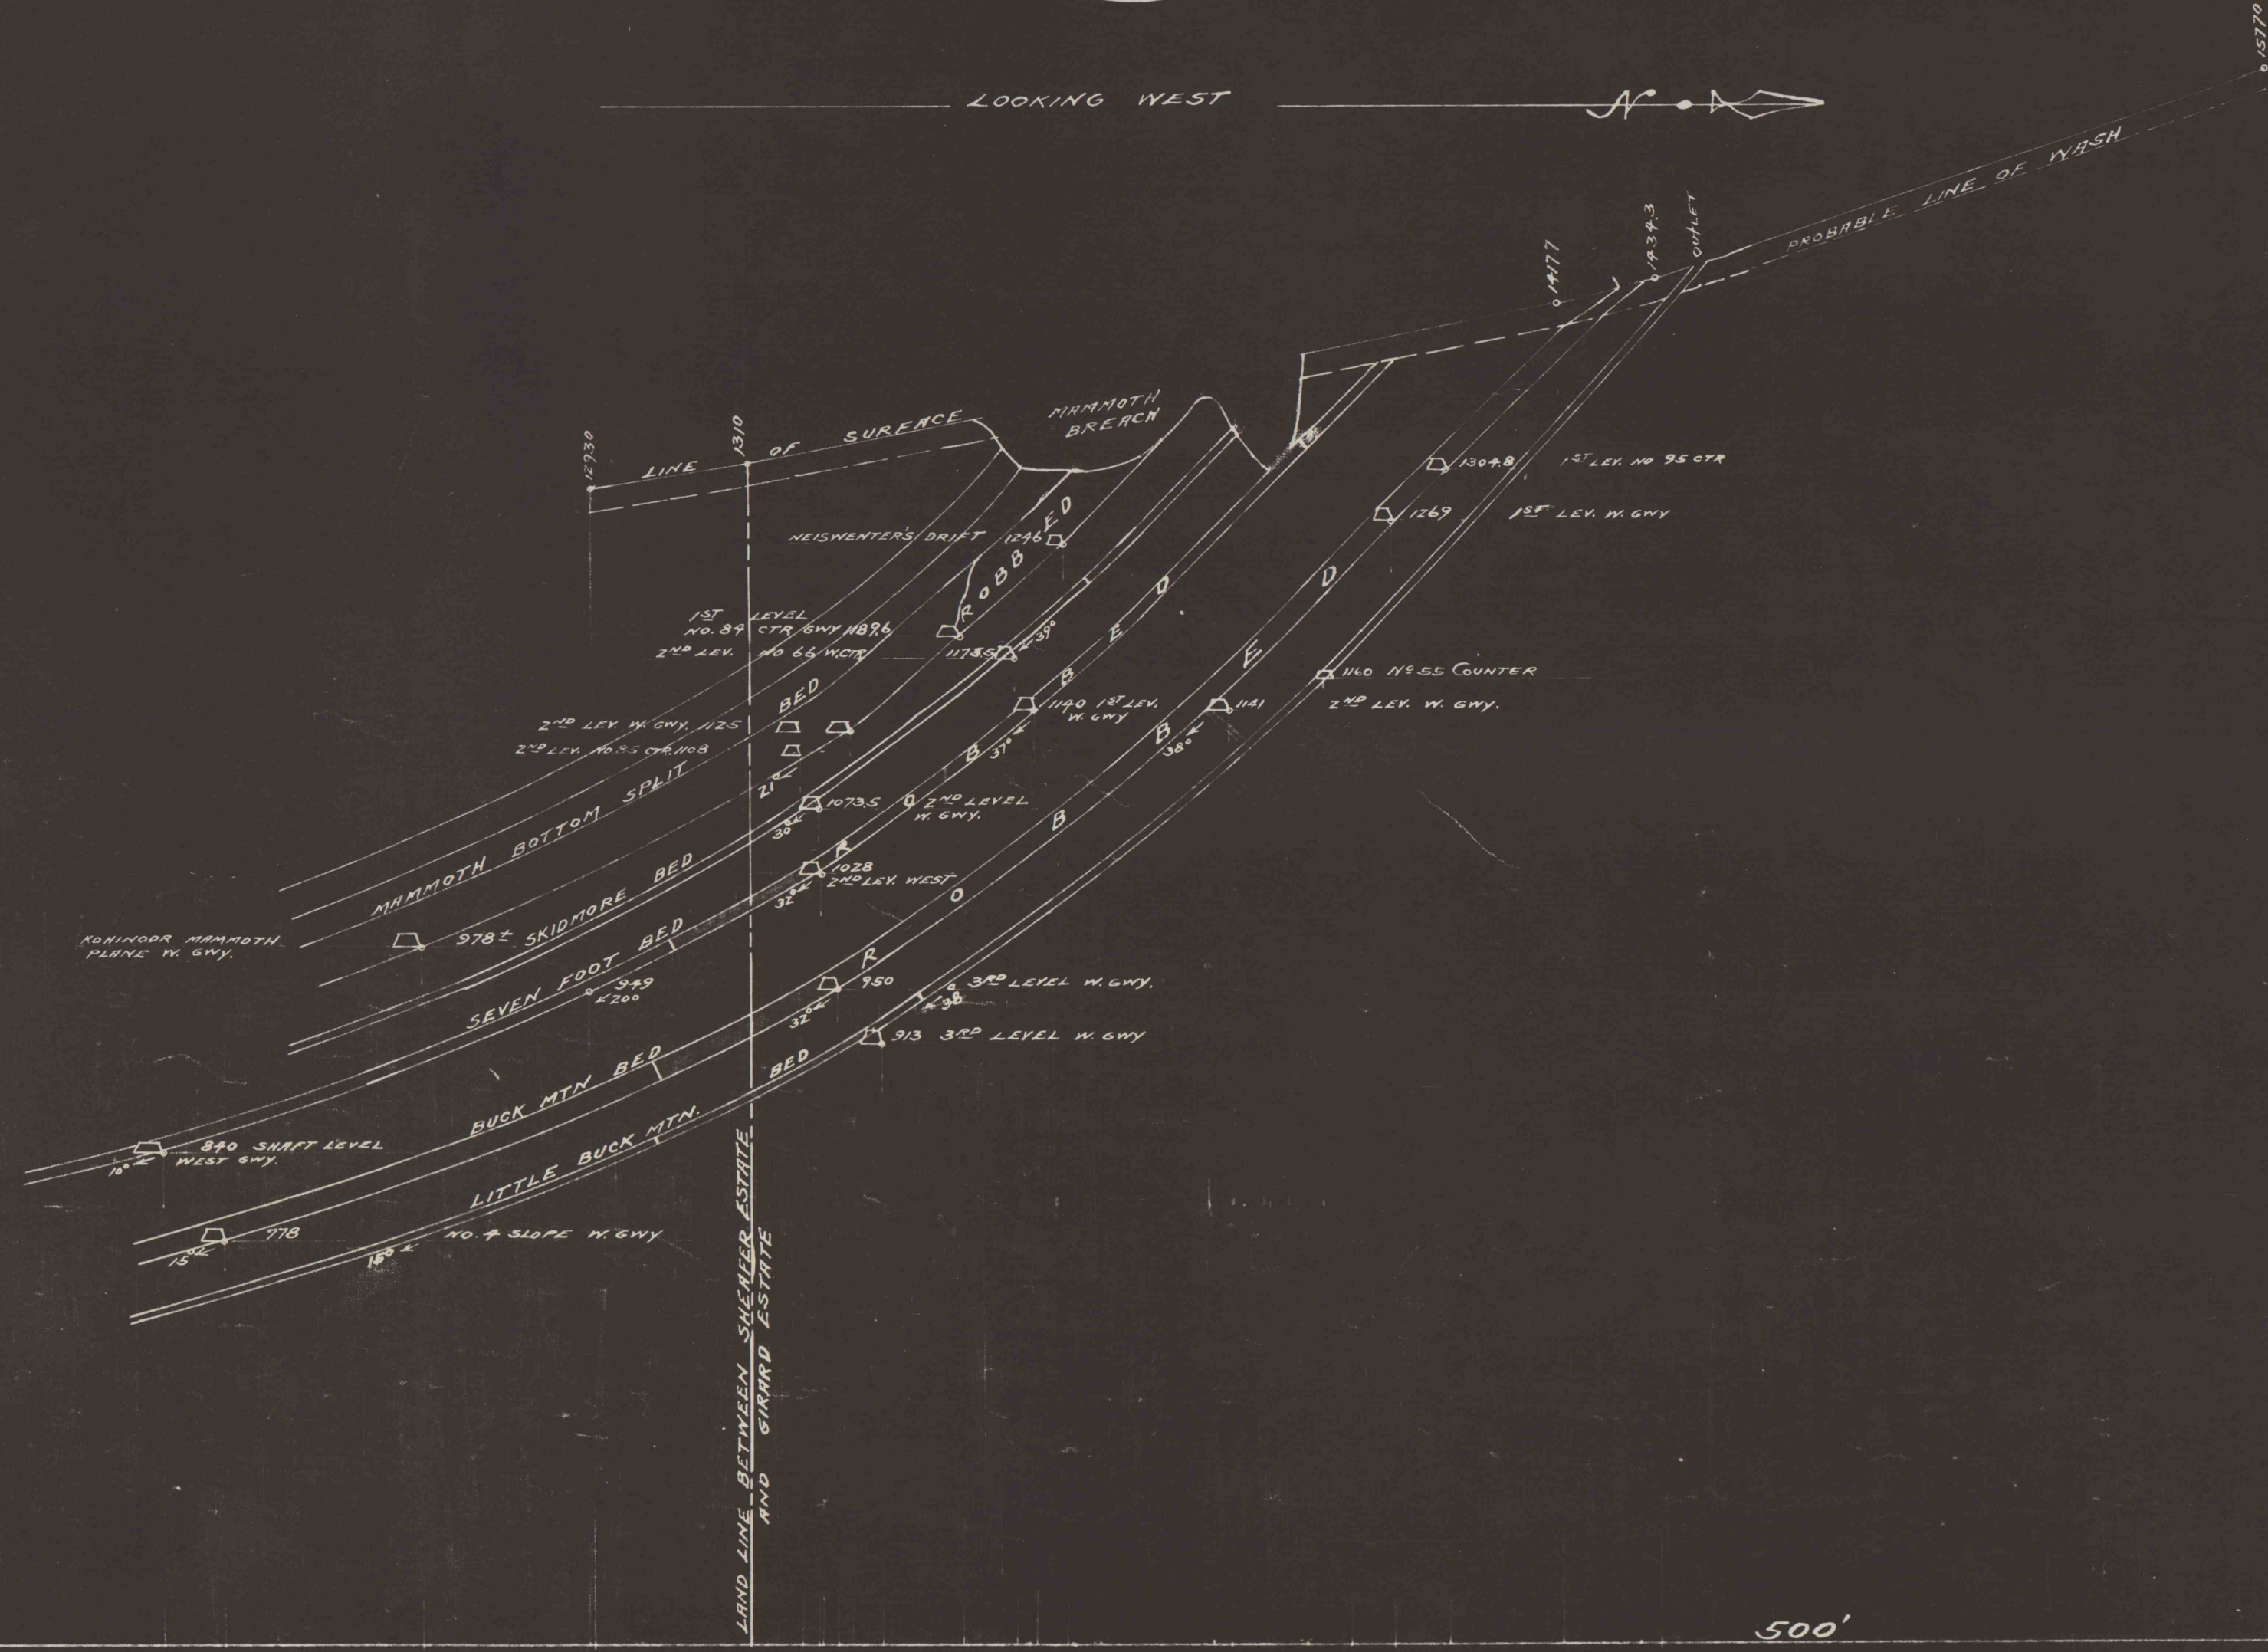

KEHLEY'S RUN COLLIERY
CROSS SECTION THRU NO. 95 BUCK MTN TIMBER CHUTE ON 1ST LEVEL WEST BUCK MTN GWY.
SCALE 1" = 100'
FRACKVILLE, PENNA. JUNE 4-1917.
THOMAS COLLIERY COMPANY,
SHENANDOAN, PENNA.