

LAND OF THOMAS ZIMA  
 NEGLEY FIRE CLAY CO. OFFICE & SCALES  
 ROAD  
 ACCESS ROAD  
 TO DARLINGTON, PA. 1.5 MILES

ACCESS ROAD  
 0.4 MILES - TO NEW GALILEE PA.  
 BLACK TOP ROAD  
 04021

ANDREW LESKO


ANDREW LESKO

**NEGLEY FIRE CLAY COMPANY**  
**STRIP MINE OPERATIONS ON LAND OF THOMAS ZIMA.**  
**BIG BEAVER TOWNSHIP, BEAVER COUNTY, PENNA.**

SCALE : 1 INCH = 50 FEET  
 DANIEL C. BAKER COUNTY SURVEYOR

DECEMBER 4, 1953.  
 BEAVER, PENNA.

MADE FROM ACTUAL SURVEY UPON THE LAND

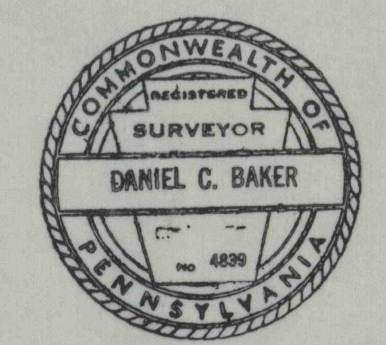

Larson Design Group, Inc. makes no representation or warranty, expressed or implied, with regard to the accuracy, adequacy, completeness or reliability of any of the information contained herein. This map is for informational purposes only and in no way confirms the current state of the land depicted herein. Larson Design Group, Inc. hereby disclaims any and all liability for information and/or statements contained herein. Larson Design Group, Inc. shall not be liable for any damages incurred or arising as a result of reliance upon this map as well as from any errors or inaccuracies on such map.