


SHANE BROTHERS OWNER OF SURFACE
 KIERNAN-COURTNEY COAL CO. OWNER OF COAL
 AREA = 4.5 AC.

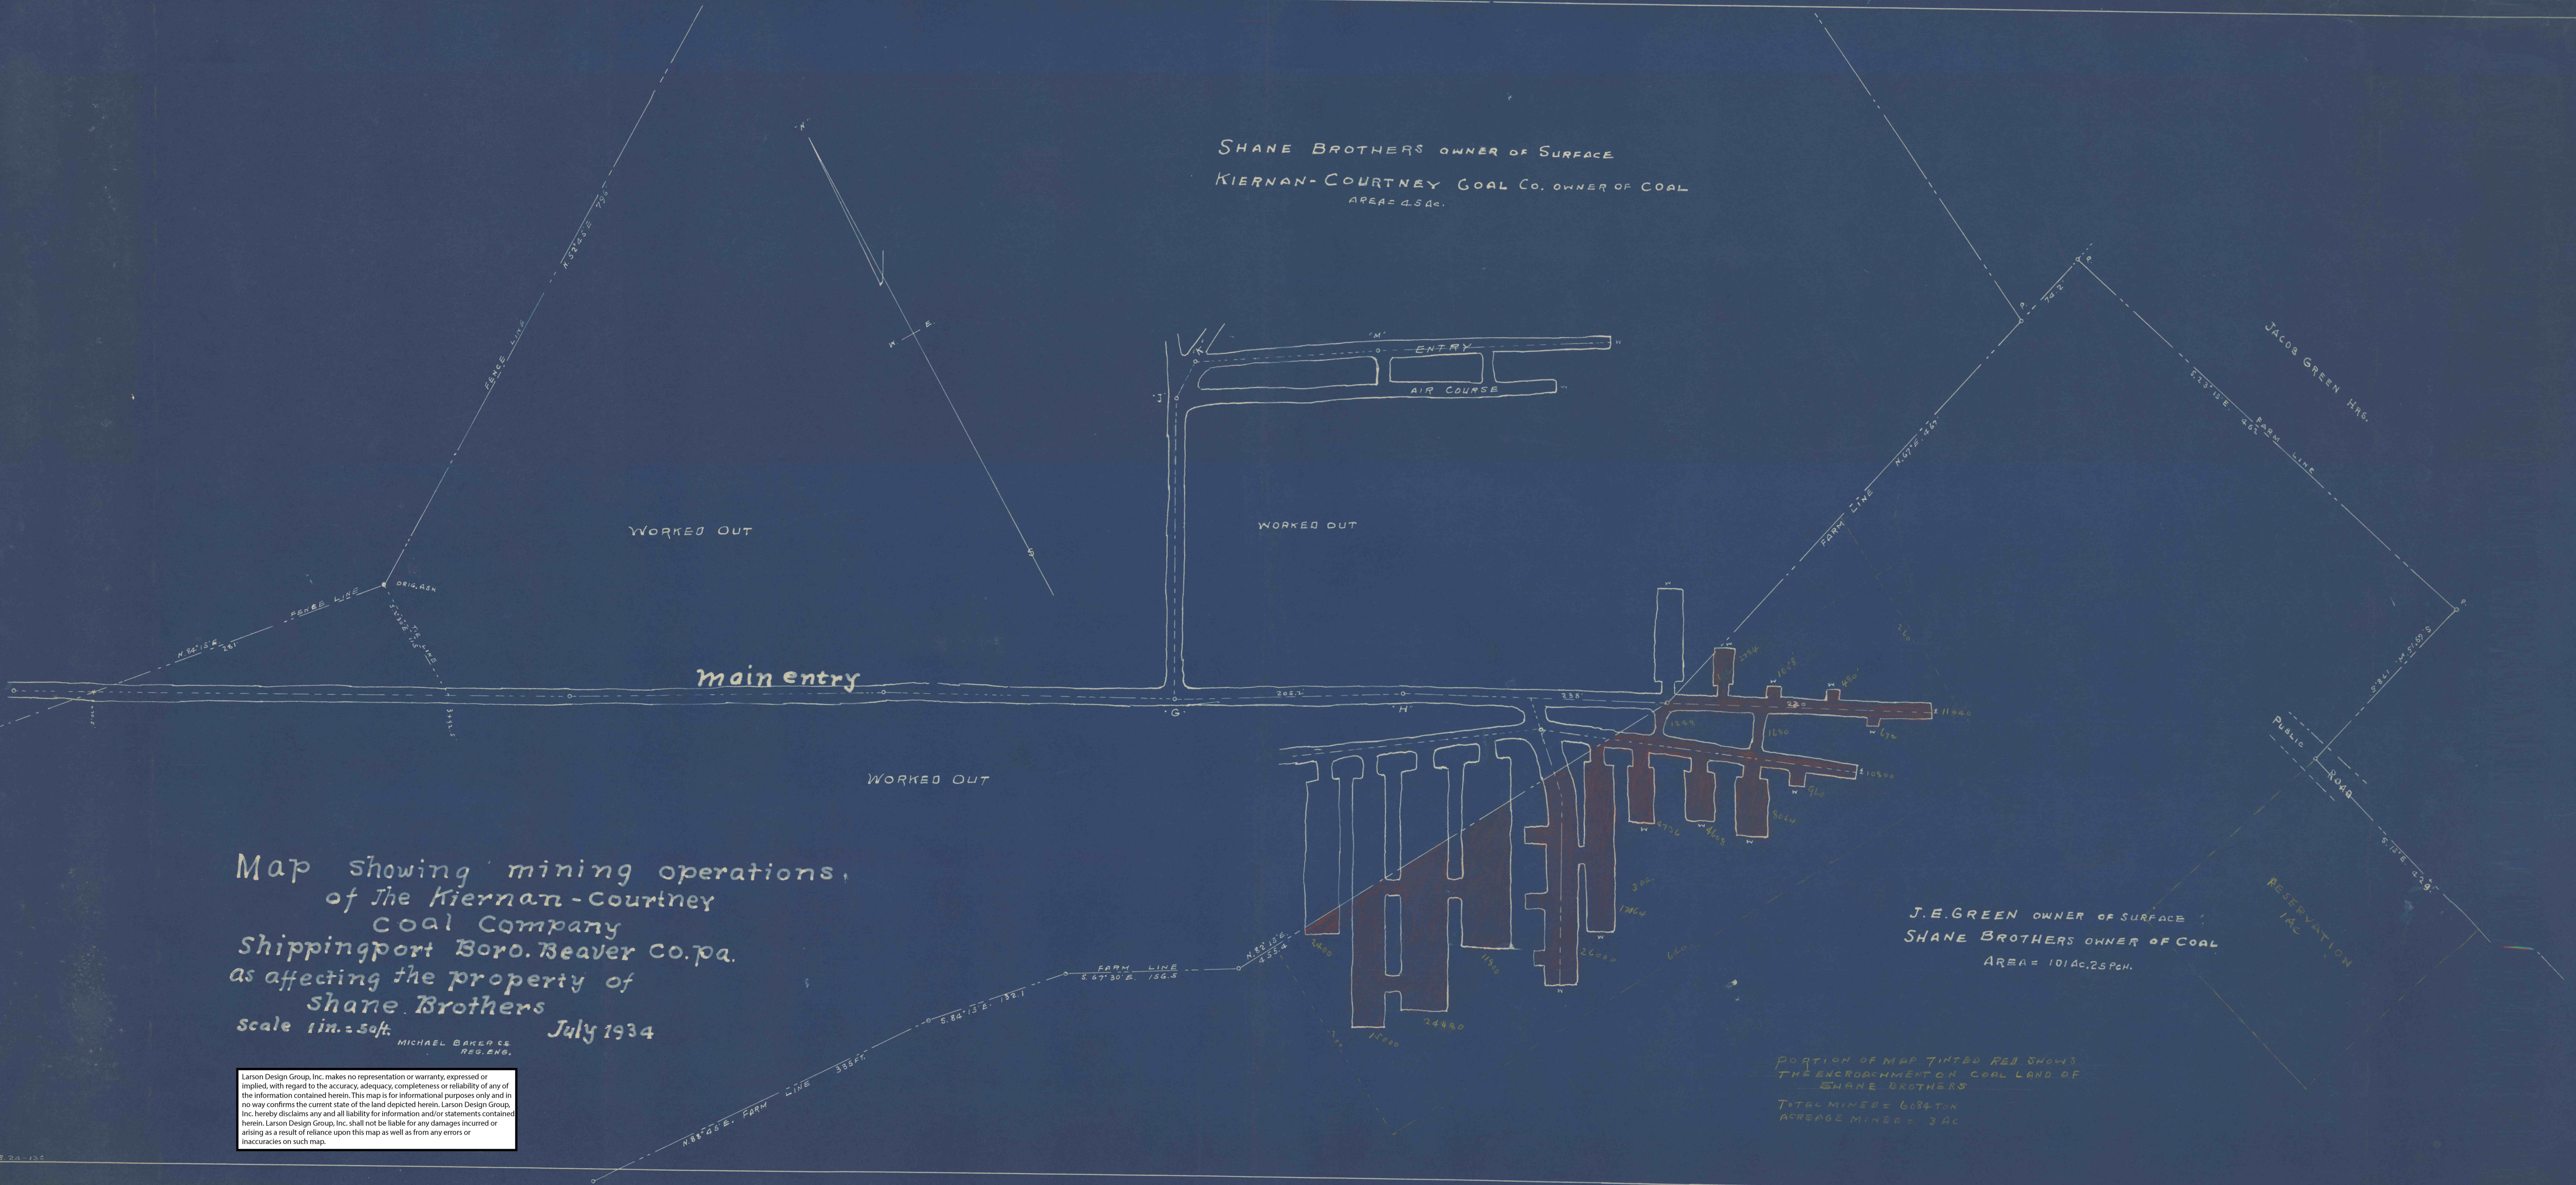

JACOB GREEN H&G
 FARM LINE
 S. 23° 15' E. 452'

J.E. GREEN OWNER OF SURFACE
 SHANE BROTHERS OWNER OF COAL
 AREA = 101 AC. 25 Pch.

PORTION OF MAP TINTED RED SHOWS
 THE ENCROACHMENT ON COAL LAND OF
 SHANE BROTHERS
 TOTAL MINED = 6084 TON
 ACREAGE MINED = 3 AC.

Map showing mining operations,
 of The Kiernan-Courtney
 Coal Company
 Shippingport Boro. Beaver Co. Pa.
 as affecting the property of
 Shane Brothers
 Scale 1 in. = 50 ft. July 1934

MICHAEL BAKER & CO.
 REG. ENG.

Larson Design Group, Inc. makes no representation or warranty, expressed or implied, with regard to the accuracy, adequacy, completeness or reliability of any of the information contained herein. This map is for informational purposes only and in no way confirms the current state of the land depicted herein. Larson Design Group, Inc. hereby disclaims any and all liability for information and/or statements contained herein. Larson Design Group, Inc. shall not be liable for any damages incurred or arising as a result of reliance upon this map as well as from any errors or inaccuracies on such map.