

William Herr

Charles Pflugh

S. 86° 15' E. 963'

Post

103.6'

Iron Pin

John Peterson

N. 2° 20' E. 668'


This section worked out.

Charles Pflugh

567.5'

S. 3° 15' E. 1241'

T. W. Grzelka

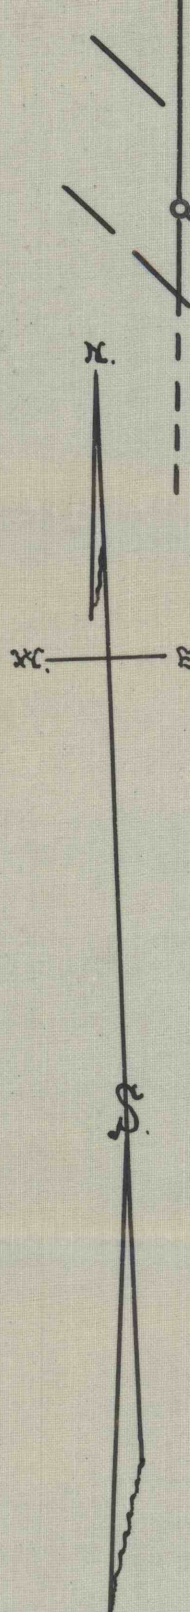

Pit Mouth

Pit Mouth



Road

Mine Map

of the

William Gillen Coal Mine

Situate in

North Sewickley Twp. Beaver County Pa.

Scale: 1 in. = 50 Ft.

Michael Baker. Regd. Engr.

Sept. 16, 1932.

Beaver, Pa.

Larson Design Group, Inc. makes no representation or warranty, expressed or implied, with regard to the accuracy, adequacy, completeness or reliability of any of the information contained herein. This map is for informational purposes only and in no way confirms the current state of the land depicted herein. Larson Design Group, Inc. hereby disclaims any and all liability for information and/or statements contained herein. Larson Design Group, Inc. shall not be liable for any damages incurred or arising as a result of reliance upon this map as well as from any errors or inaccuracies on such map.

N. B. 24-P. 108.

William Gillen Coal Mine
North Sewickley Twp.

William Gillen Coal Mine
North Sewickley Twp.