3499
-51

PLOT OF COAL MINE SURVEY IN BIG BEAVER TOWNSHIP
BEAVER COUNTY PA. MADE AT THE INSTANCE OF Wm SHANNON.

FIELD WORK BY M. BAKER.

1"=40'

HARRY T. BARKER, C.E.
No. 712 - 7TH AVE.
BEAVER FALLS. PA.

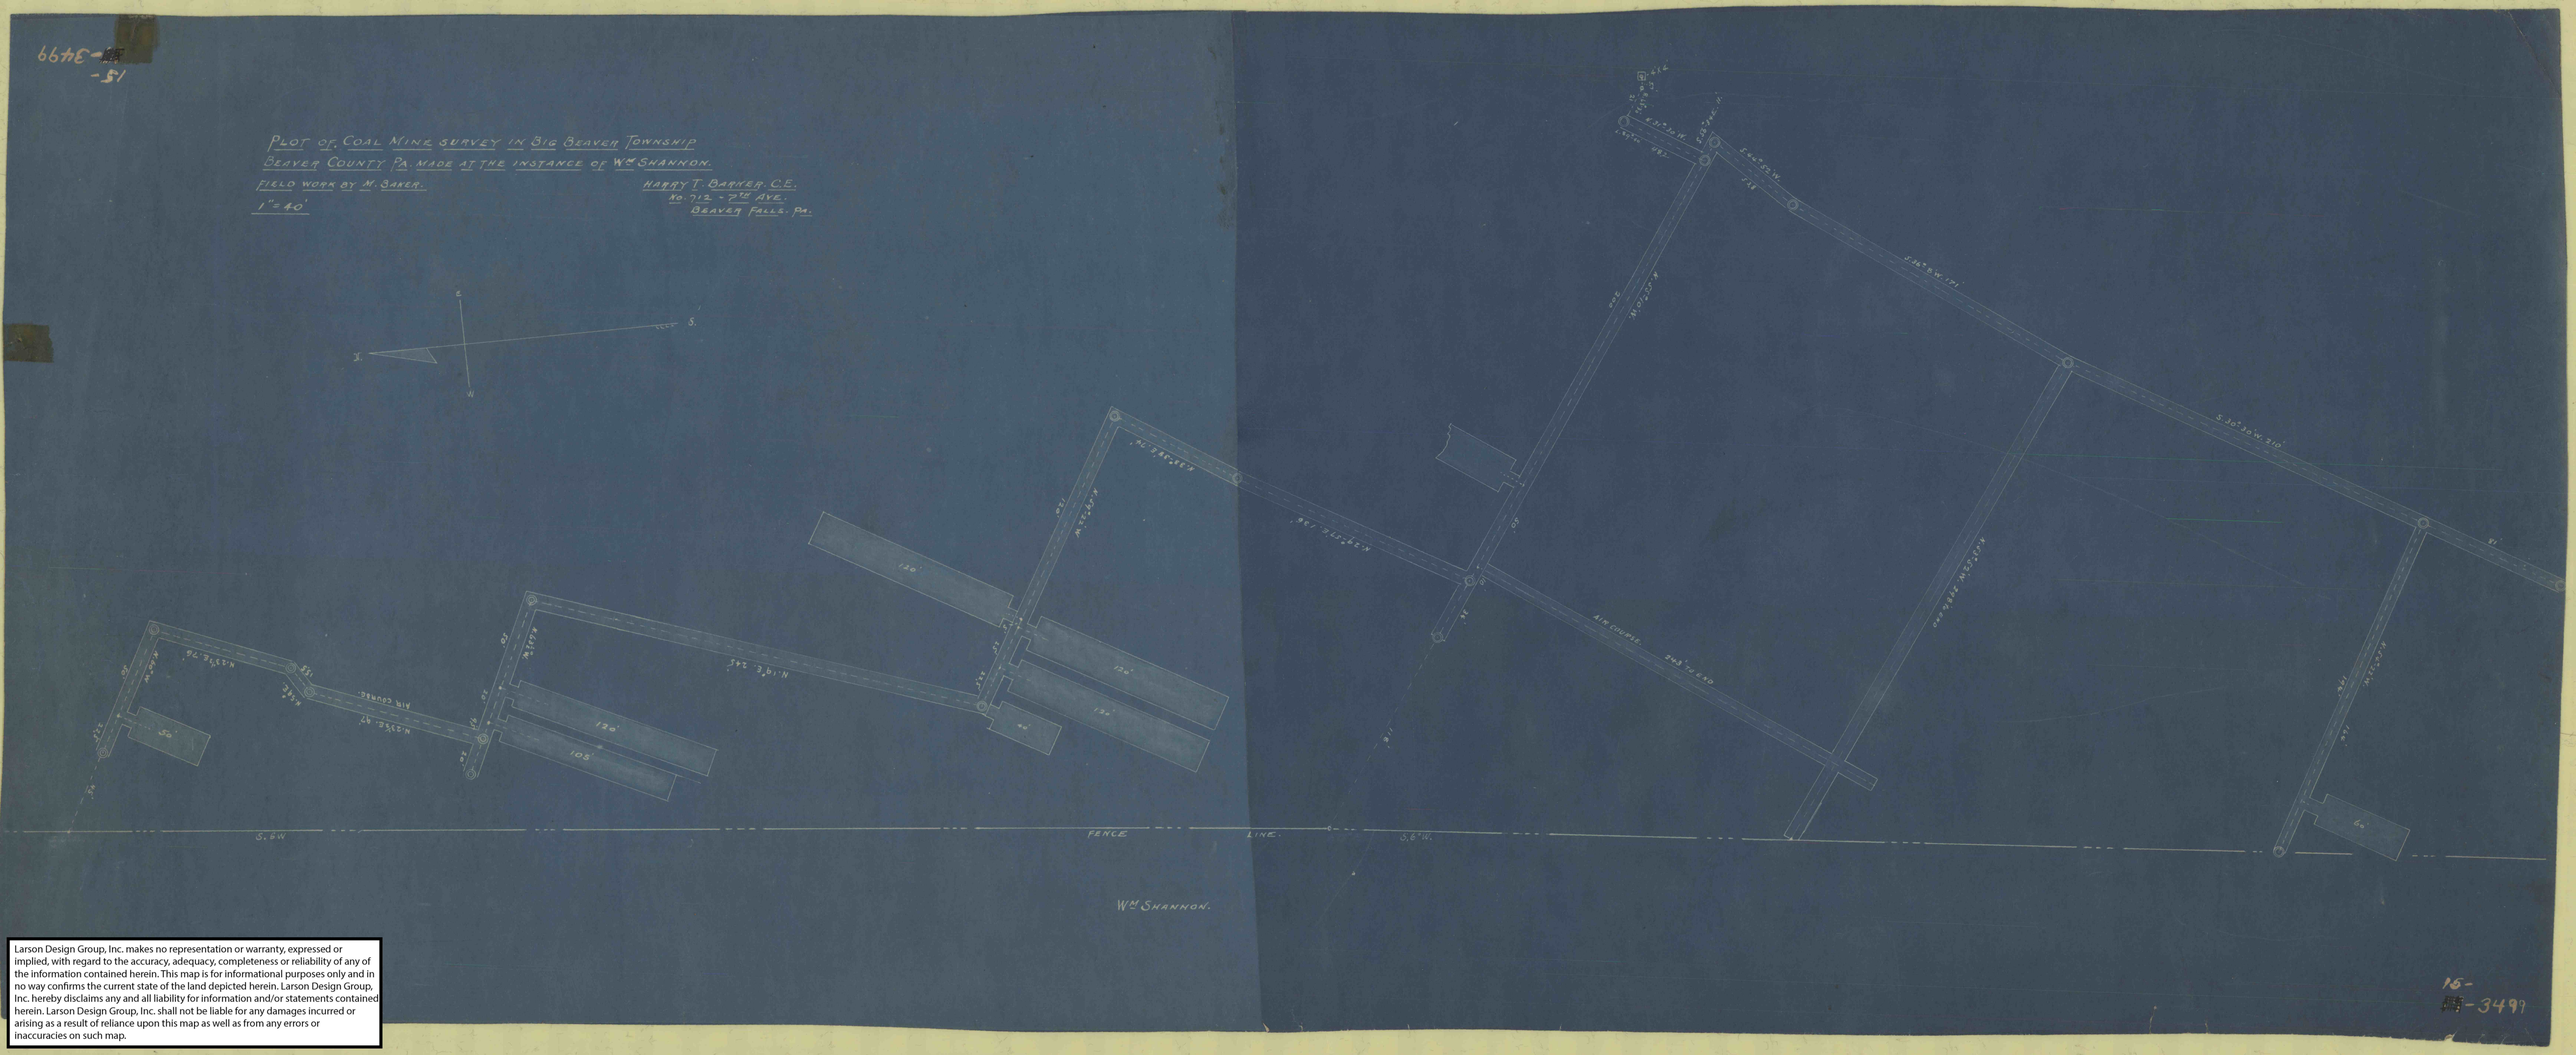
S.6W
FENCE
LINE.
S.6°W.
Wm SHANNON.
AIR COURSE.
120'
105'
50'
40'
S.30°30'W. 310'
S.36° E. 171'
N.37°E. 245'
