

Now or Formerly
 NICHOLAS BELLAN
 D.B. VOL. 211-P-195 = 4.56 AC.

N/2 COUNTY OF BEAVER
 FORMERLY
 ALEX. T. ANDERSON
 D.B. VOL. 196-P-195 = 16 AC. & 135 PER ±

SURFACE
 WILLIAM H. AND SAMUEL SILVERMAN
 D.B. VOL. 448-P-133 = 81.57 ACRES

MINERALS = C.C.P. CO.

FORMERLY
 NICHOLAS BELLAN
 NOW


NOTE:
 ASSUMED AN ELEVATION OF 1000.00' ON BOTTOM OF
 CLAY AT PIT MOUTH OF C.C.P. CO. MINE

SURFACE & MINERALS = C.C.P. CO.

MINE MAP
COLONIAL CLAY PRODUCTS CO.
BRIDGEWATER BOROUGH AND BRIGHTON TWP.
BEAVER COUNTY, PA.

SCALE: 1 INCH = 40 FEET
 DANIEL C. BAKER COUNTY SURVEYOR

MARCH 4, 1952.
 BEAVER, PA.

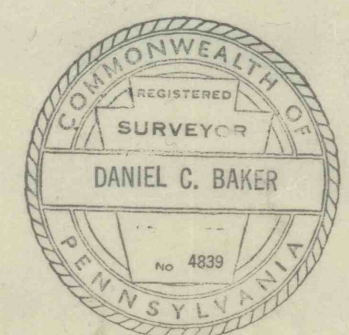

Larson Design Group, Inc. makes no representation or warranty, expressed or implied, with regard to the accuracy, adequacy, completeness or reliability of any of the information contained herein. This map is for informational purposes only and in no way confirms the current state of the land depicted herein. Larson Design Group, Inc. hereby disclaims any and all liability for information and/or statements contained herein. Larson Design Group, Inc. shall not be liable for any damages incurred or arising as a result of reliance upon this map as well as from any errors or inaccuracies on such map.