
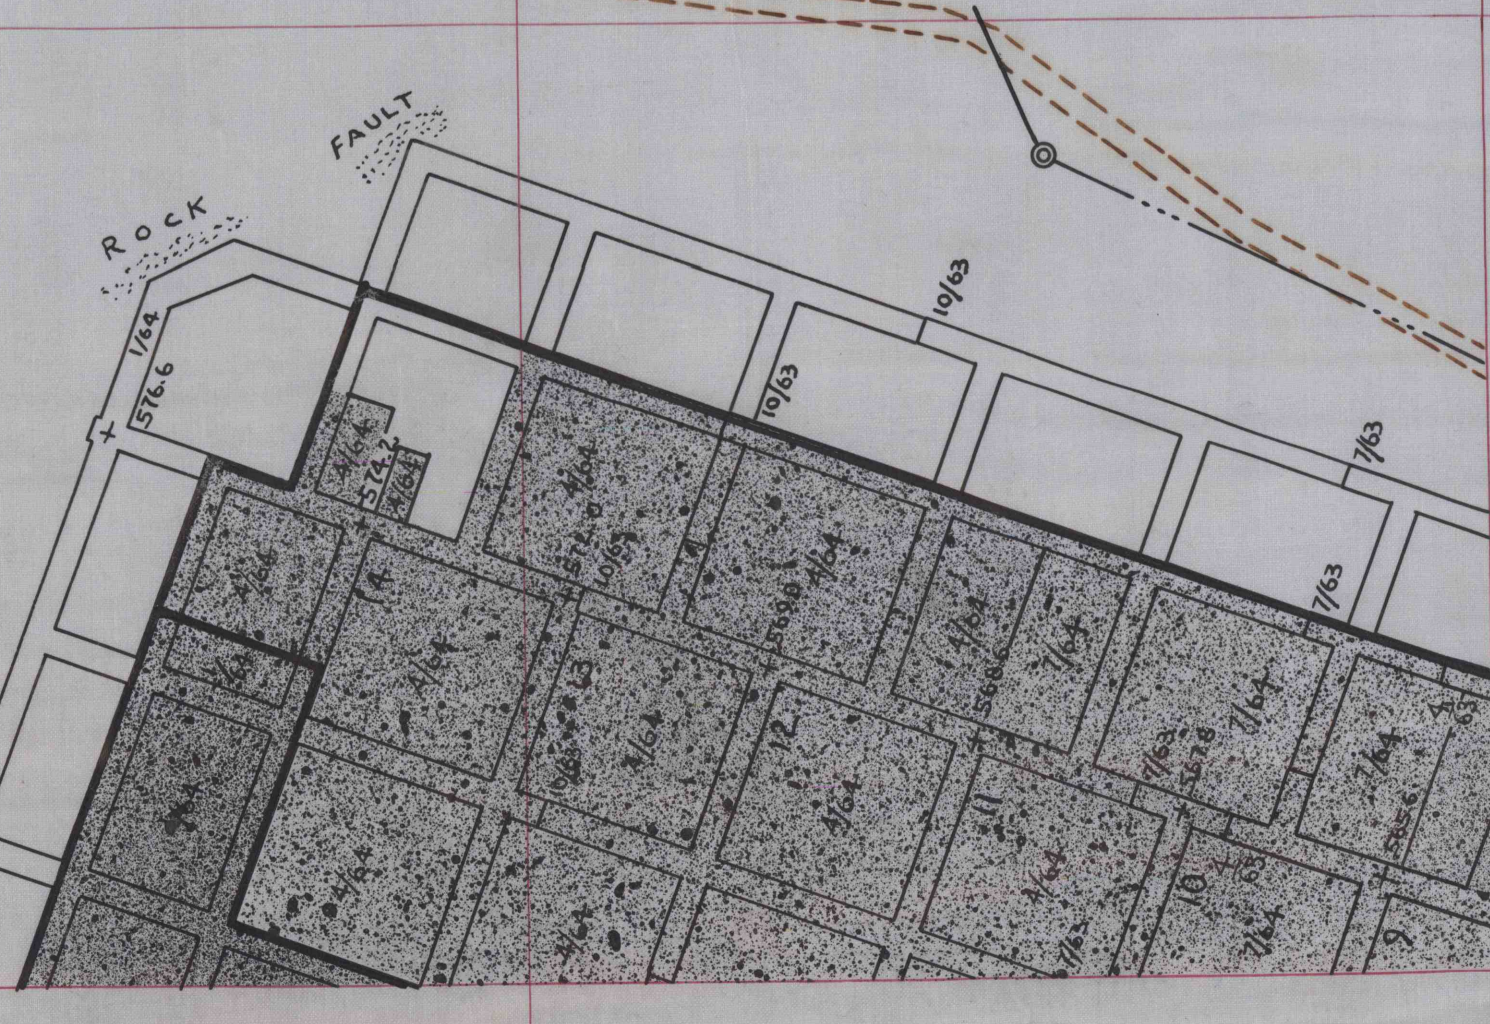


HILLMAN COAL & COKE COMPANY

WM. H. KNESTRICK

HENRY FATTMAN

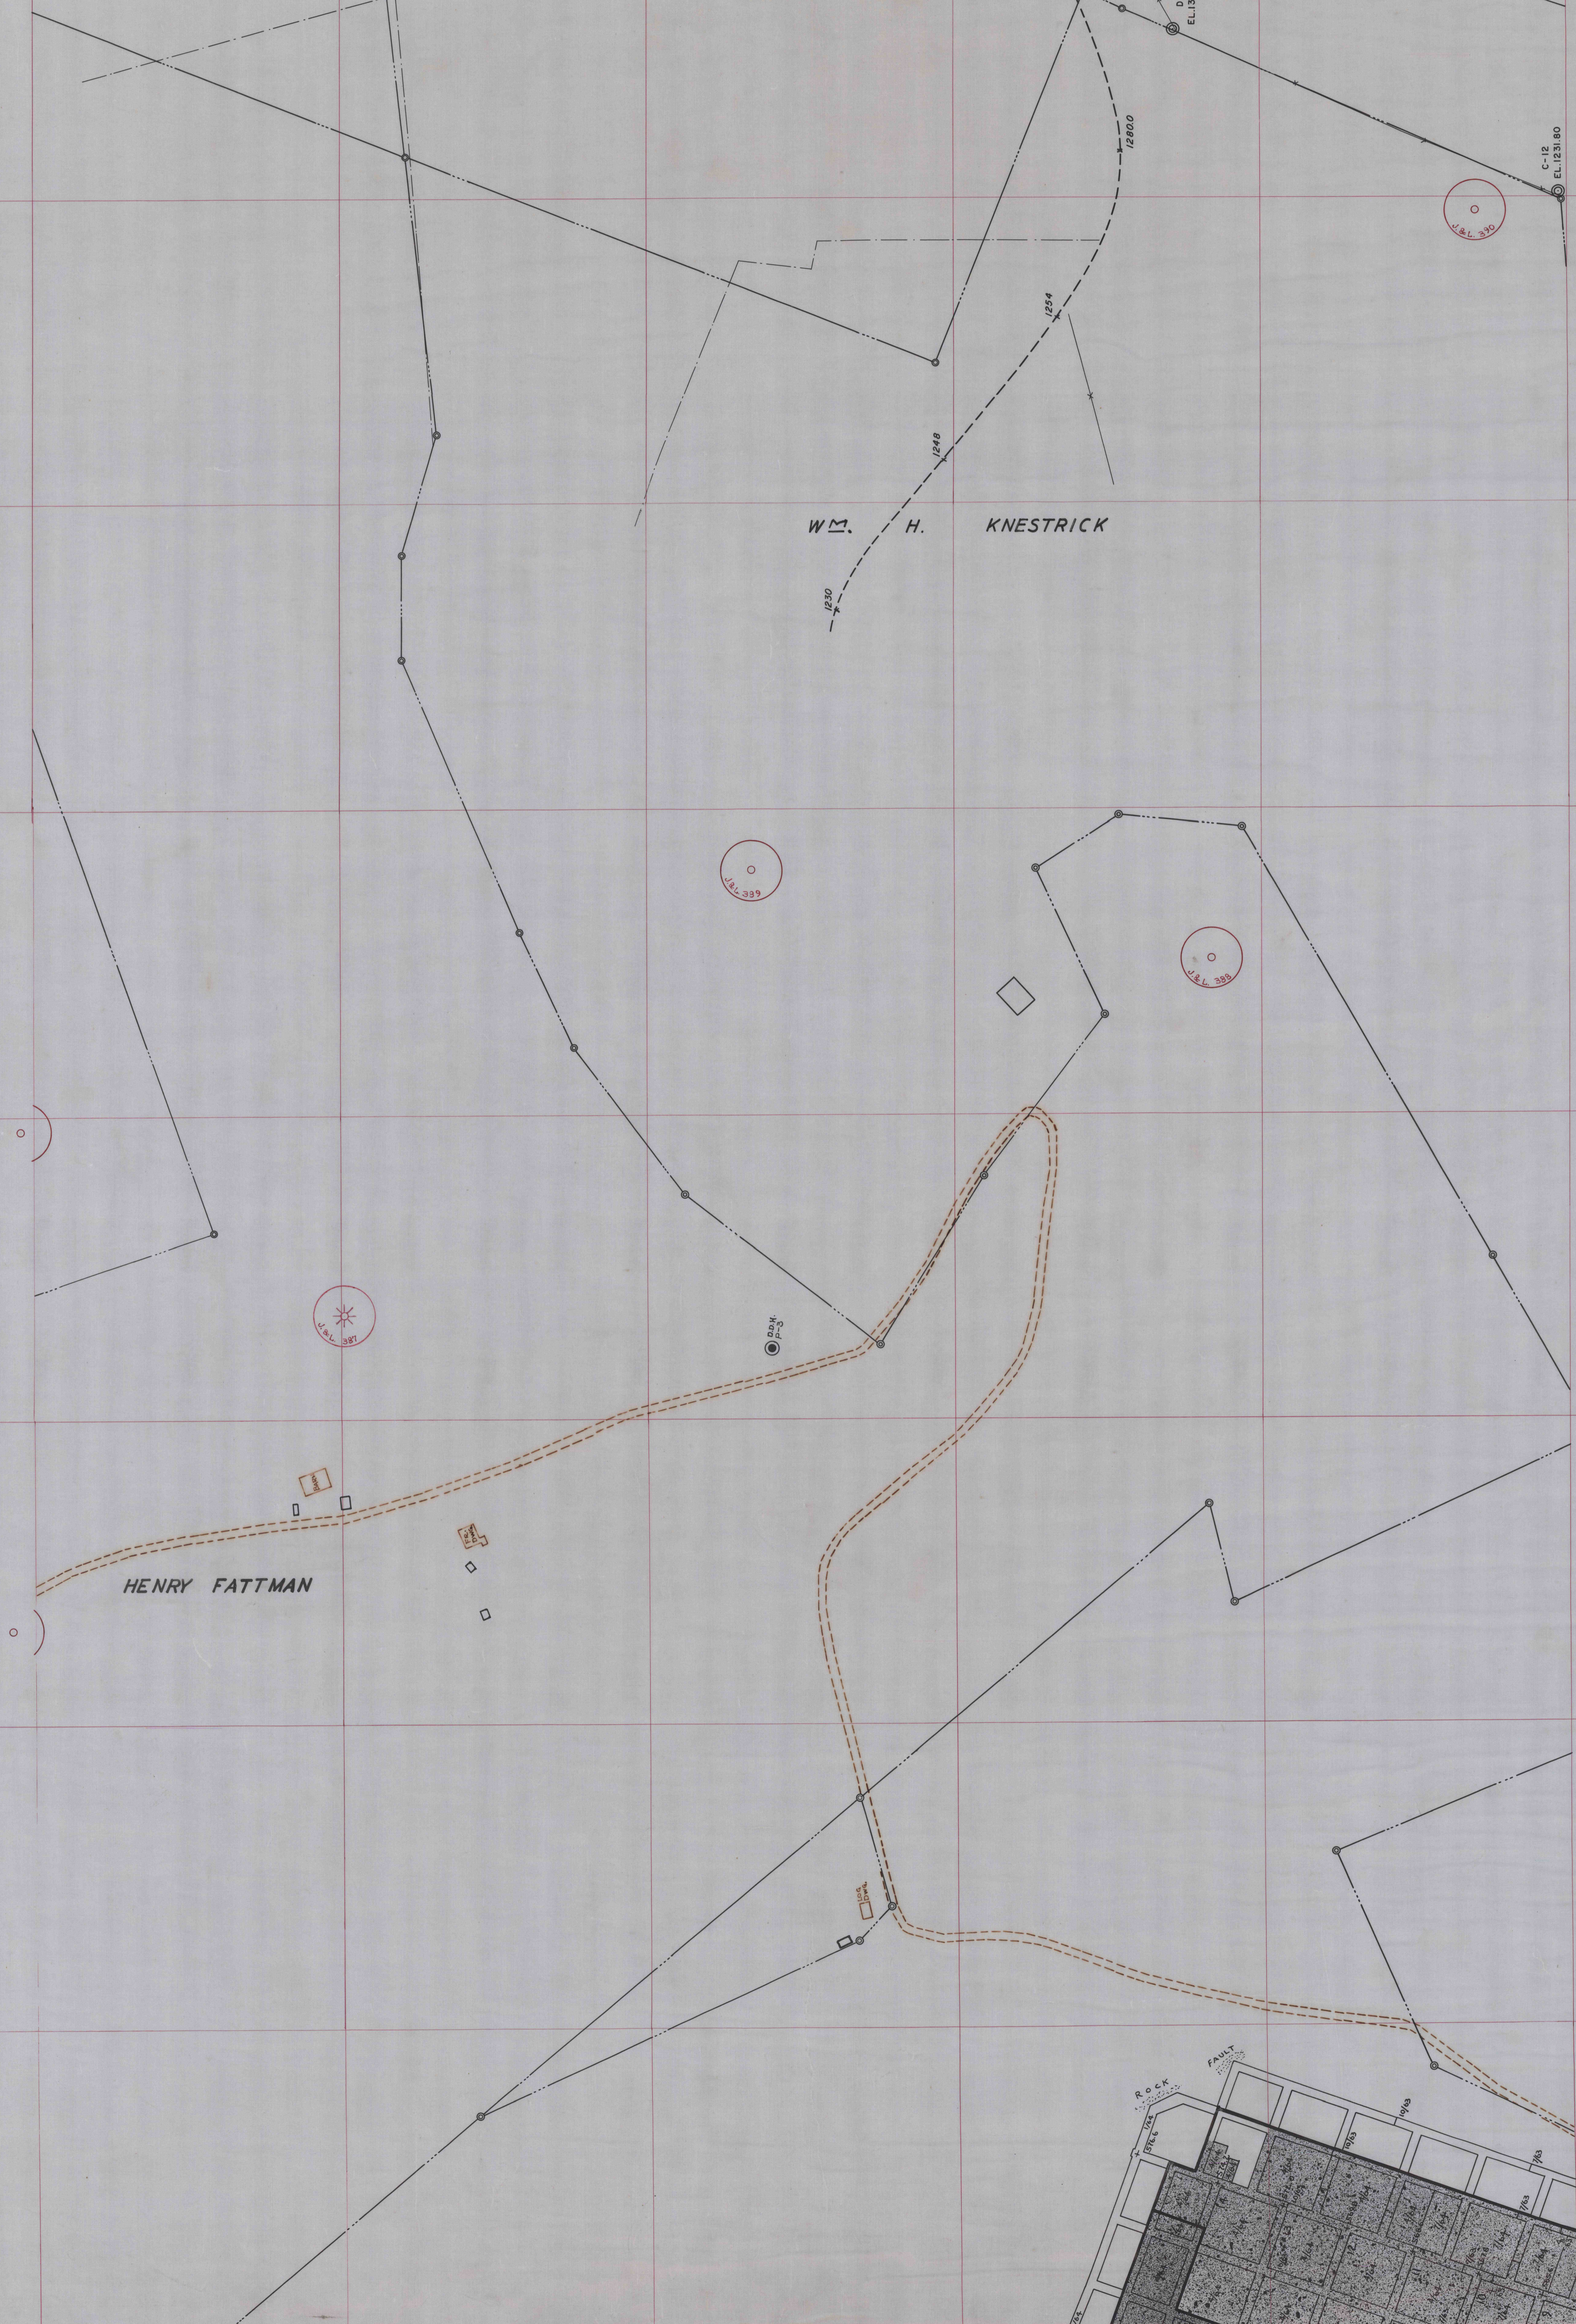

10 BEALS  
103

10 BEALS  
103