


1 Barrels 19

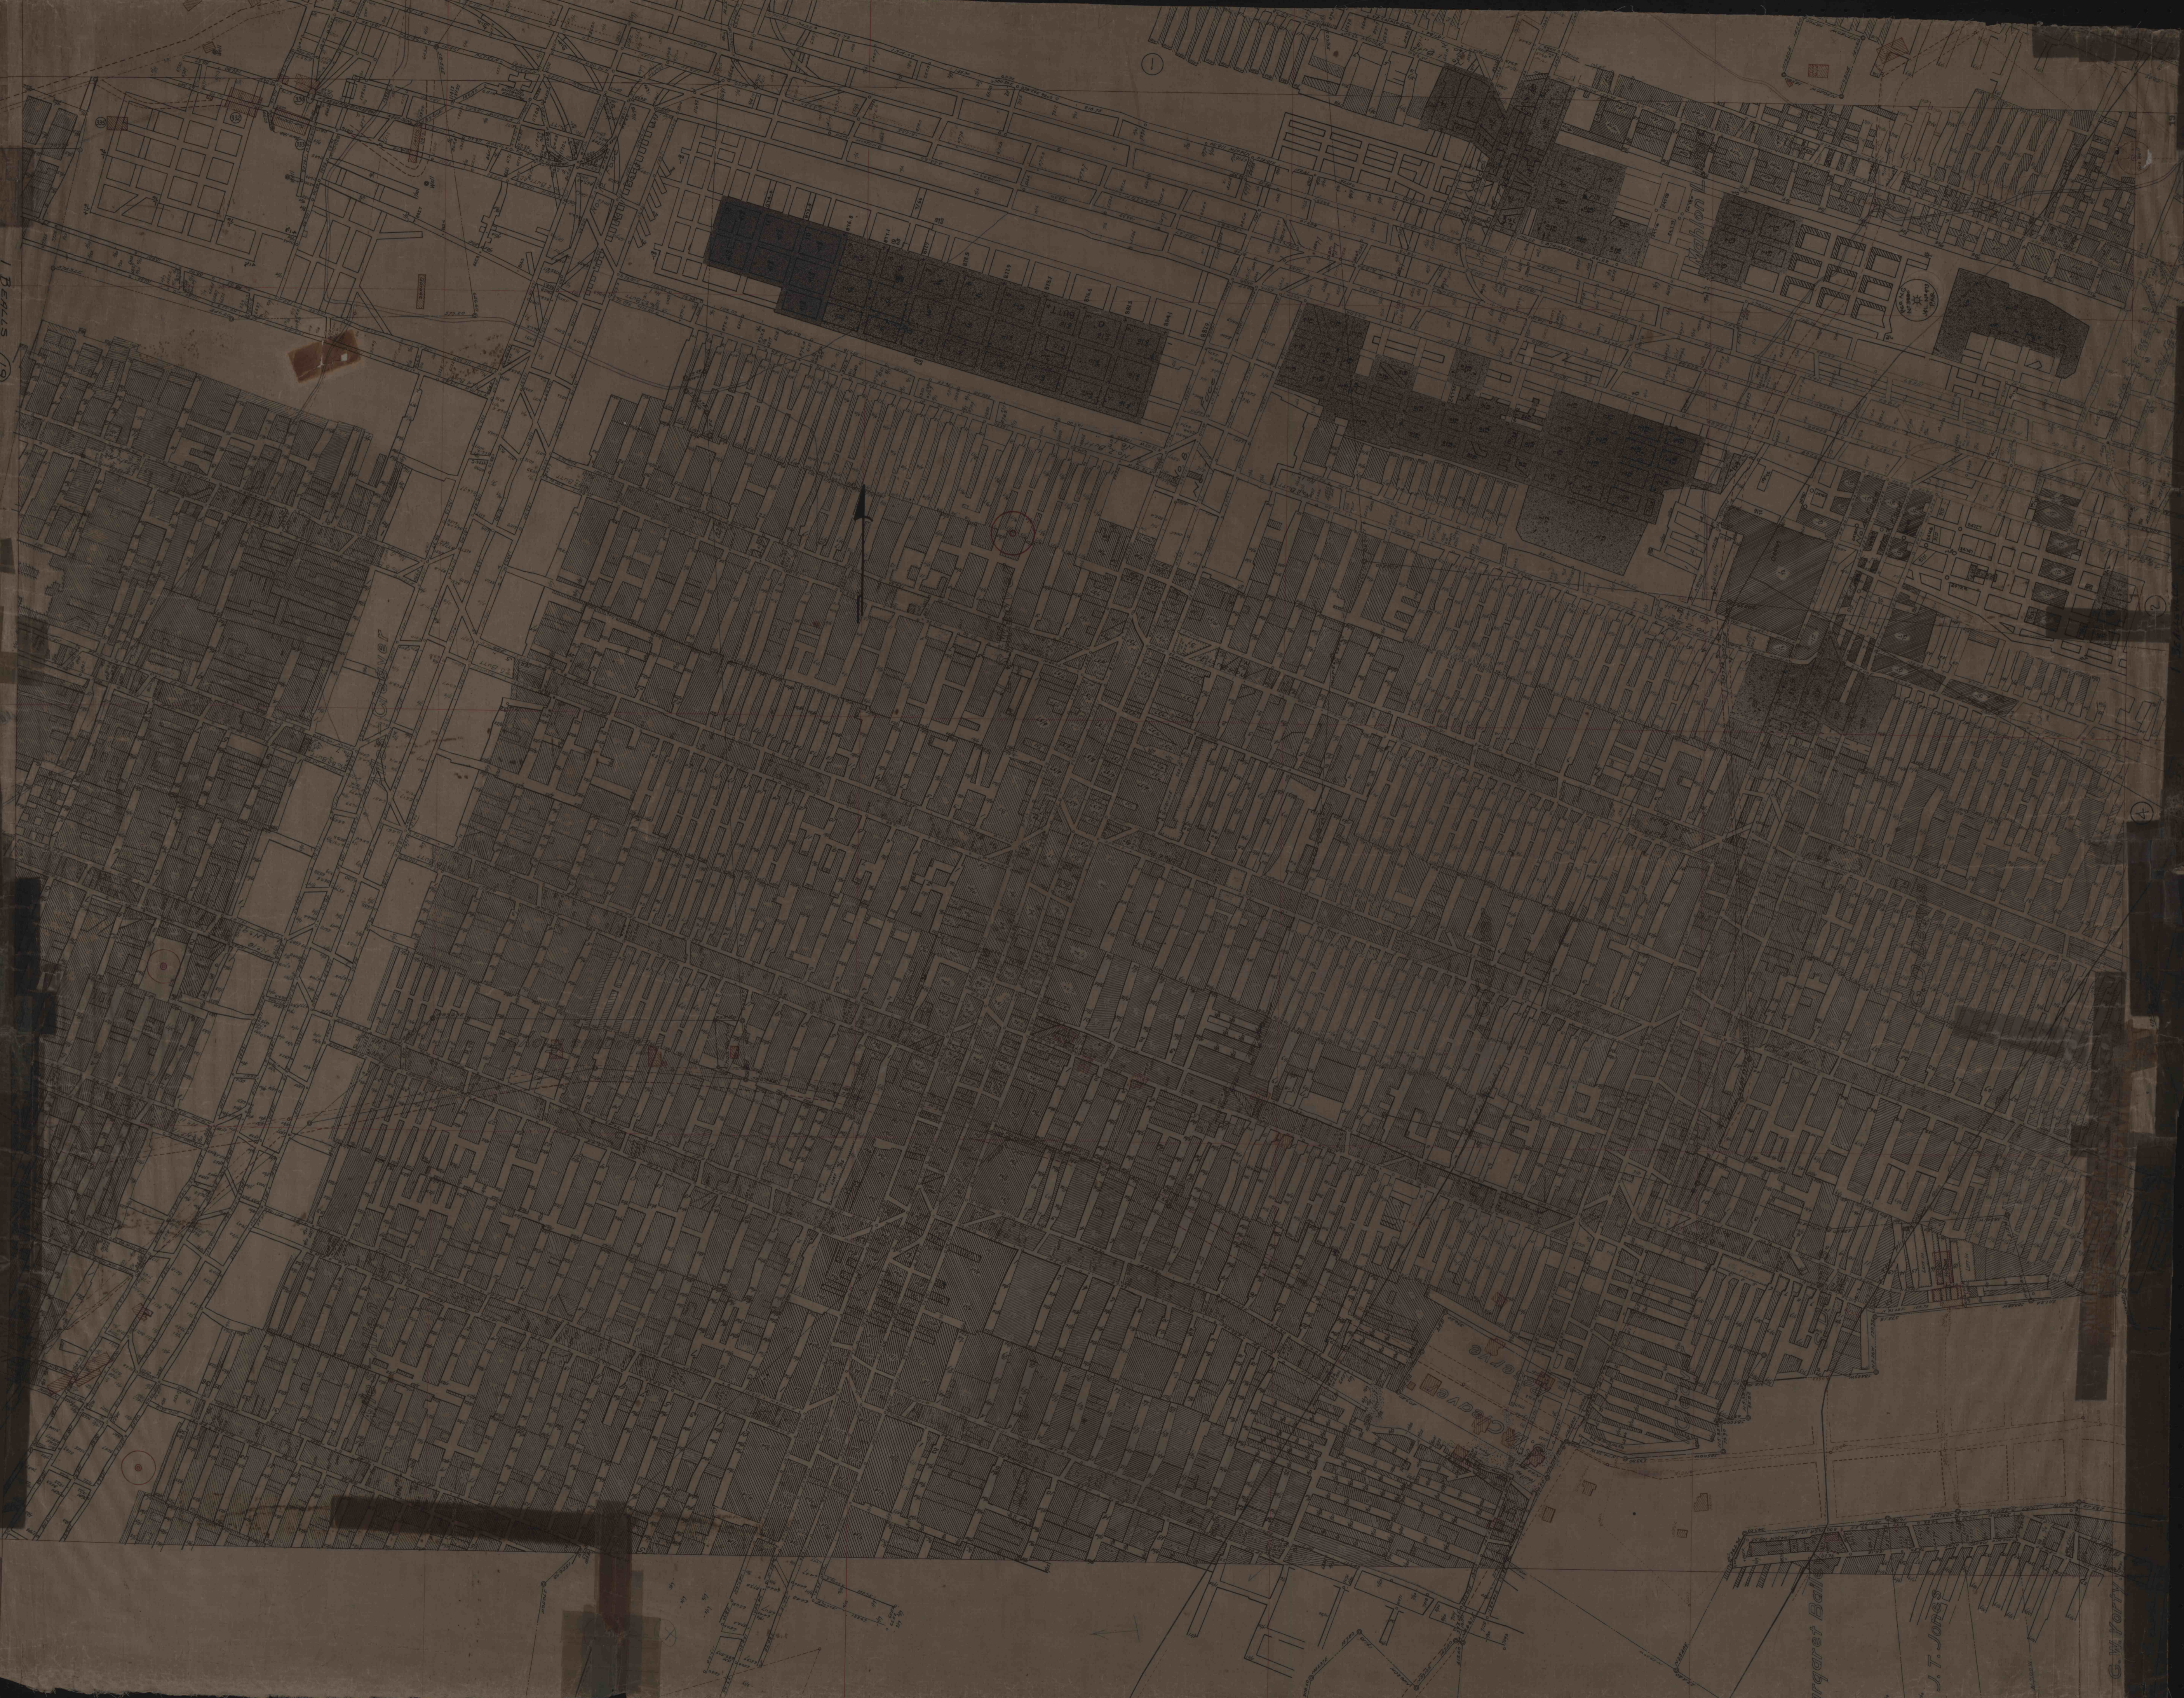

Market Ball

J. T. Jones

C. W. Perry