


Fit to 9

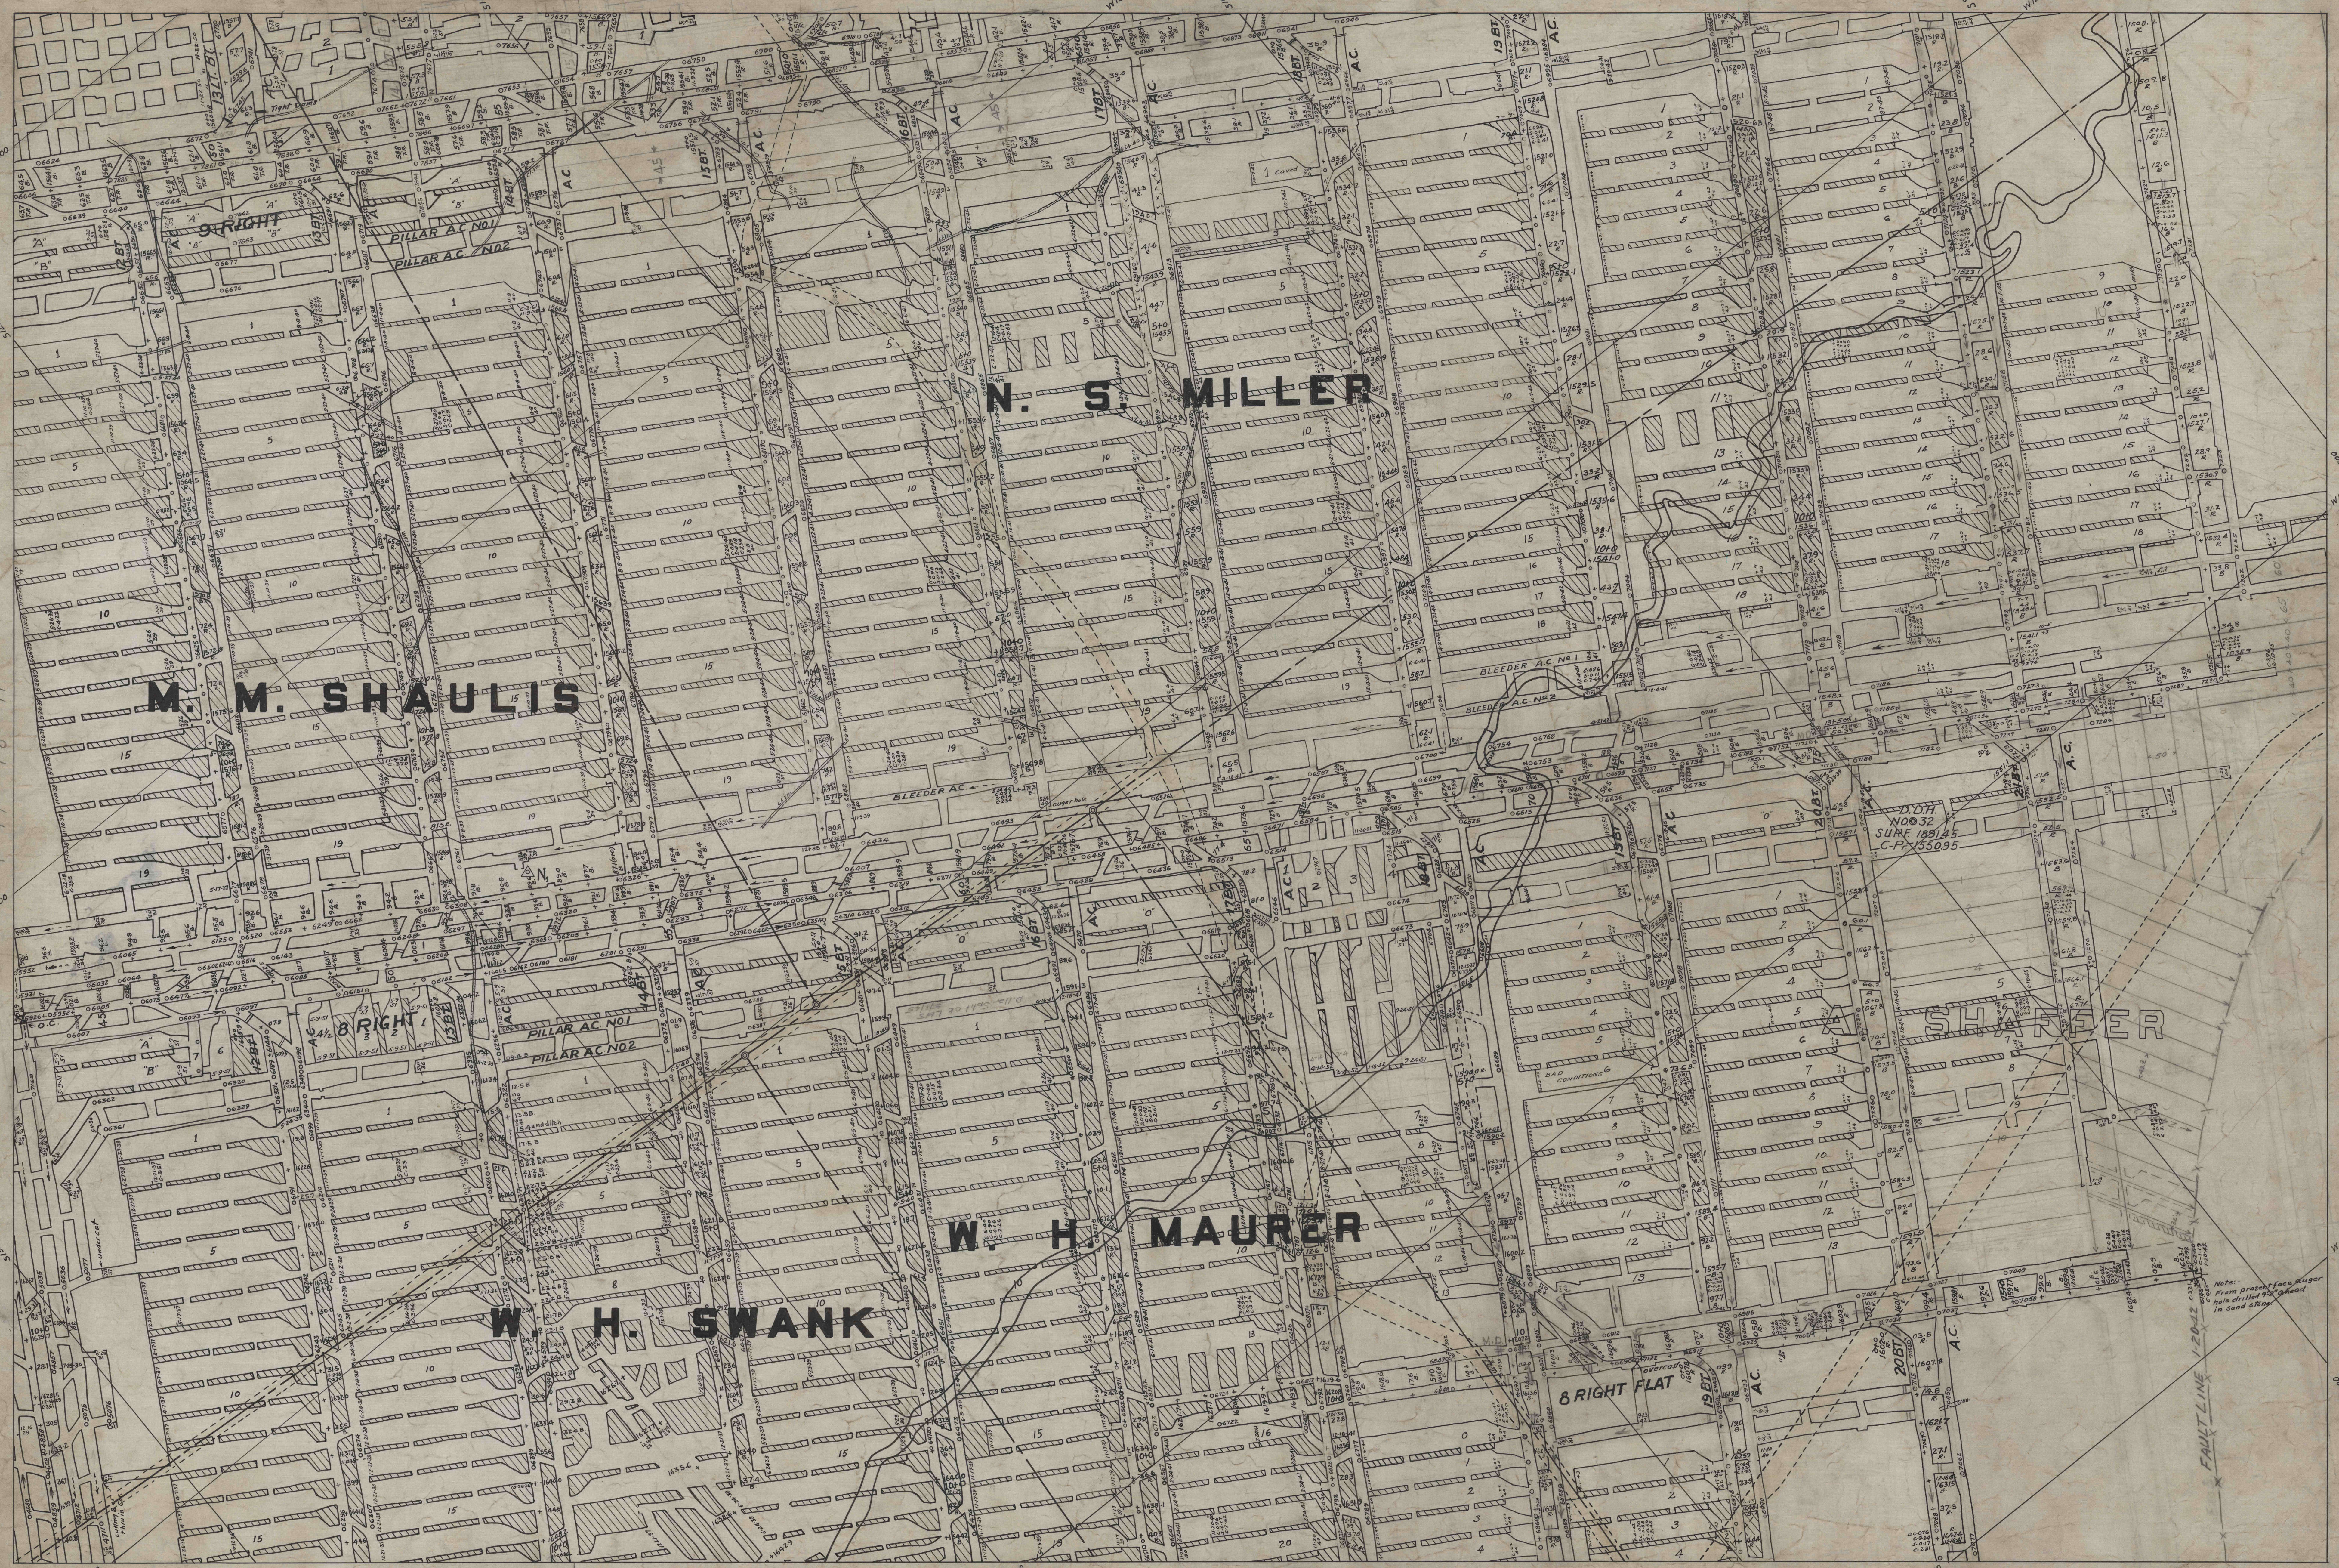

Fit to Mine #11 - 12

Fit to 15

MINE 120 "C" #12